STEVENS COAL CO.
CAMERON COLLIERY
SECTION No. 2 WEST
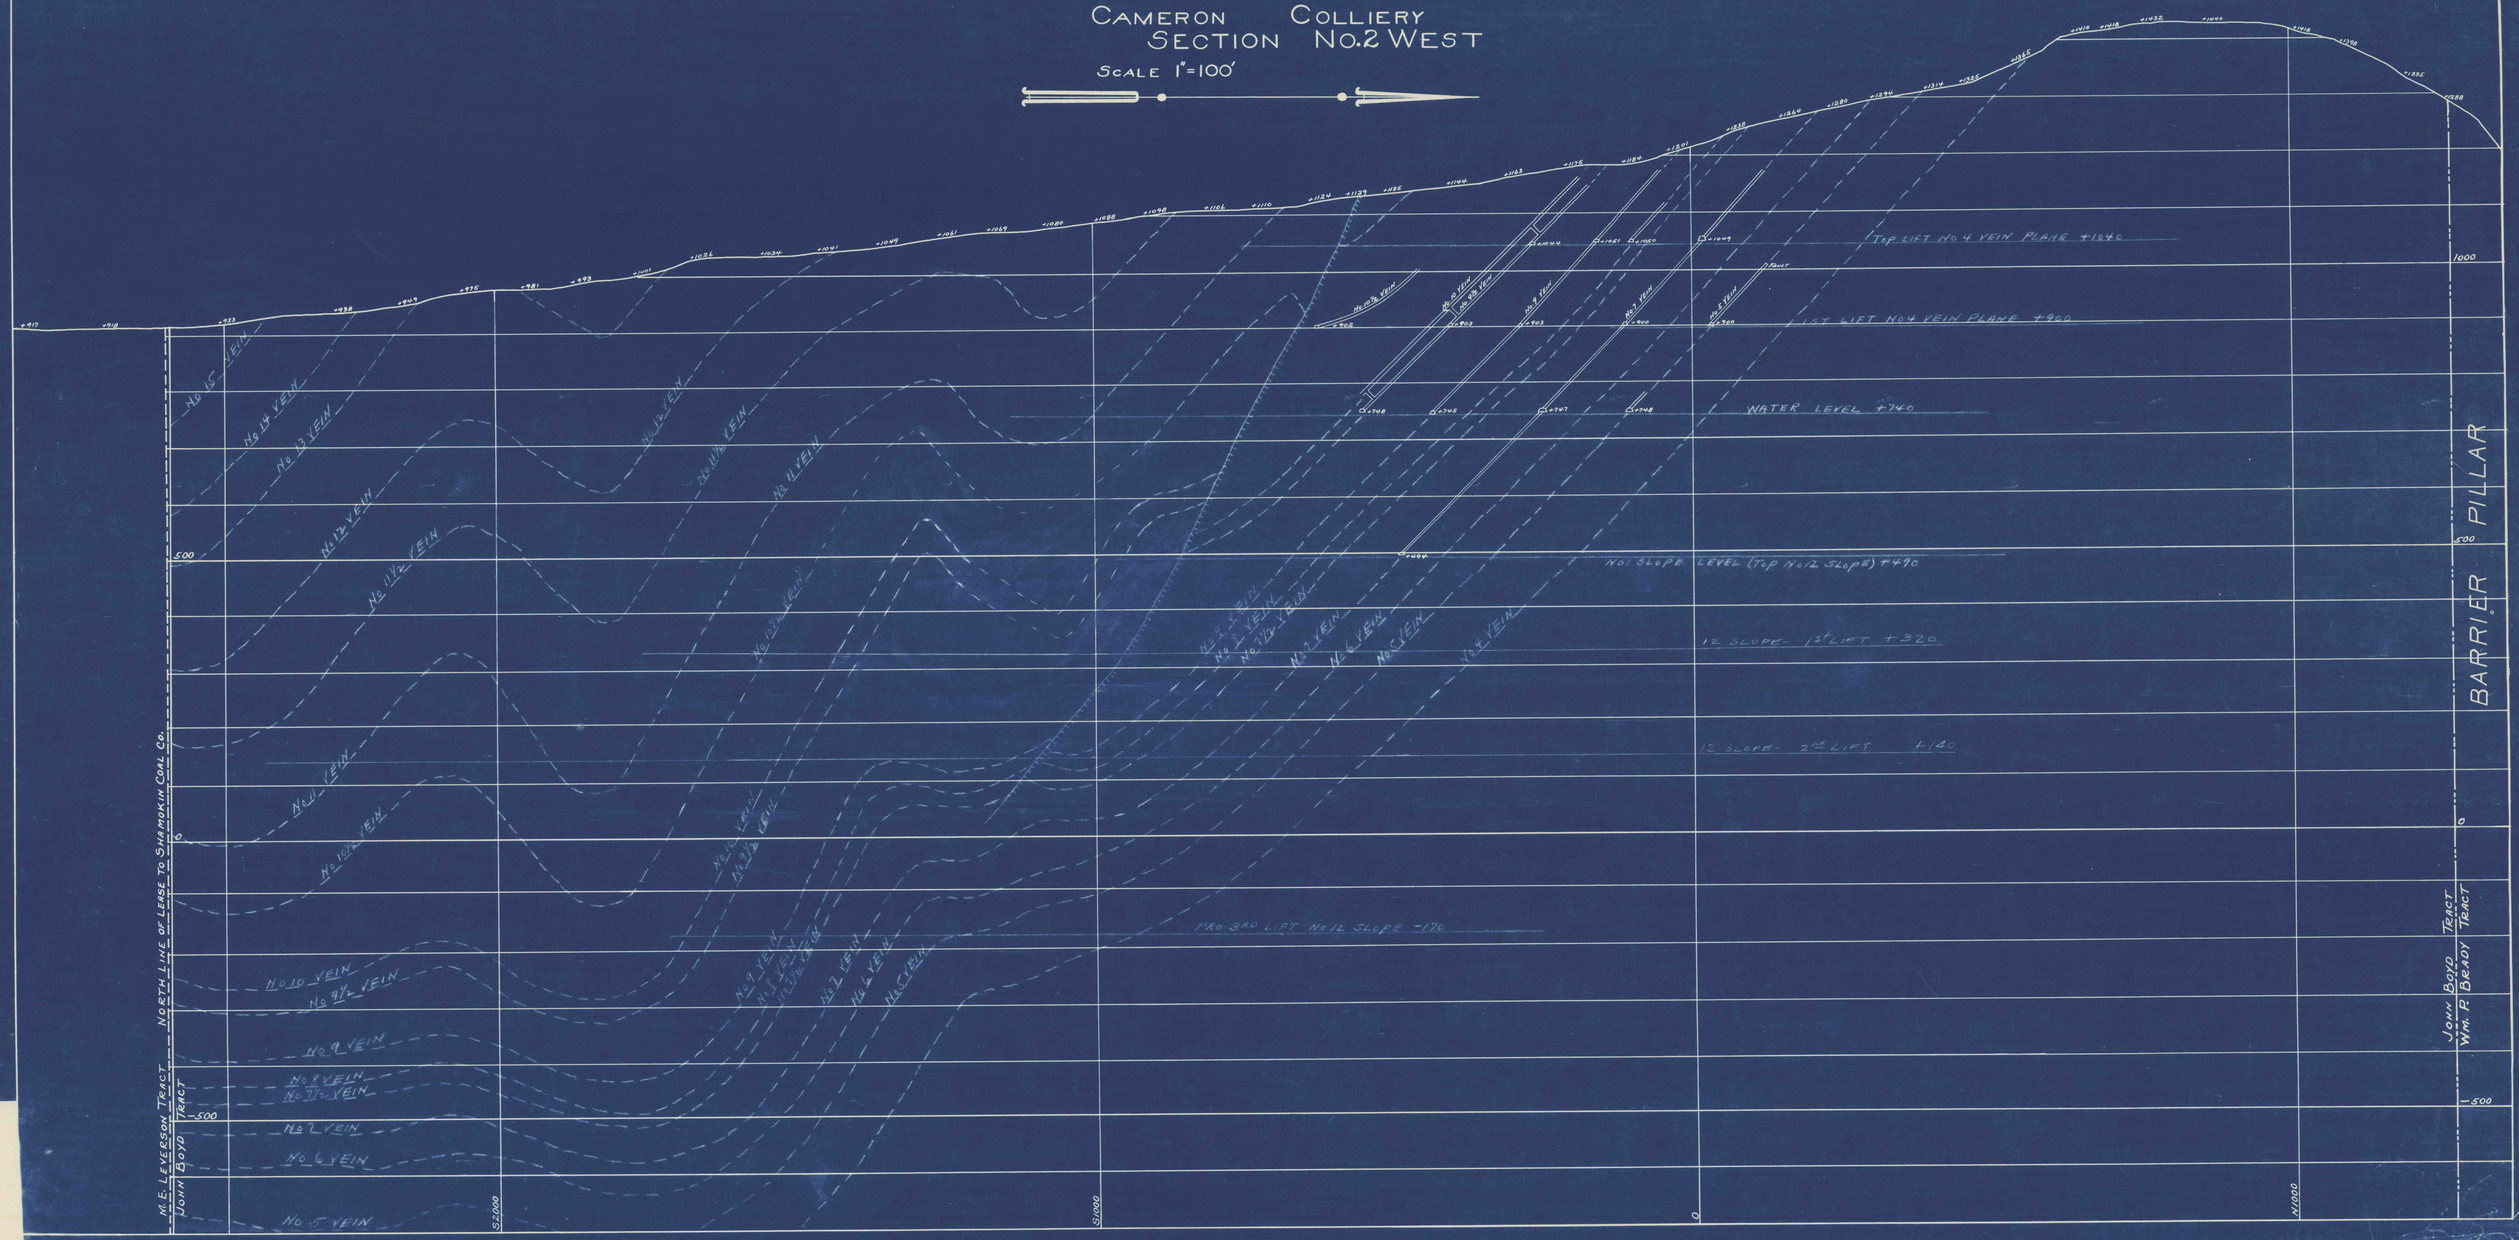
SCALE 1" = 100'