


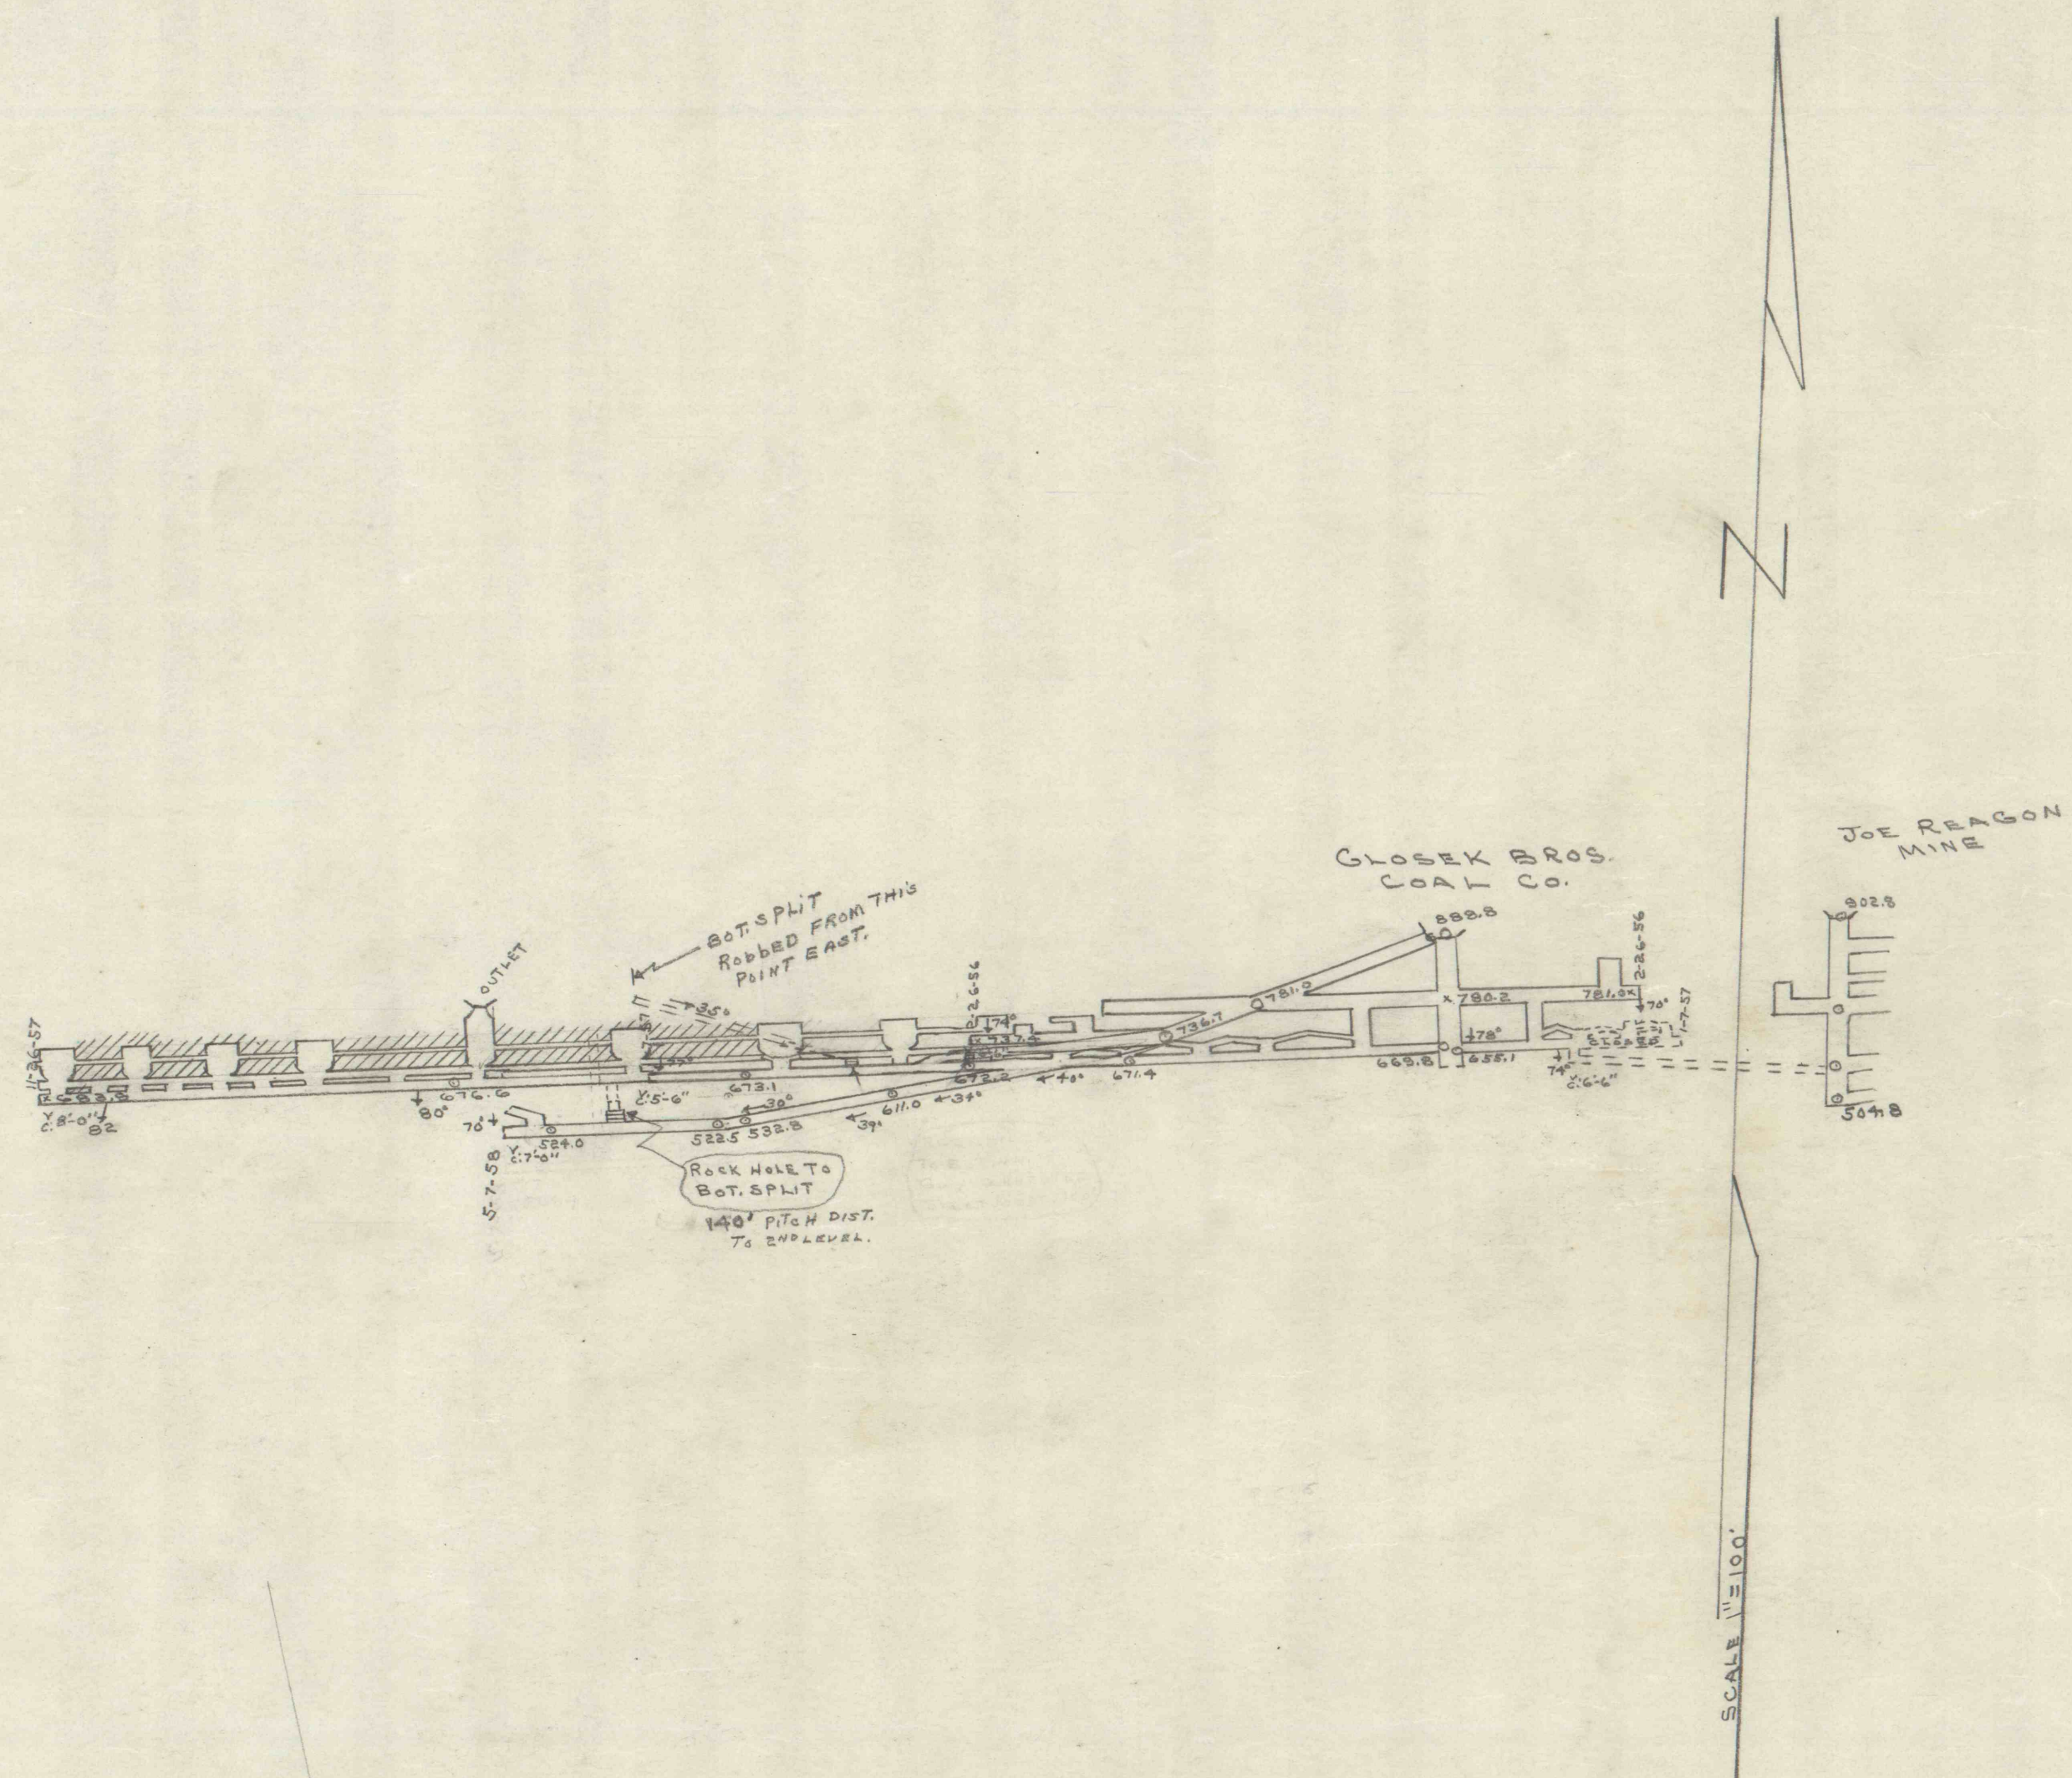

611.0
522.5
524.4