


315

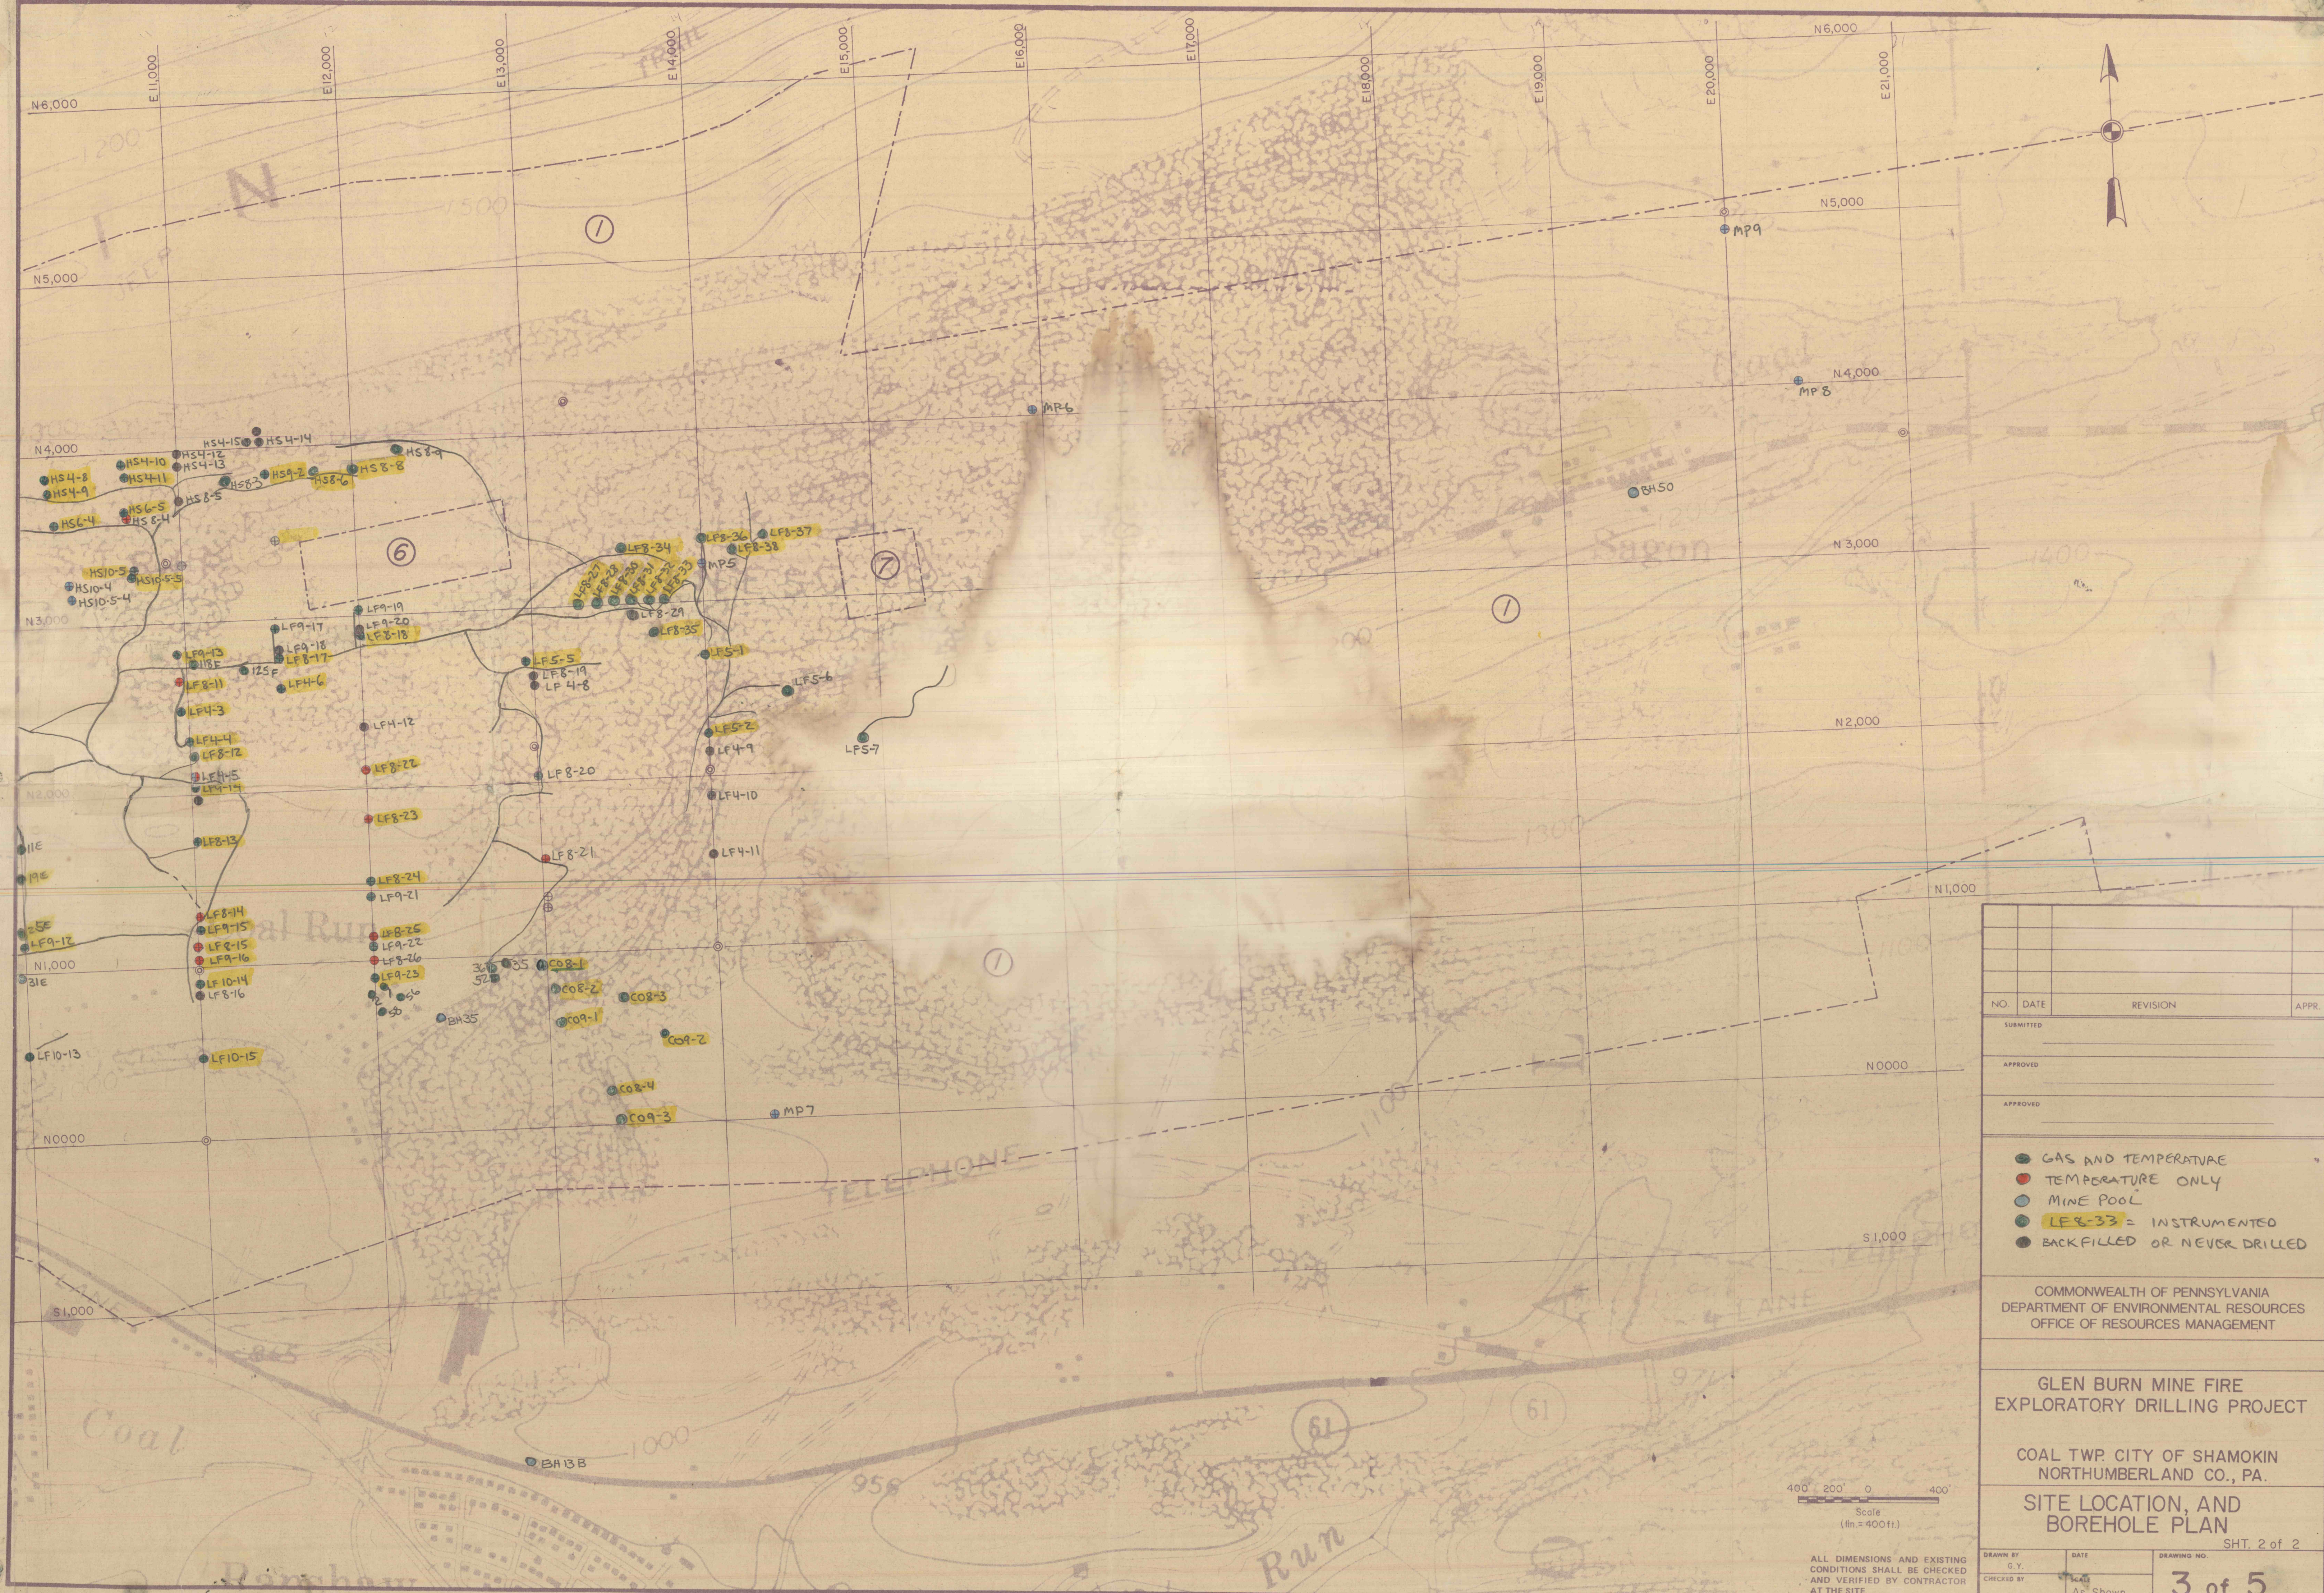

NO.	DATE	REVISION	APPR.

LEGEND

- GAS AND TEMPERATURE
- TEMPERATURE ONLY
- MINE POOL
- LF 8-33 = INSTRUMENTED
- BACKFILLED OR NEVER DRILLED

COMMONWEALTH OF PENNSYLVANIA
DEPARTMENT OF ENVIRONMENTAL RESOURCES
OFFICE OF RESOURCES MANAGEMENT

**GLEN BURN MINE FIRE
EXPLORATORY DRILLING PROJECT**

COAL TWP. CITY OF SHAMOKIN
NORTHUMBERLAND CO., PA.

**SITE LOCATION, AND
BOREHOLE PLAN**

SHT. 2 of 2

DRAWN BY G.Y.	DATE	DRAWING NO.
CHECKED BY	SCALE	3 of 5
As Shown		

ALL DIMENSIONS AND EXISTING
CONDITIONS SHALL BE CHECKED
AND VERIFIED BY CONTRACTOR
AT THE SITE.