

BARRIER BETWEEN ALASKA & INTERIOR

SPRINKLER

NORTH TO  
NORTH PT.  
SOUTH TAIL

CAD STRIPPING PIT

BRICK  
MASONRY  
MASONRY  
BRICK  
MASONRY  
BRICK  
CONCRETE  
MASONRY  
MASONRY

1000  
800  
600  
400  
200  
0





70  
80  
90  
100

10  
20  
30  
40  
50  
60  
70  
80  
90  
100

+

+

+

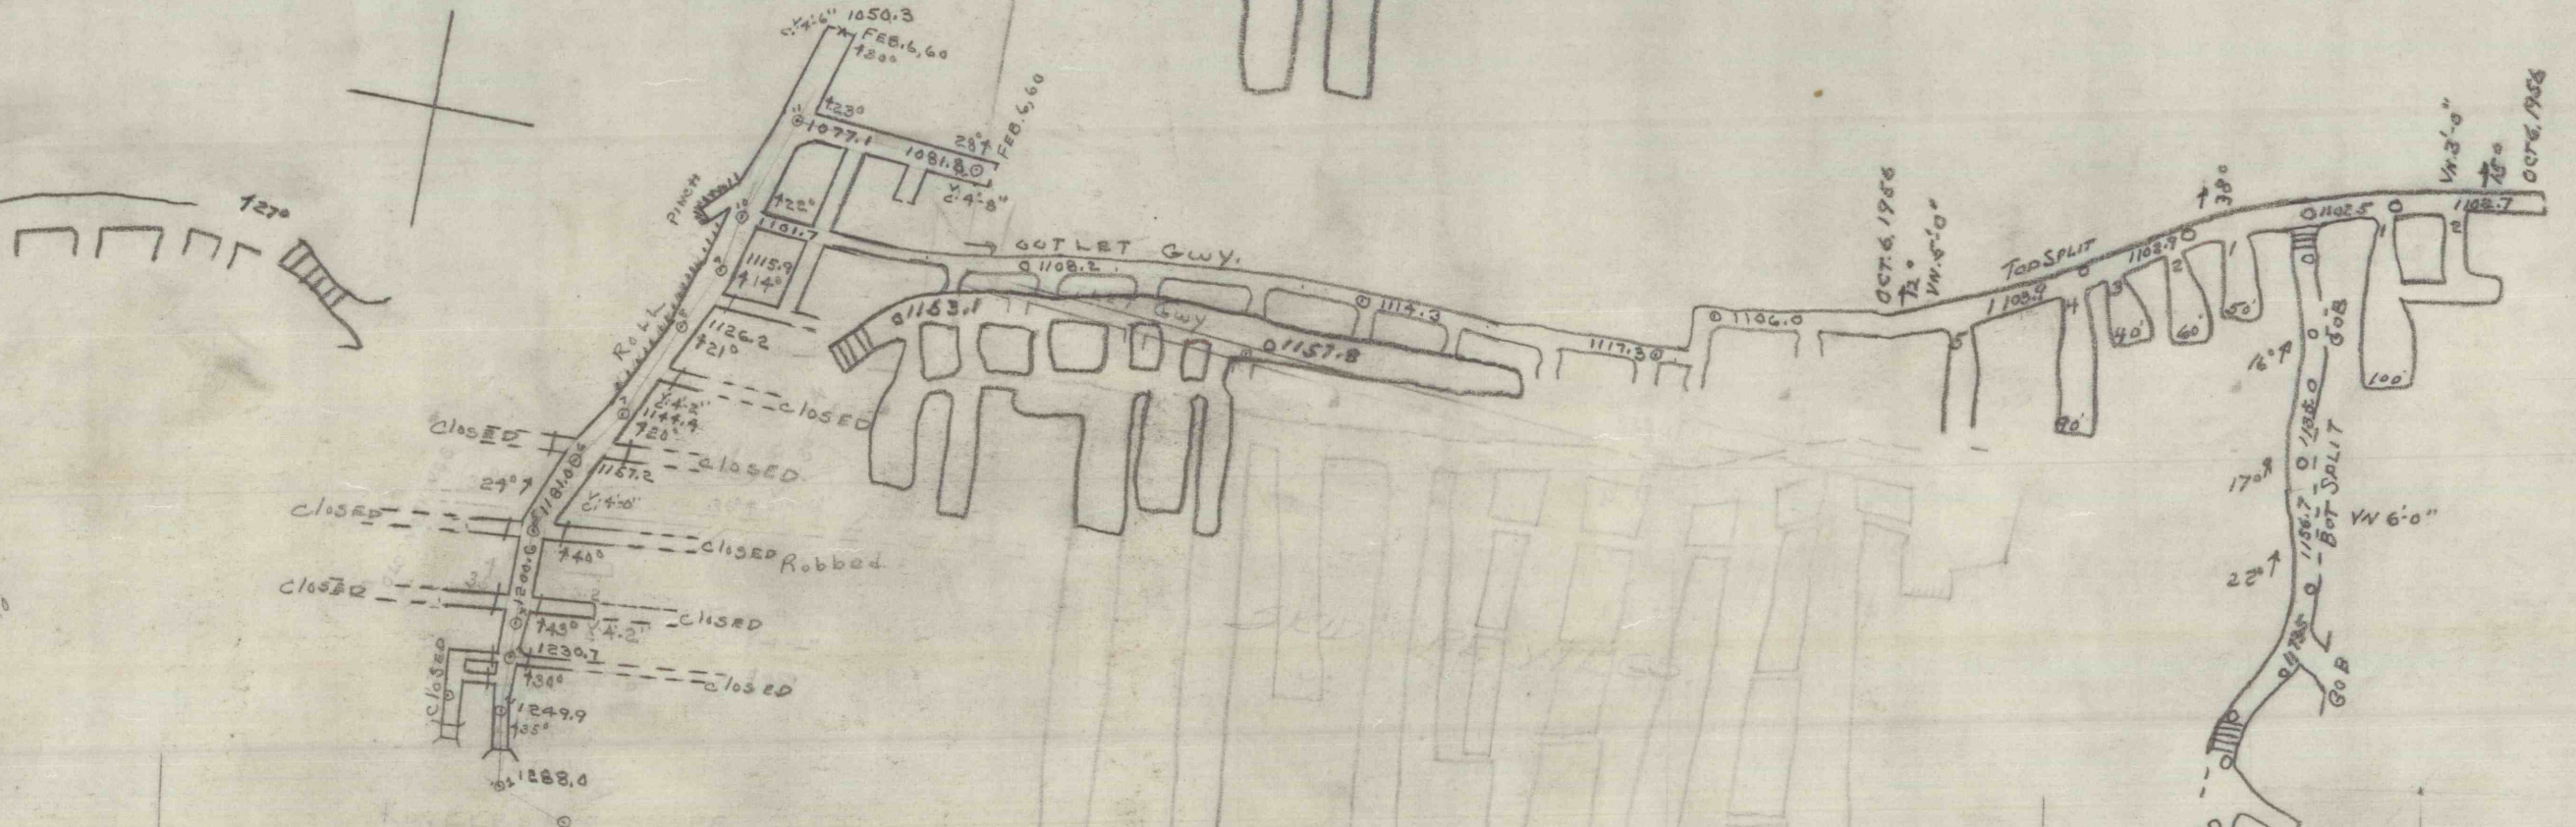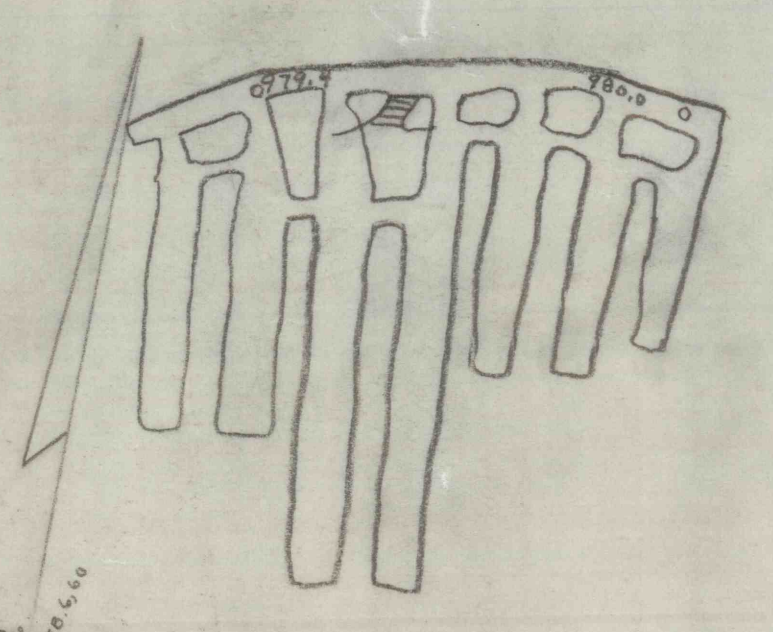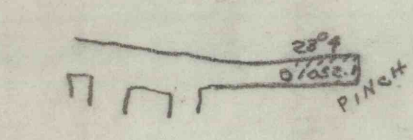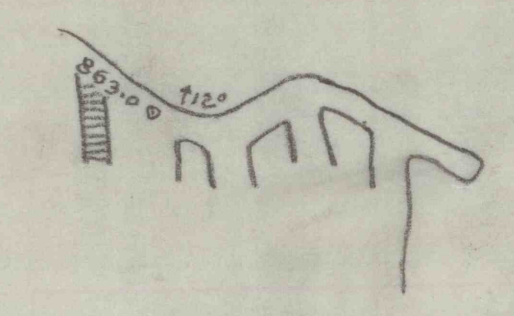

1000  
800  
600  
400  
200  
0

70  
80  
90  
100

BRICK  
MASONRY  
MASONRY  
BRICK  
MASONRY  
BRICK  
CONCRETE  
MASONRY  
MASONRY

1000  
800  
600  
400  
200  
0





70  
80  
90  
100

10  
20  
30  
40  
50  
60  
70  
80  
90  
100

+

+

+

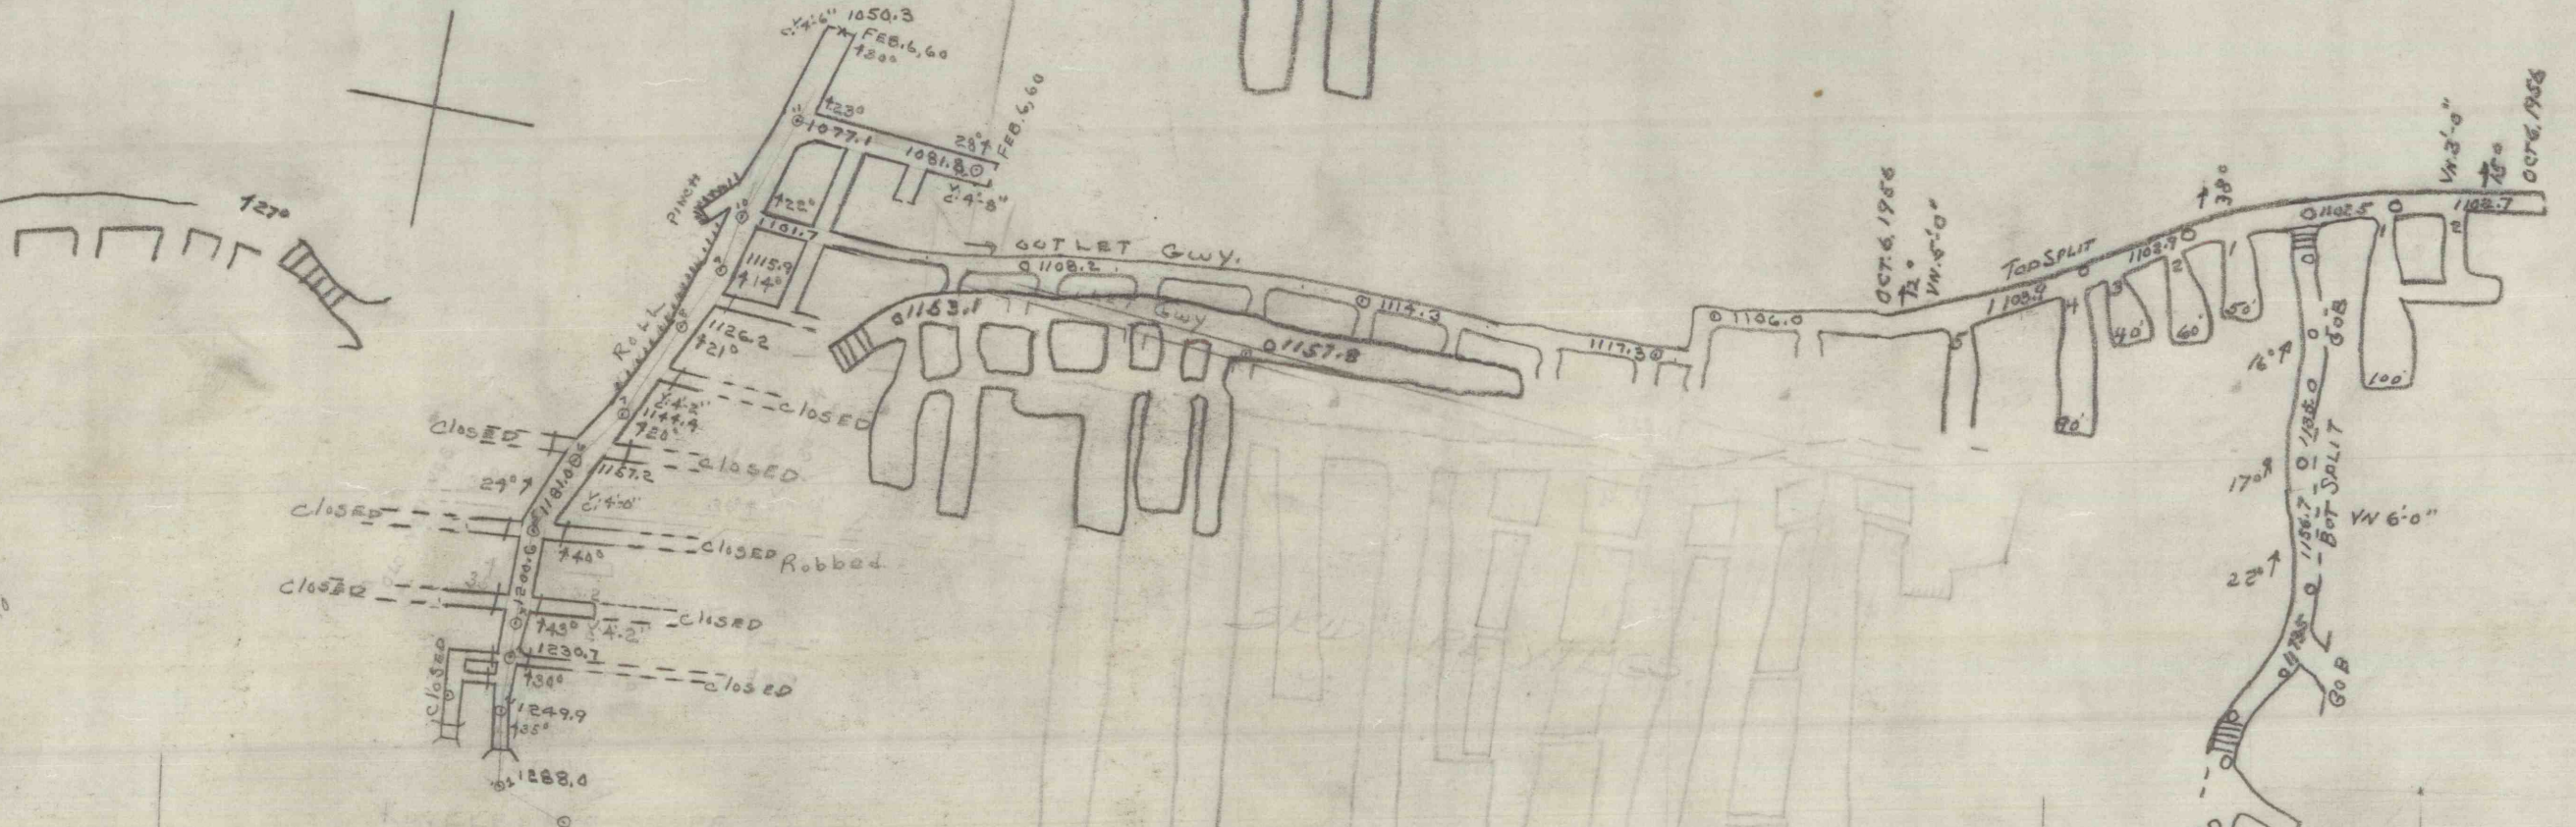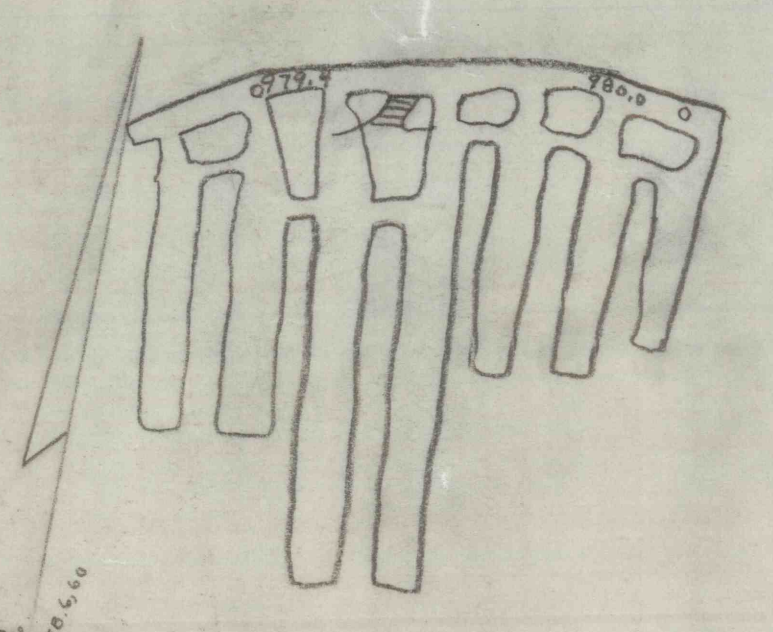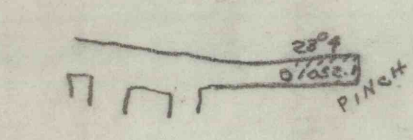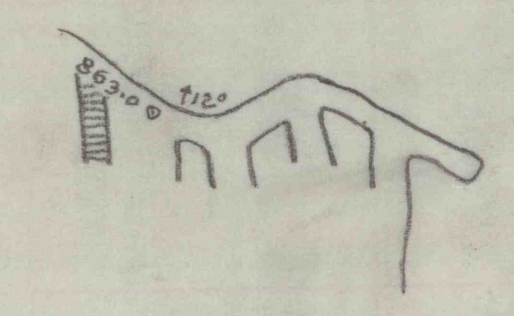

1000  
800  
600  
400  
200  
0

70  
80  
90  
100

BRICK  
MASONRY  
MASONRY  
BRICK  
MASONRY  
BRICK  
CONCRETE  
MASONRY  
MASONRY

1000  
800  
600  
400  
200  
0

70  
80  
90  
100

10  
20  
30  
40  
50  
60  
70  
80  
90  
100

+

+

+