



DANCOTT COLL'Y. - SHAMOKIN, PA.

SECTION N° 1

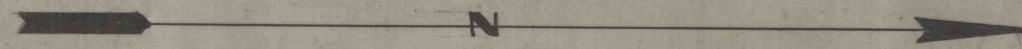

SCALE 1 IN. = 50 FT.

330

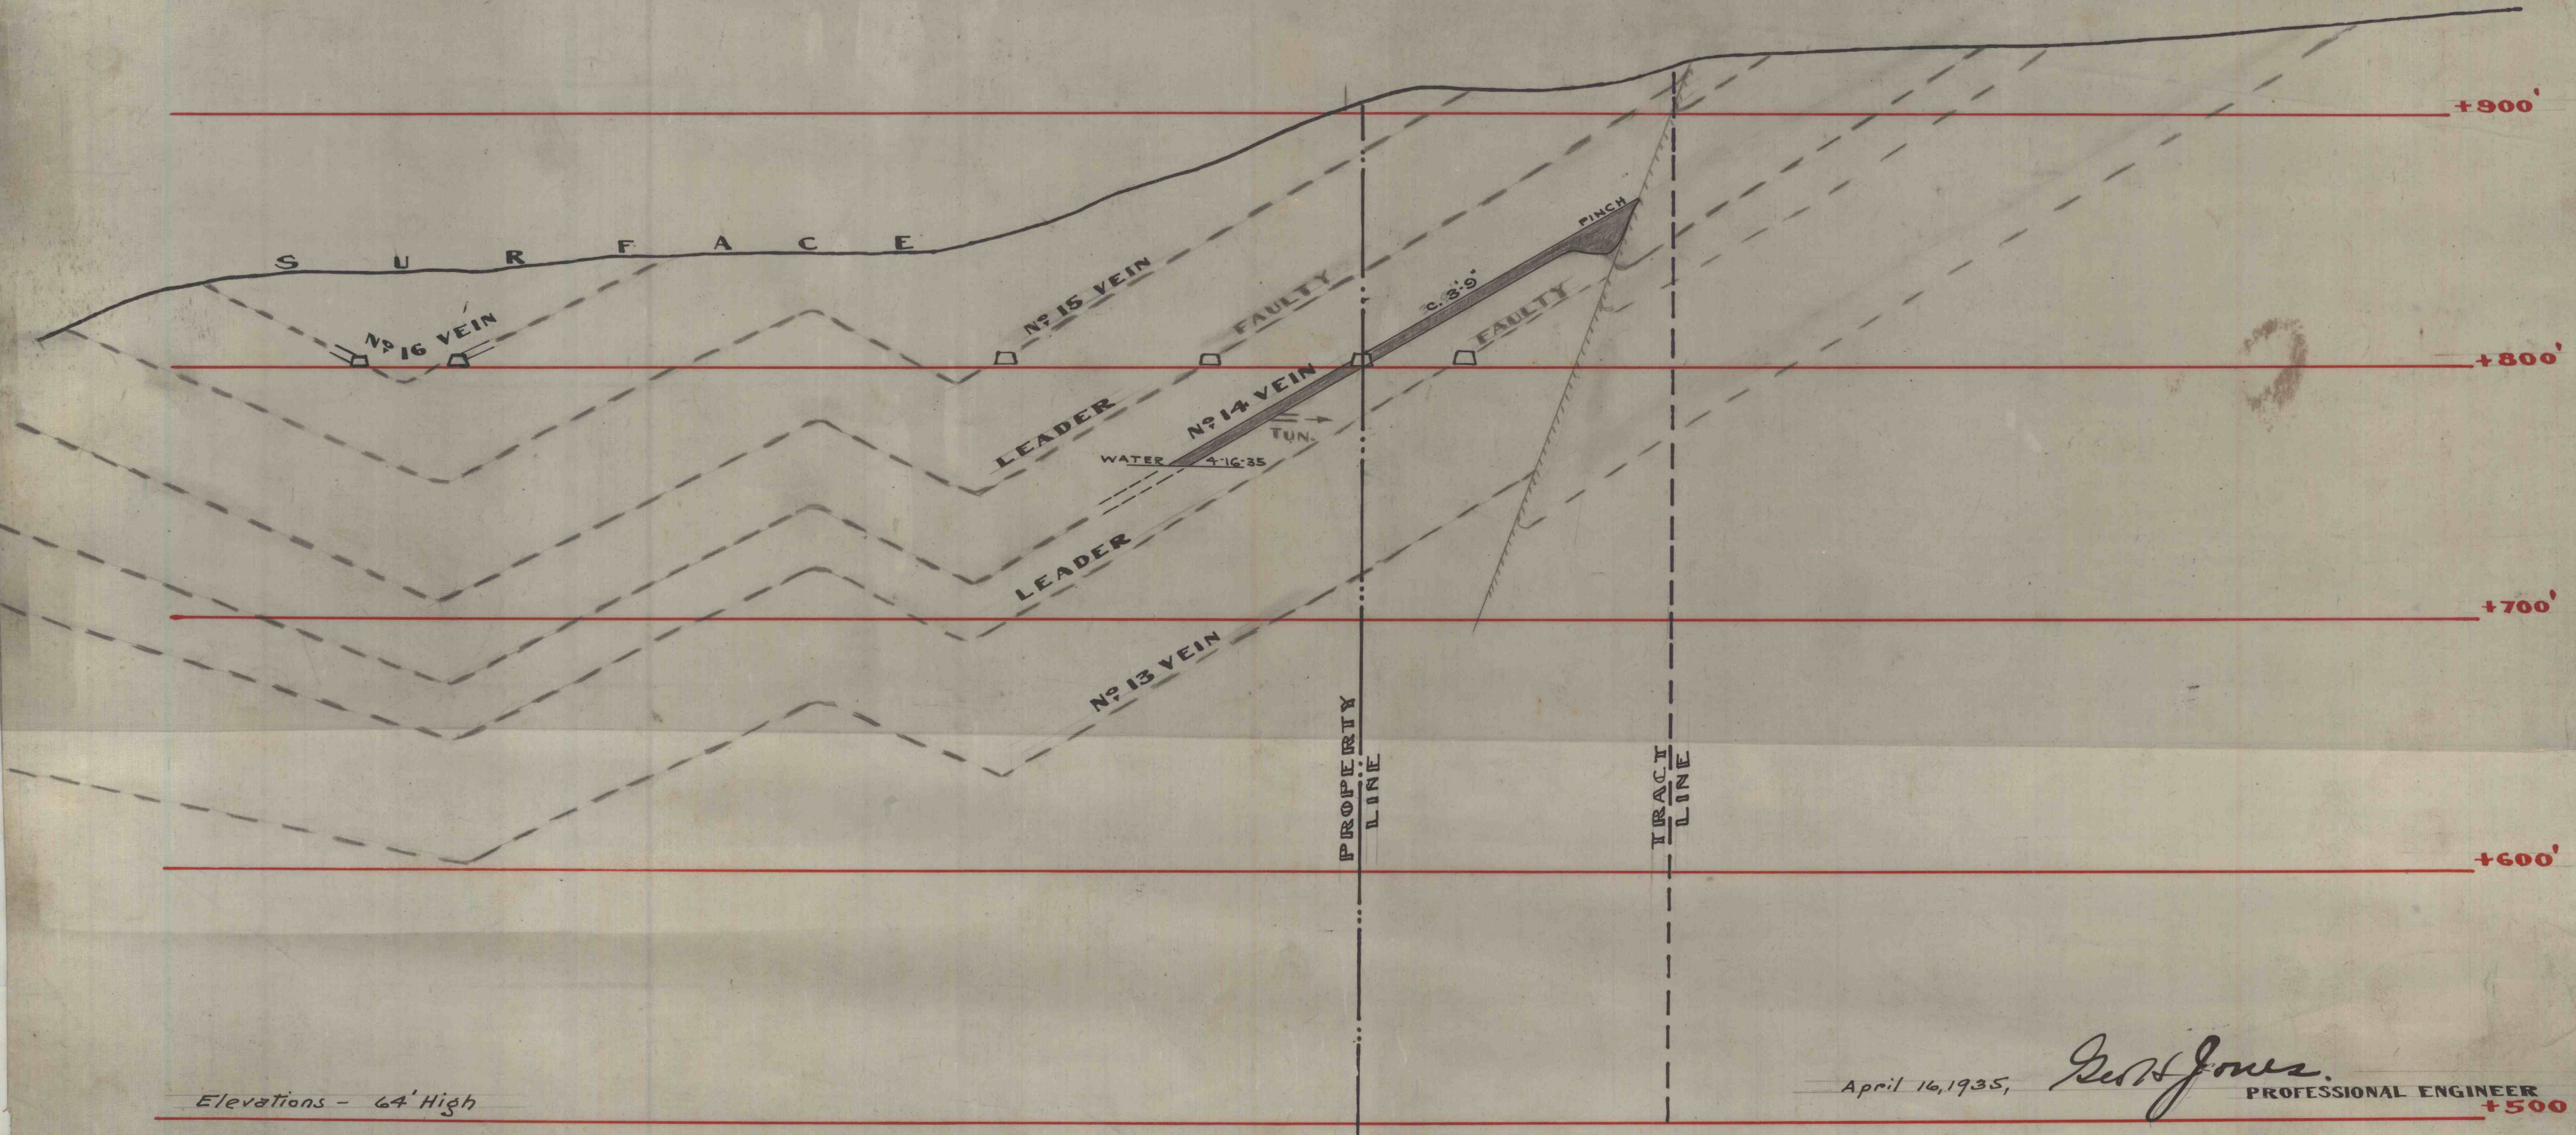

Elevations - 64' High

April 16, 1935,

G. H. Jones.

PROFESSIONAL ENGINEER

+500'