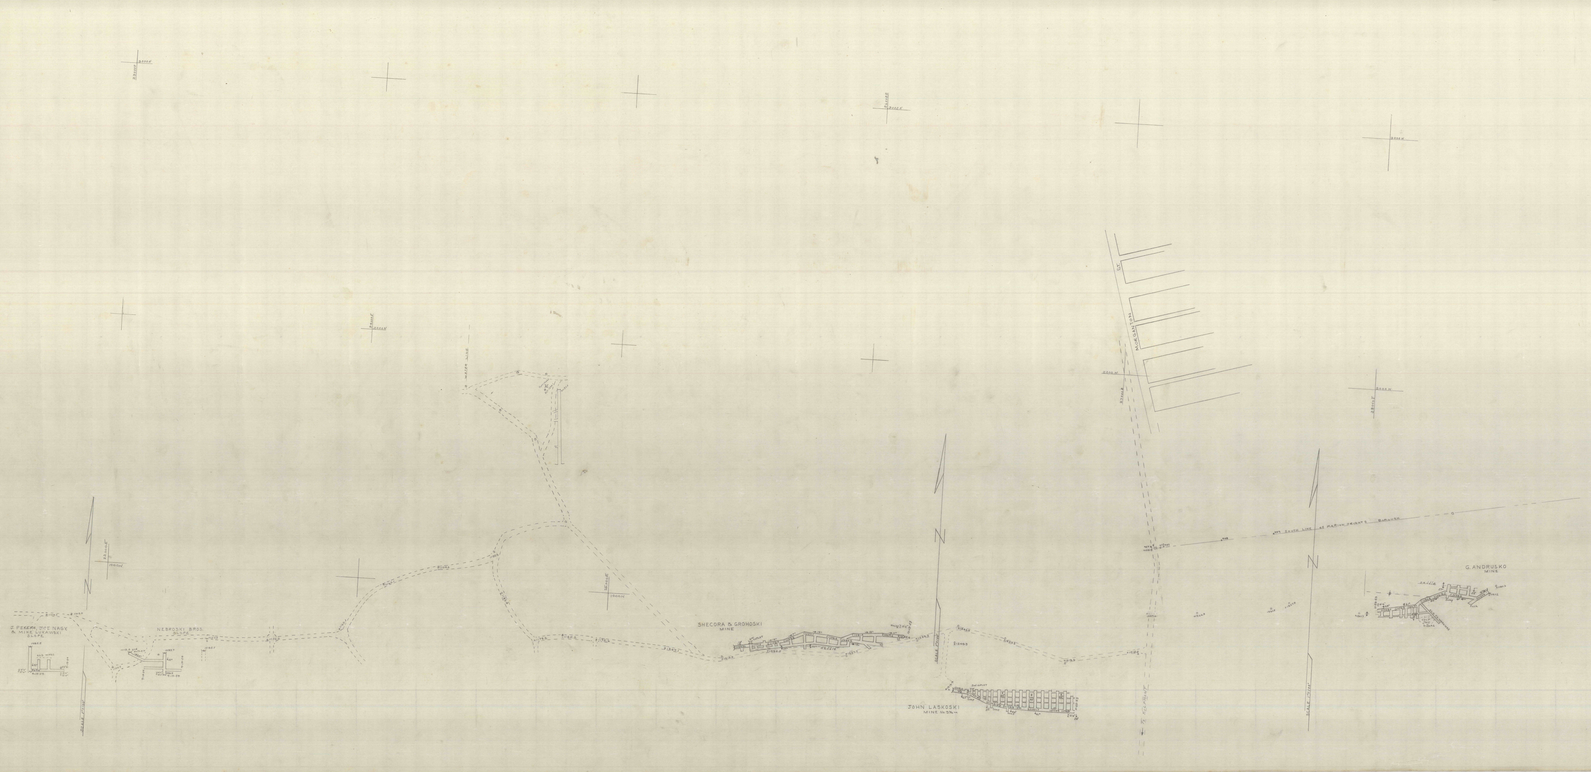
NEBOSKY BROS.
SHECORA & GROMOSKI
JOHN LASKOSKI
G. ANDRUSKO