


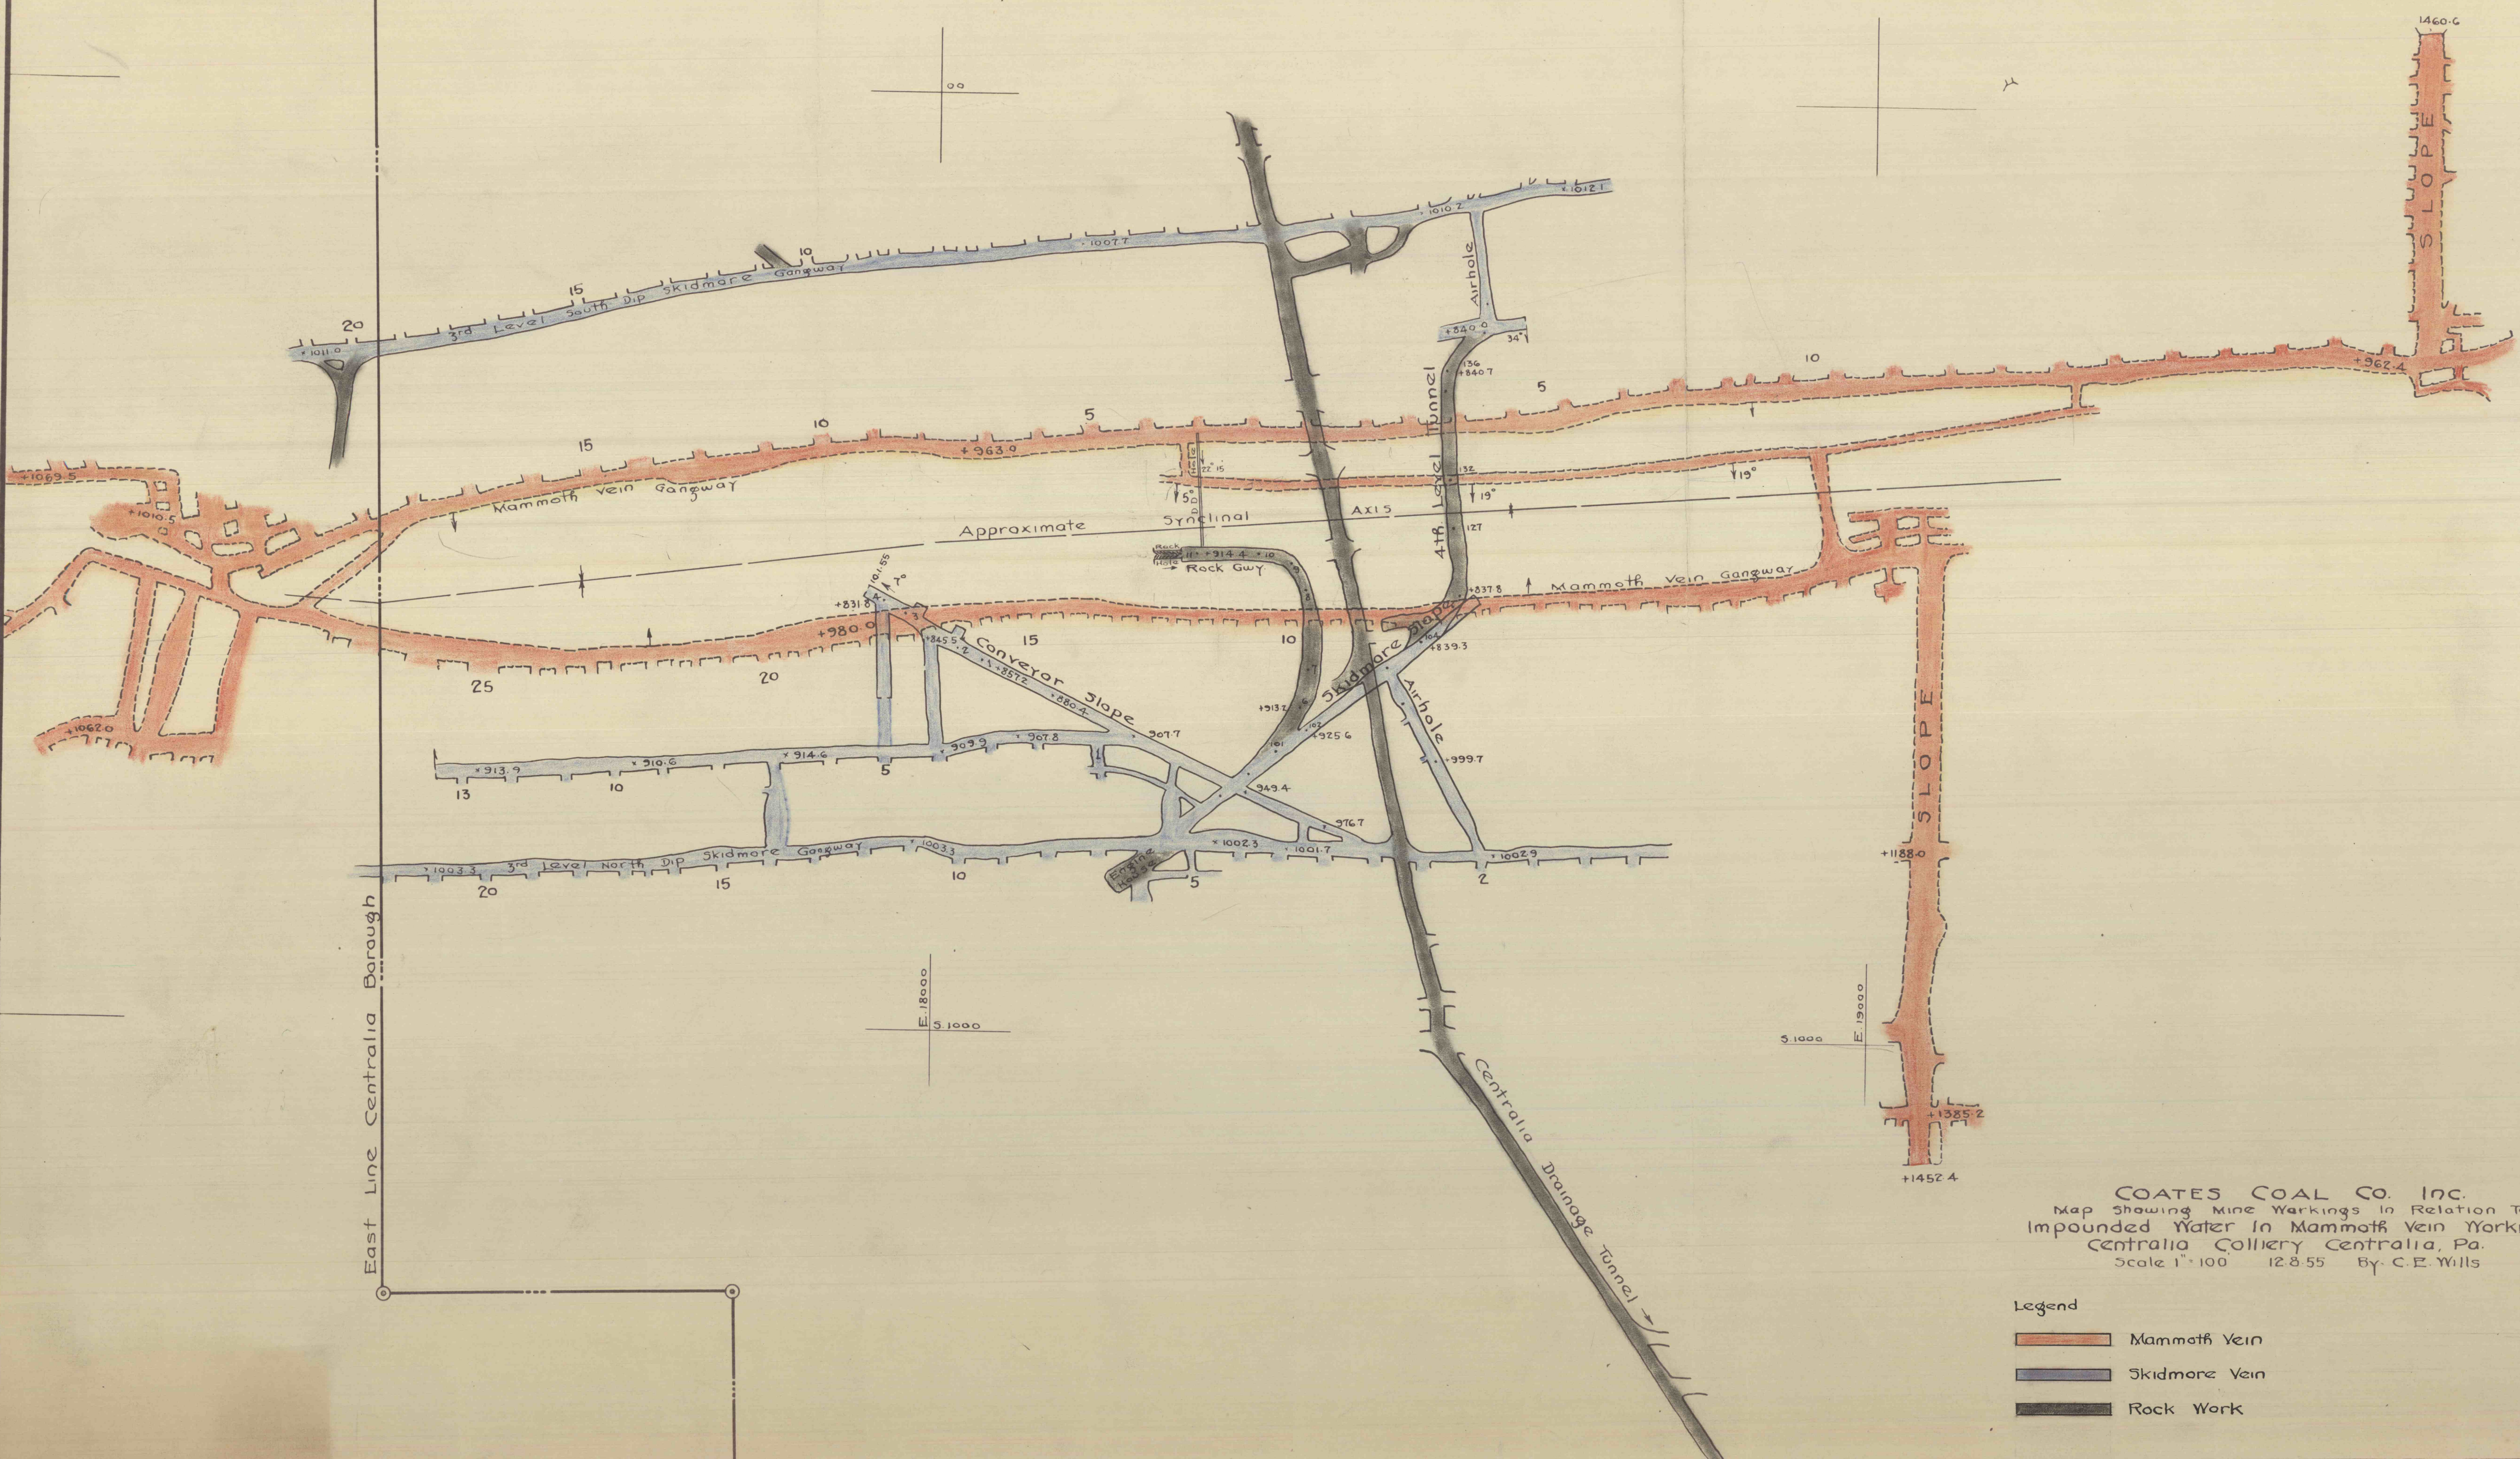

COATES COAL CO. INC.
Map showing Mine Workings in Relation to
Impounded Water in Mammoth Vein Workings
Centralia Colliery Centralia, Pa.
Scale 1" = 100' 12.8.55 By C. E. Wills

- Legend
- Mammoth Vein
 - Skidmore Vein
 - Rock Work