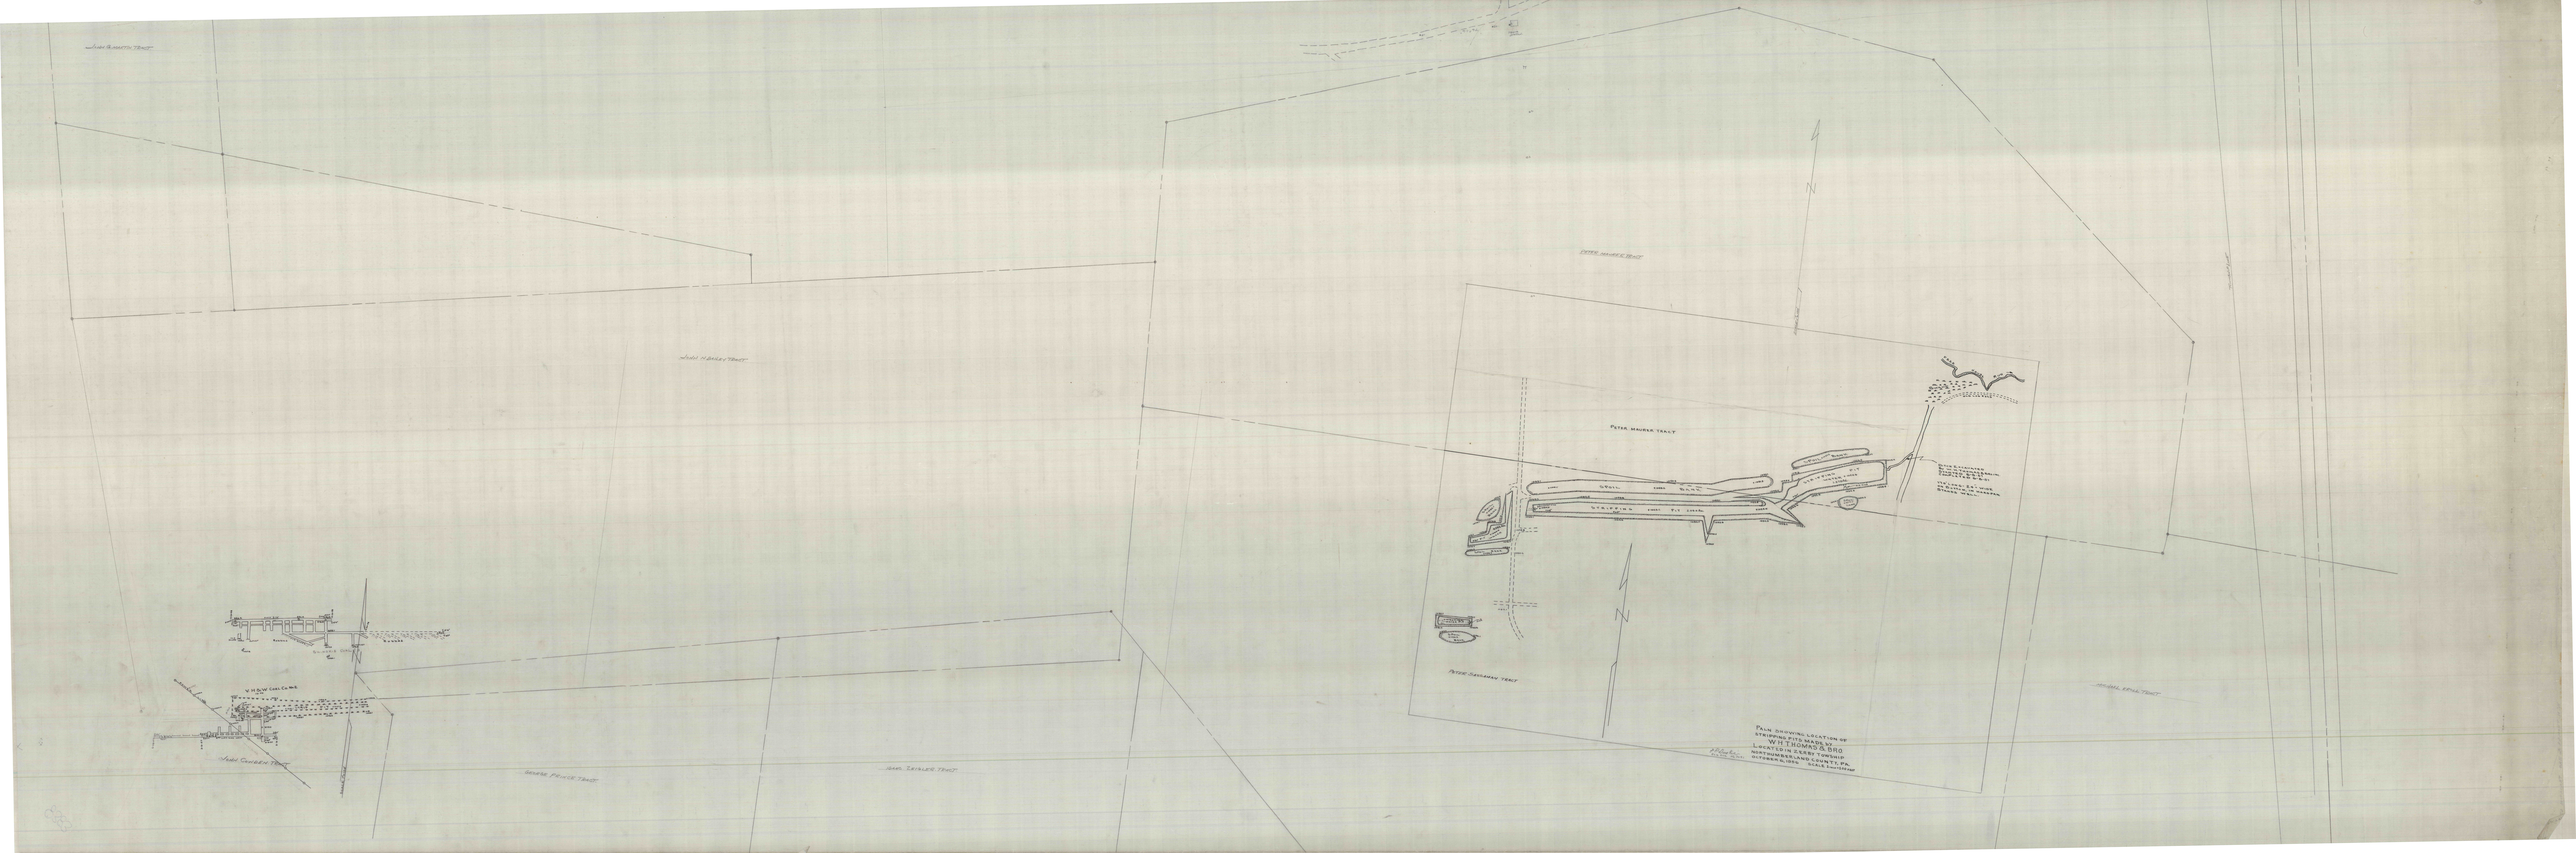
PETER MAURER TRACT
PETER SHOEMAN TRACT
PLAN SHOWING LOCATION OF
STRIPPING PITS MADE BY
W. H. T. THOMAS & BRO
