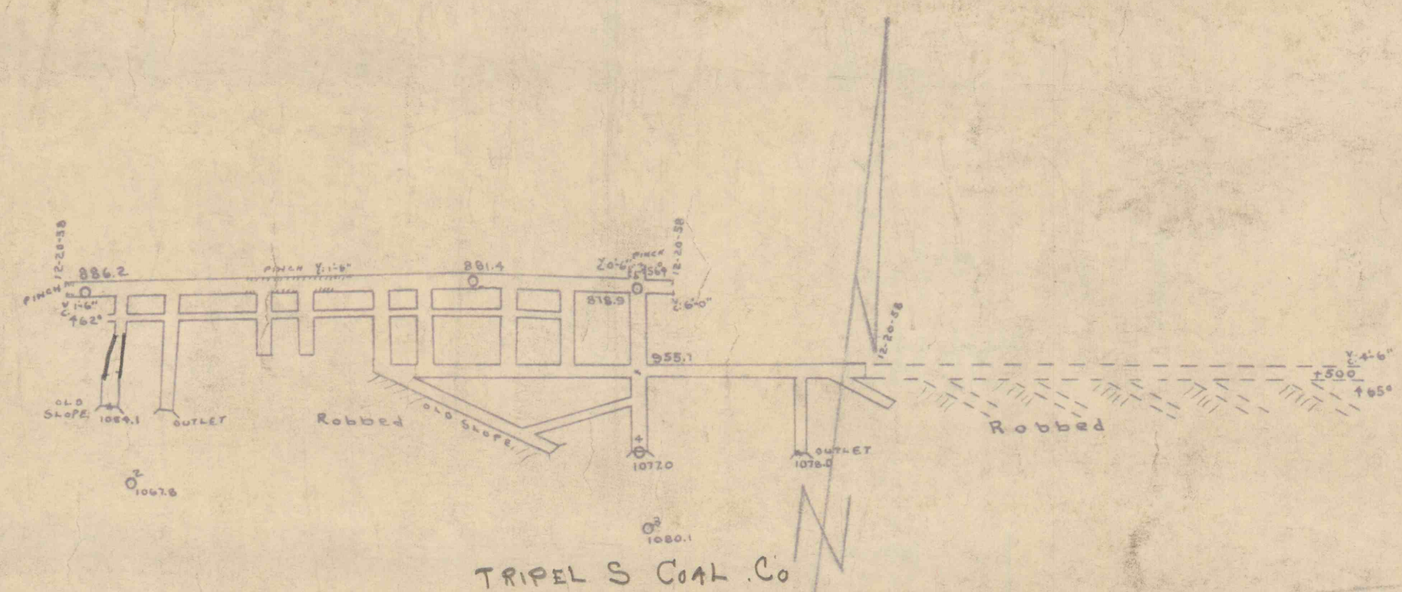
886.2
PINCH 12-20-58
PINCH Y 1'-6"
881.4
818.9
955.1
OLD SLOPE
1089.1
OUTLET
Robbed
OLD SLOPE
1077.0
1078.0
OUTLET
Robbed
1067.8
1080.1
TRIPEL S COAL Co

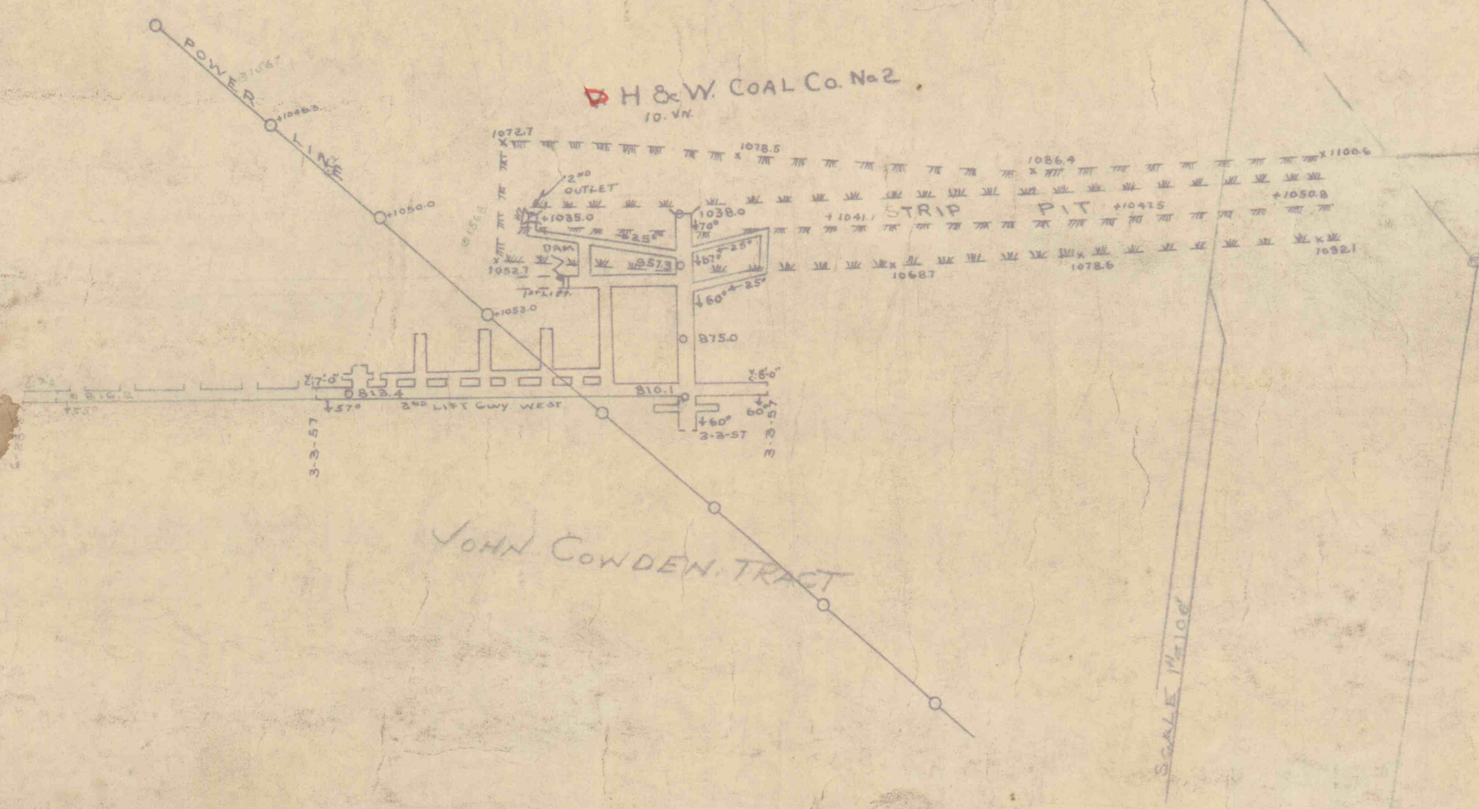
POWER LINE
H & W. COAL Co. No 2.
10. VN.
2ND OUTLET
STRIP PIT
DAM
875.0
810.1
2ND LIFT GWY WEST
3-3-57
JOHN COWDEN TRACT
SCALE 1" = 100'

401