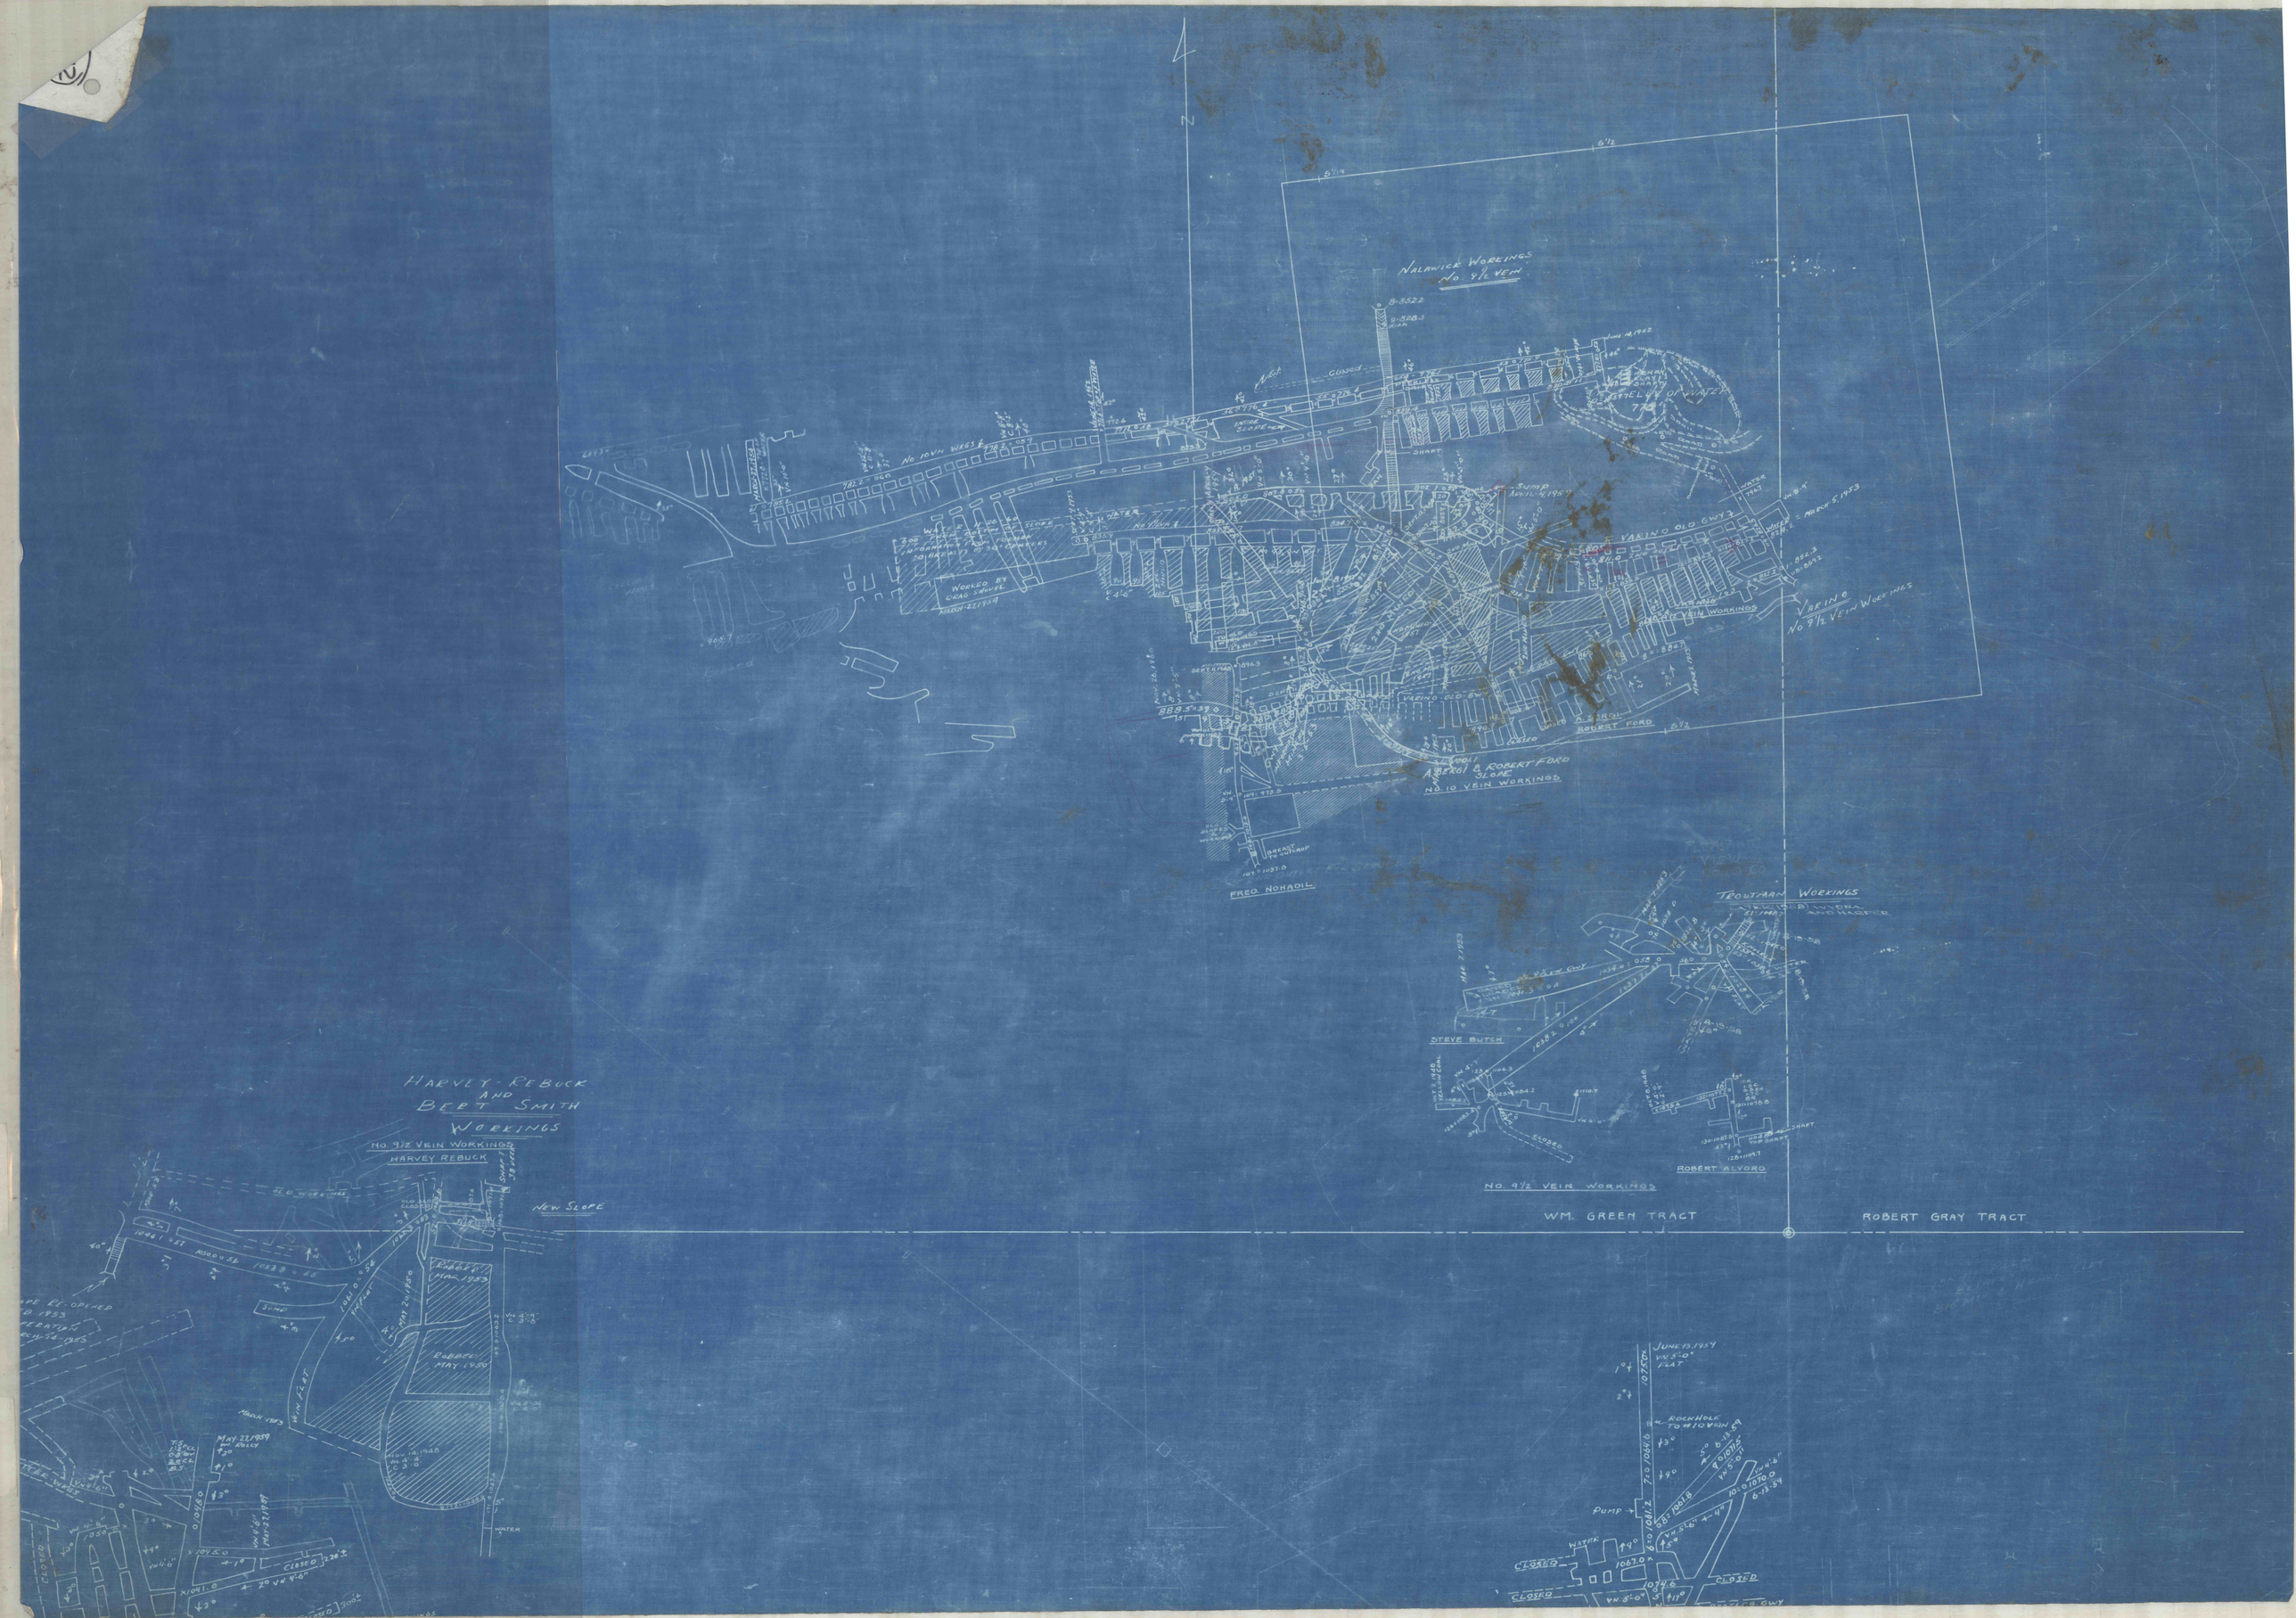
N
Nalewick Workings
No. 9½ Vein
Shaft
Closed
No 10 Vin Wrks
Worked by Geo. Shovel
March 22 1954
Water
No 11 Vein
Vein O Old Gwy
Vein O
No 9½ Vein Workings
Sump
April 11 1954
Robert Ford
Arbrol & Robert Ford Slope
No. 10 Vein Workings
Fred Nonadil
Troutman Workings
Steve Butch
Closed
No. 9½ Vein Workings
Robert Alvord
Wm. Green Tract
Robert Gray Tract
Harvey-Rebuck and Bert Smith Workings
No. 9½ Vein Workings
Harvey Rebuck
New Slope
Robert
May 1950
Water
May 22 1959
Rolly
Closed
June 13 1959
Rock Hole To No 10 Vein
Pump
Water
Closed