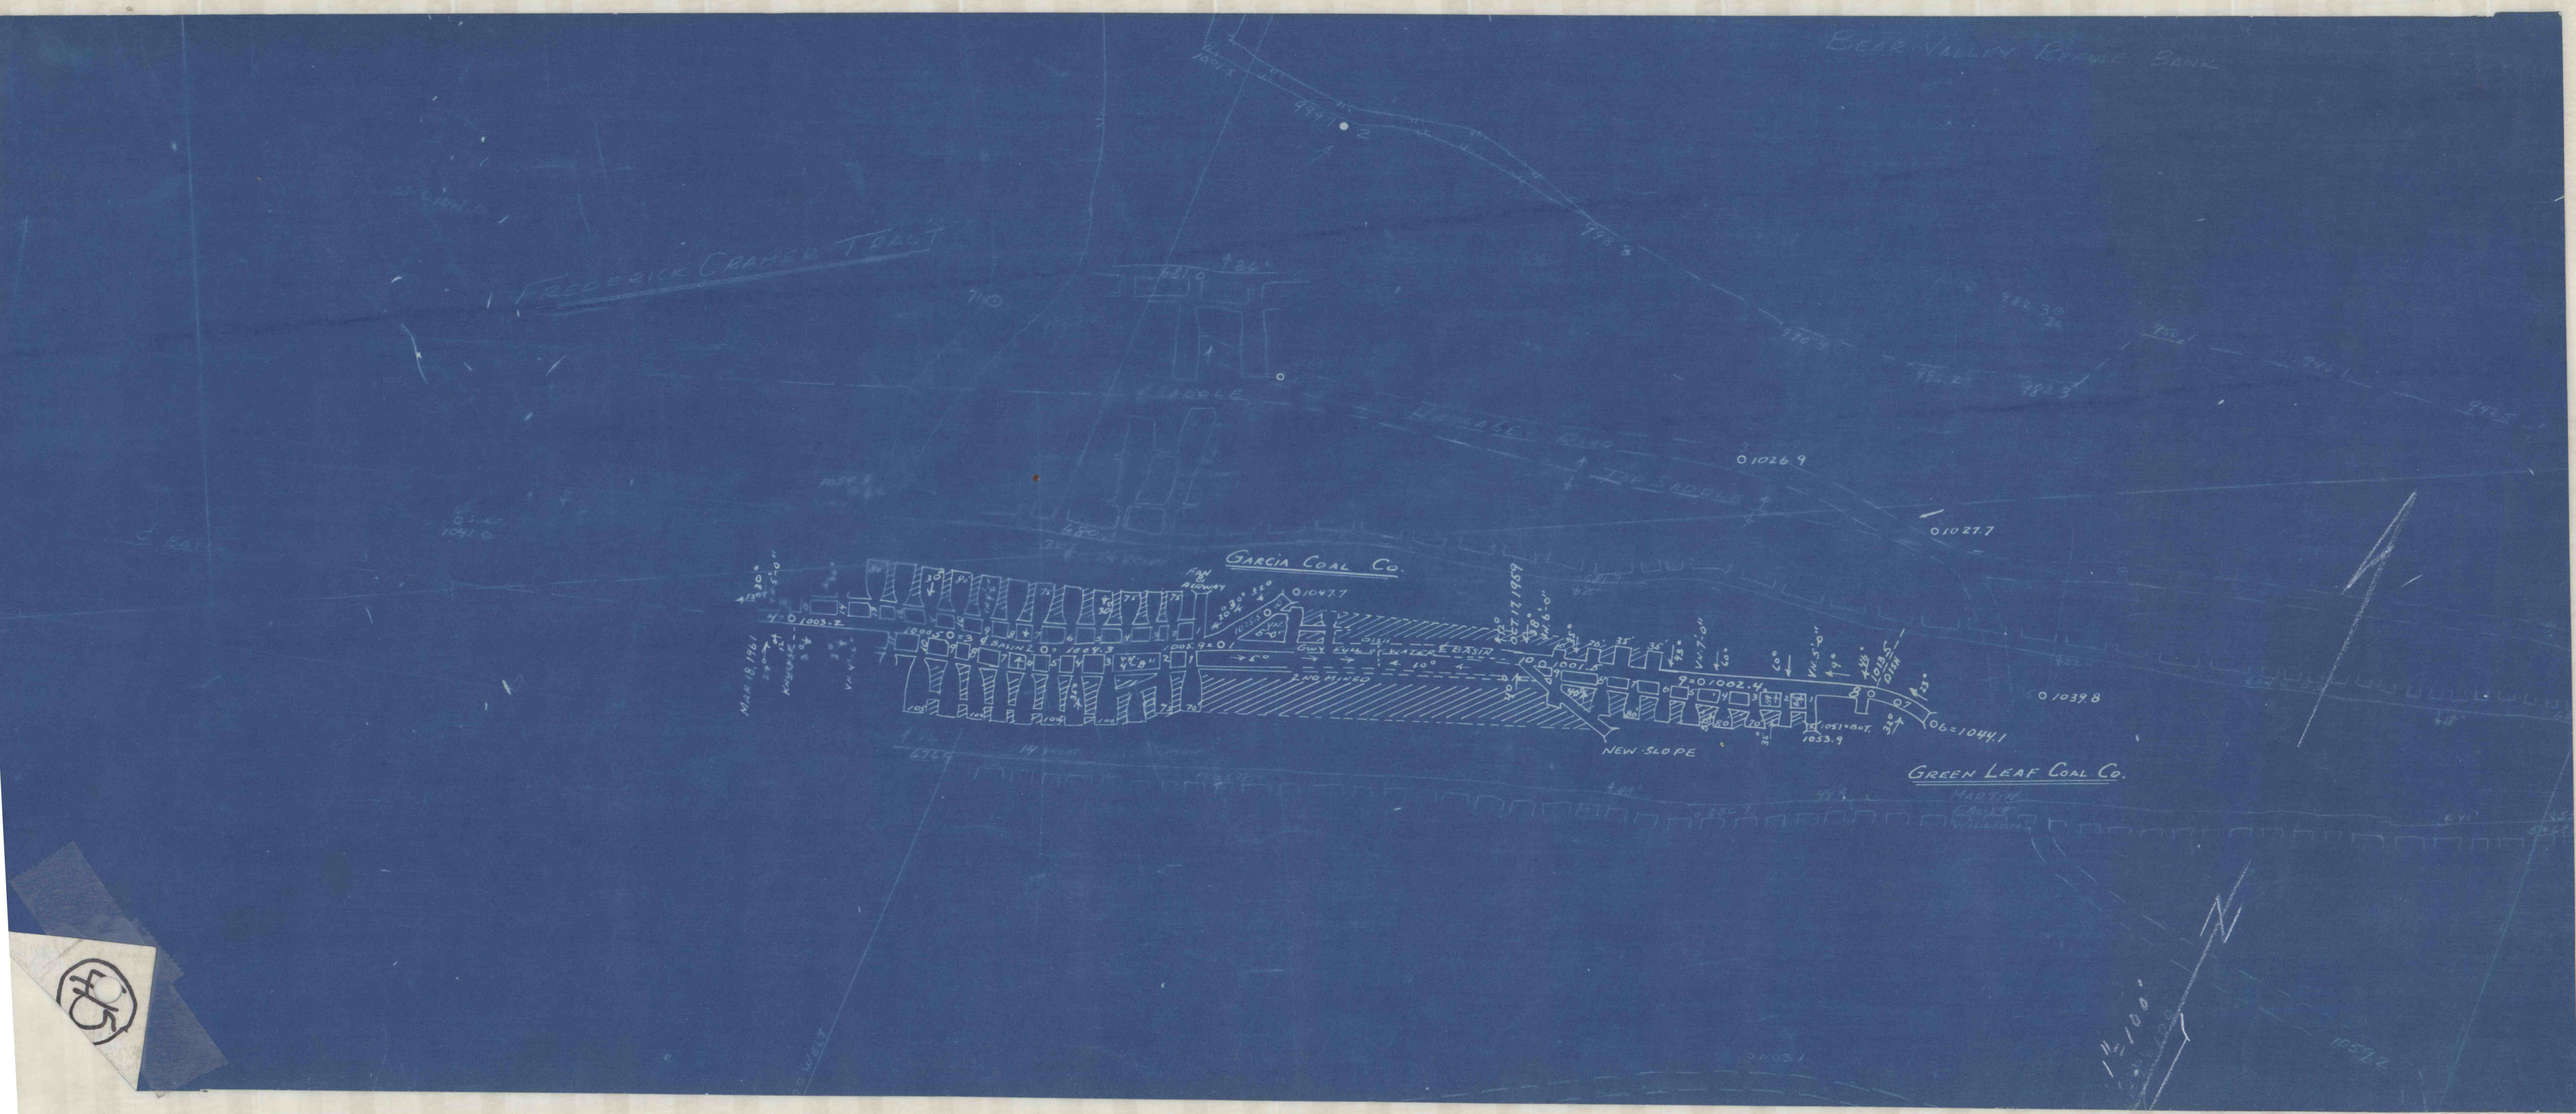
FREDERICK CRAMER TRACT
GARCIA COAL CO.
FAN ROOM
ROOM
WATER BASIN
GUY EYE
NO MINED
OCT. 12 1959
NEW SLOPE
GREEN LEAF COAL CO.
1026.9
1027.7
1039.8
1047.7
1044.1
1033.9
1041.0
1:100'