


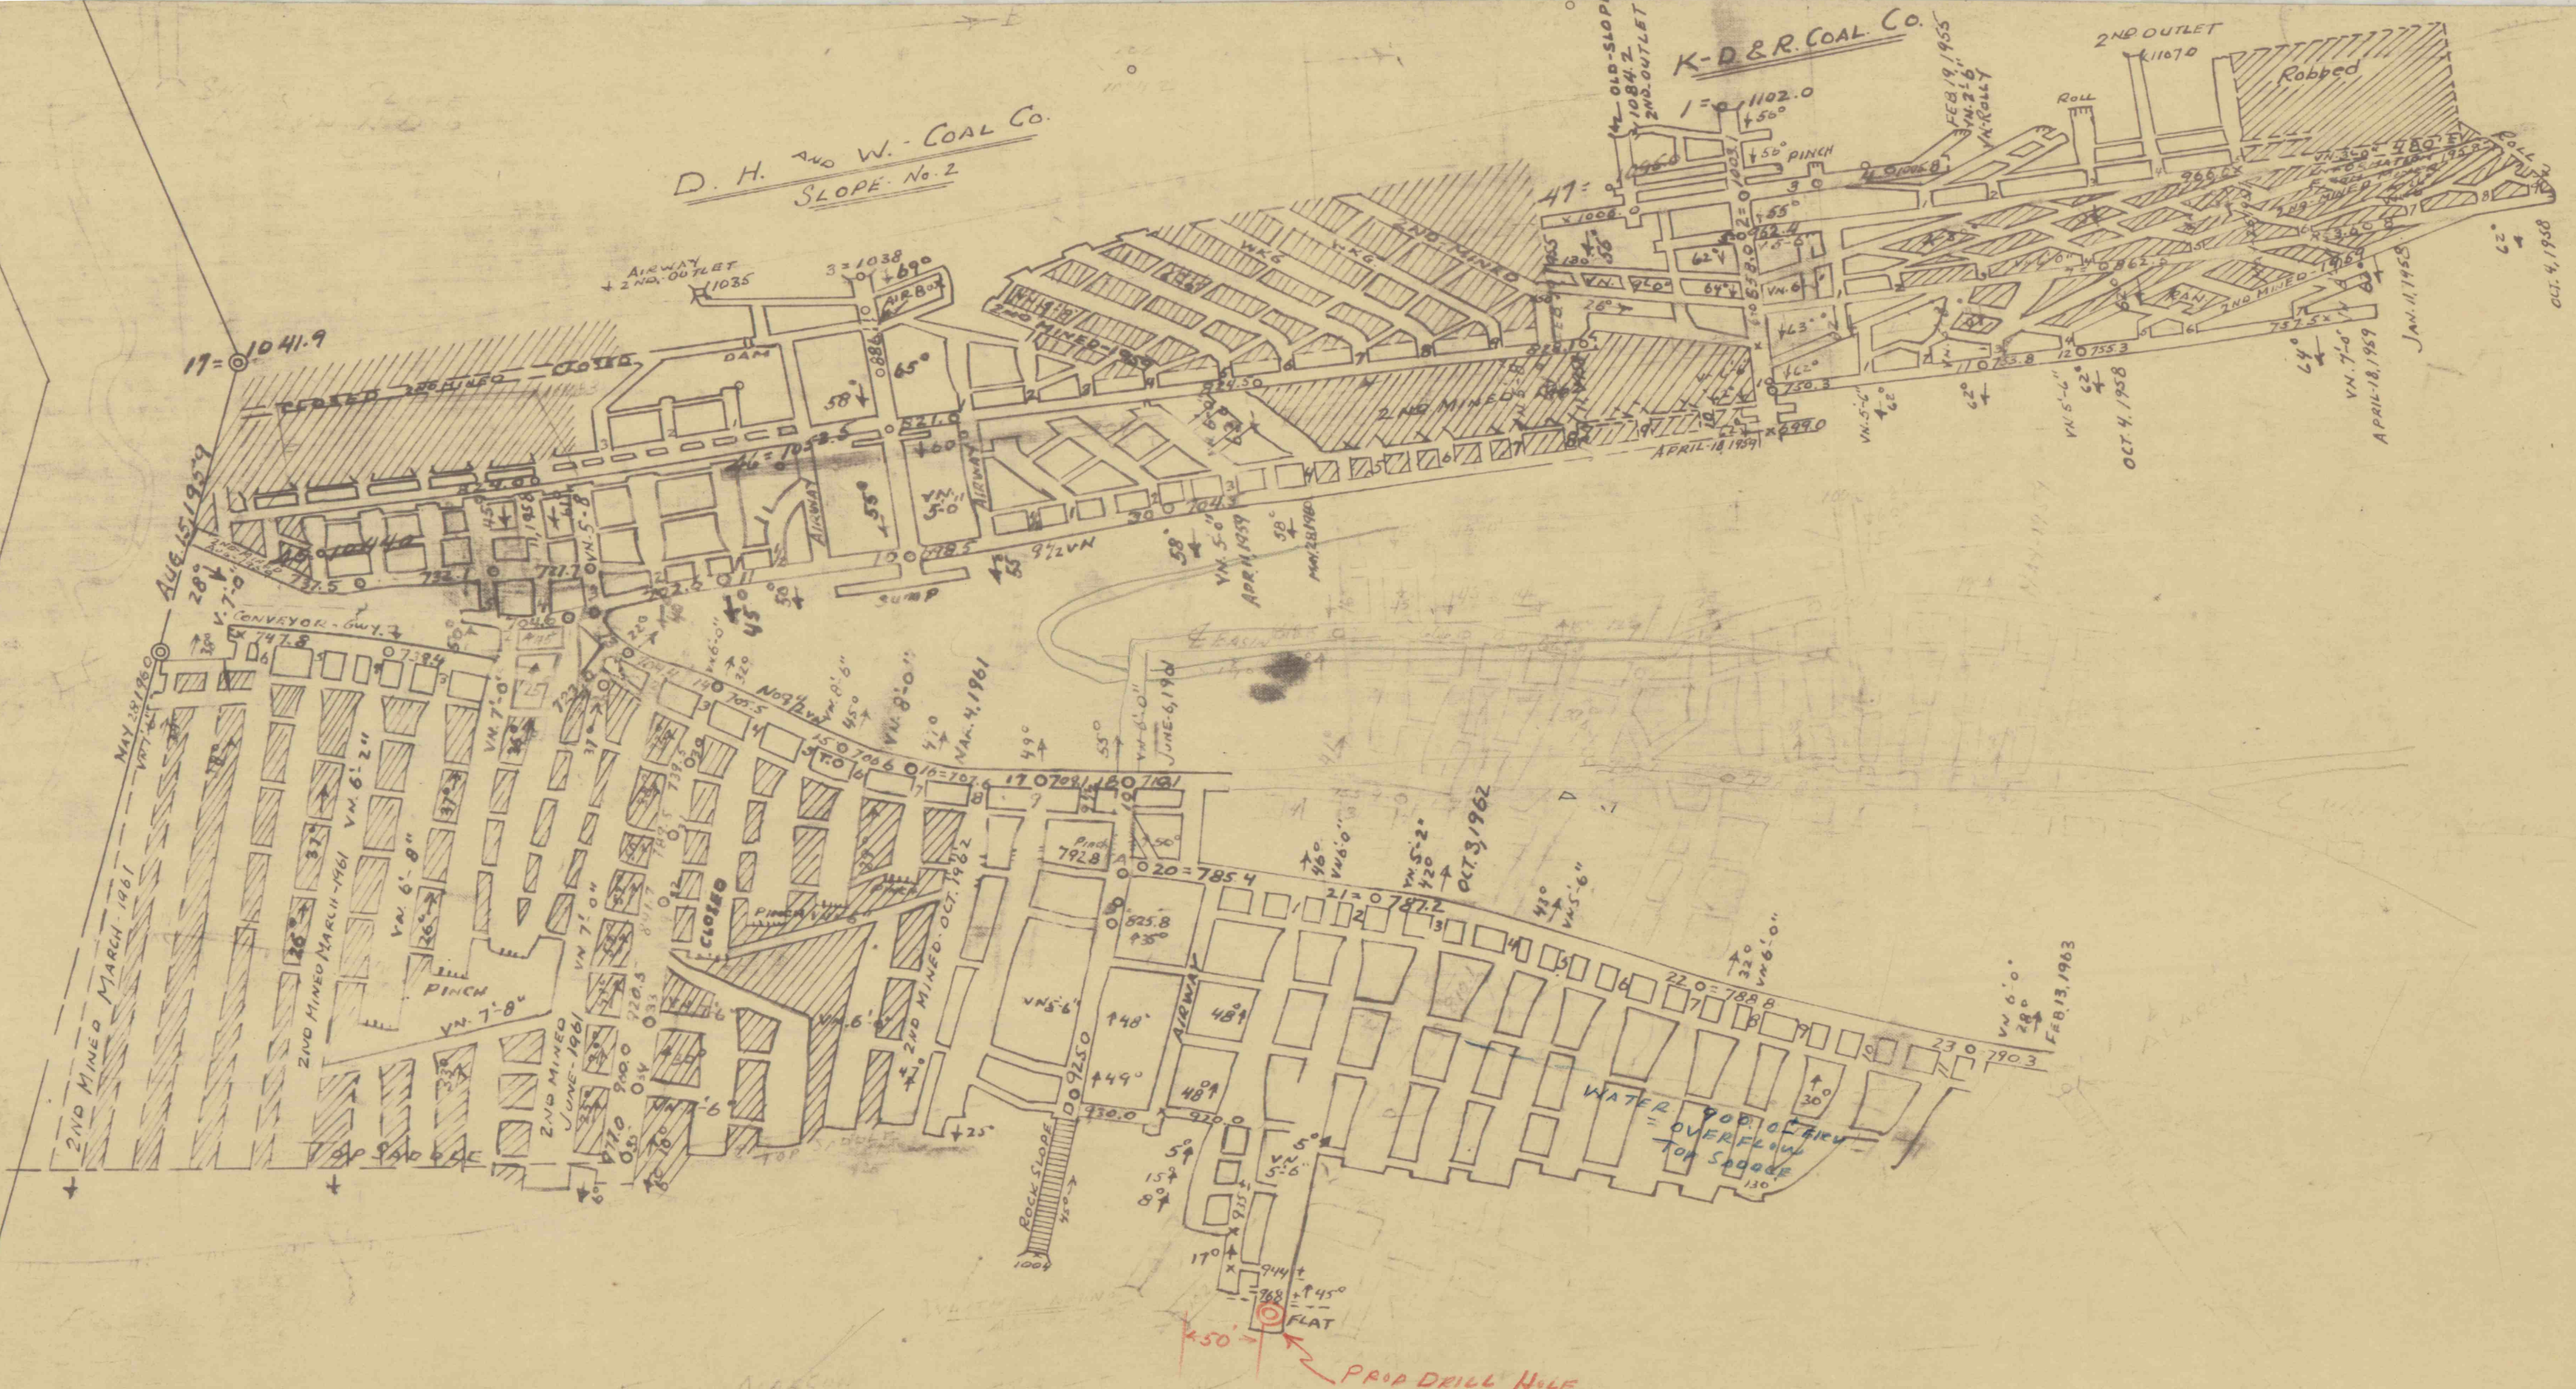

Stopping Outline