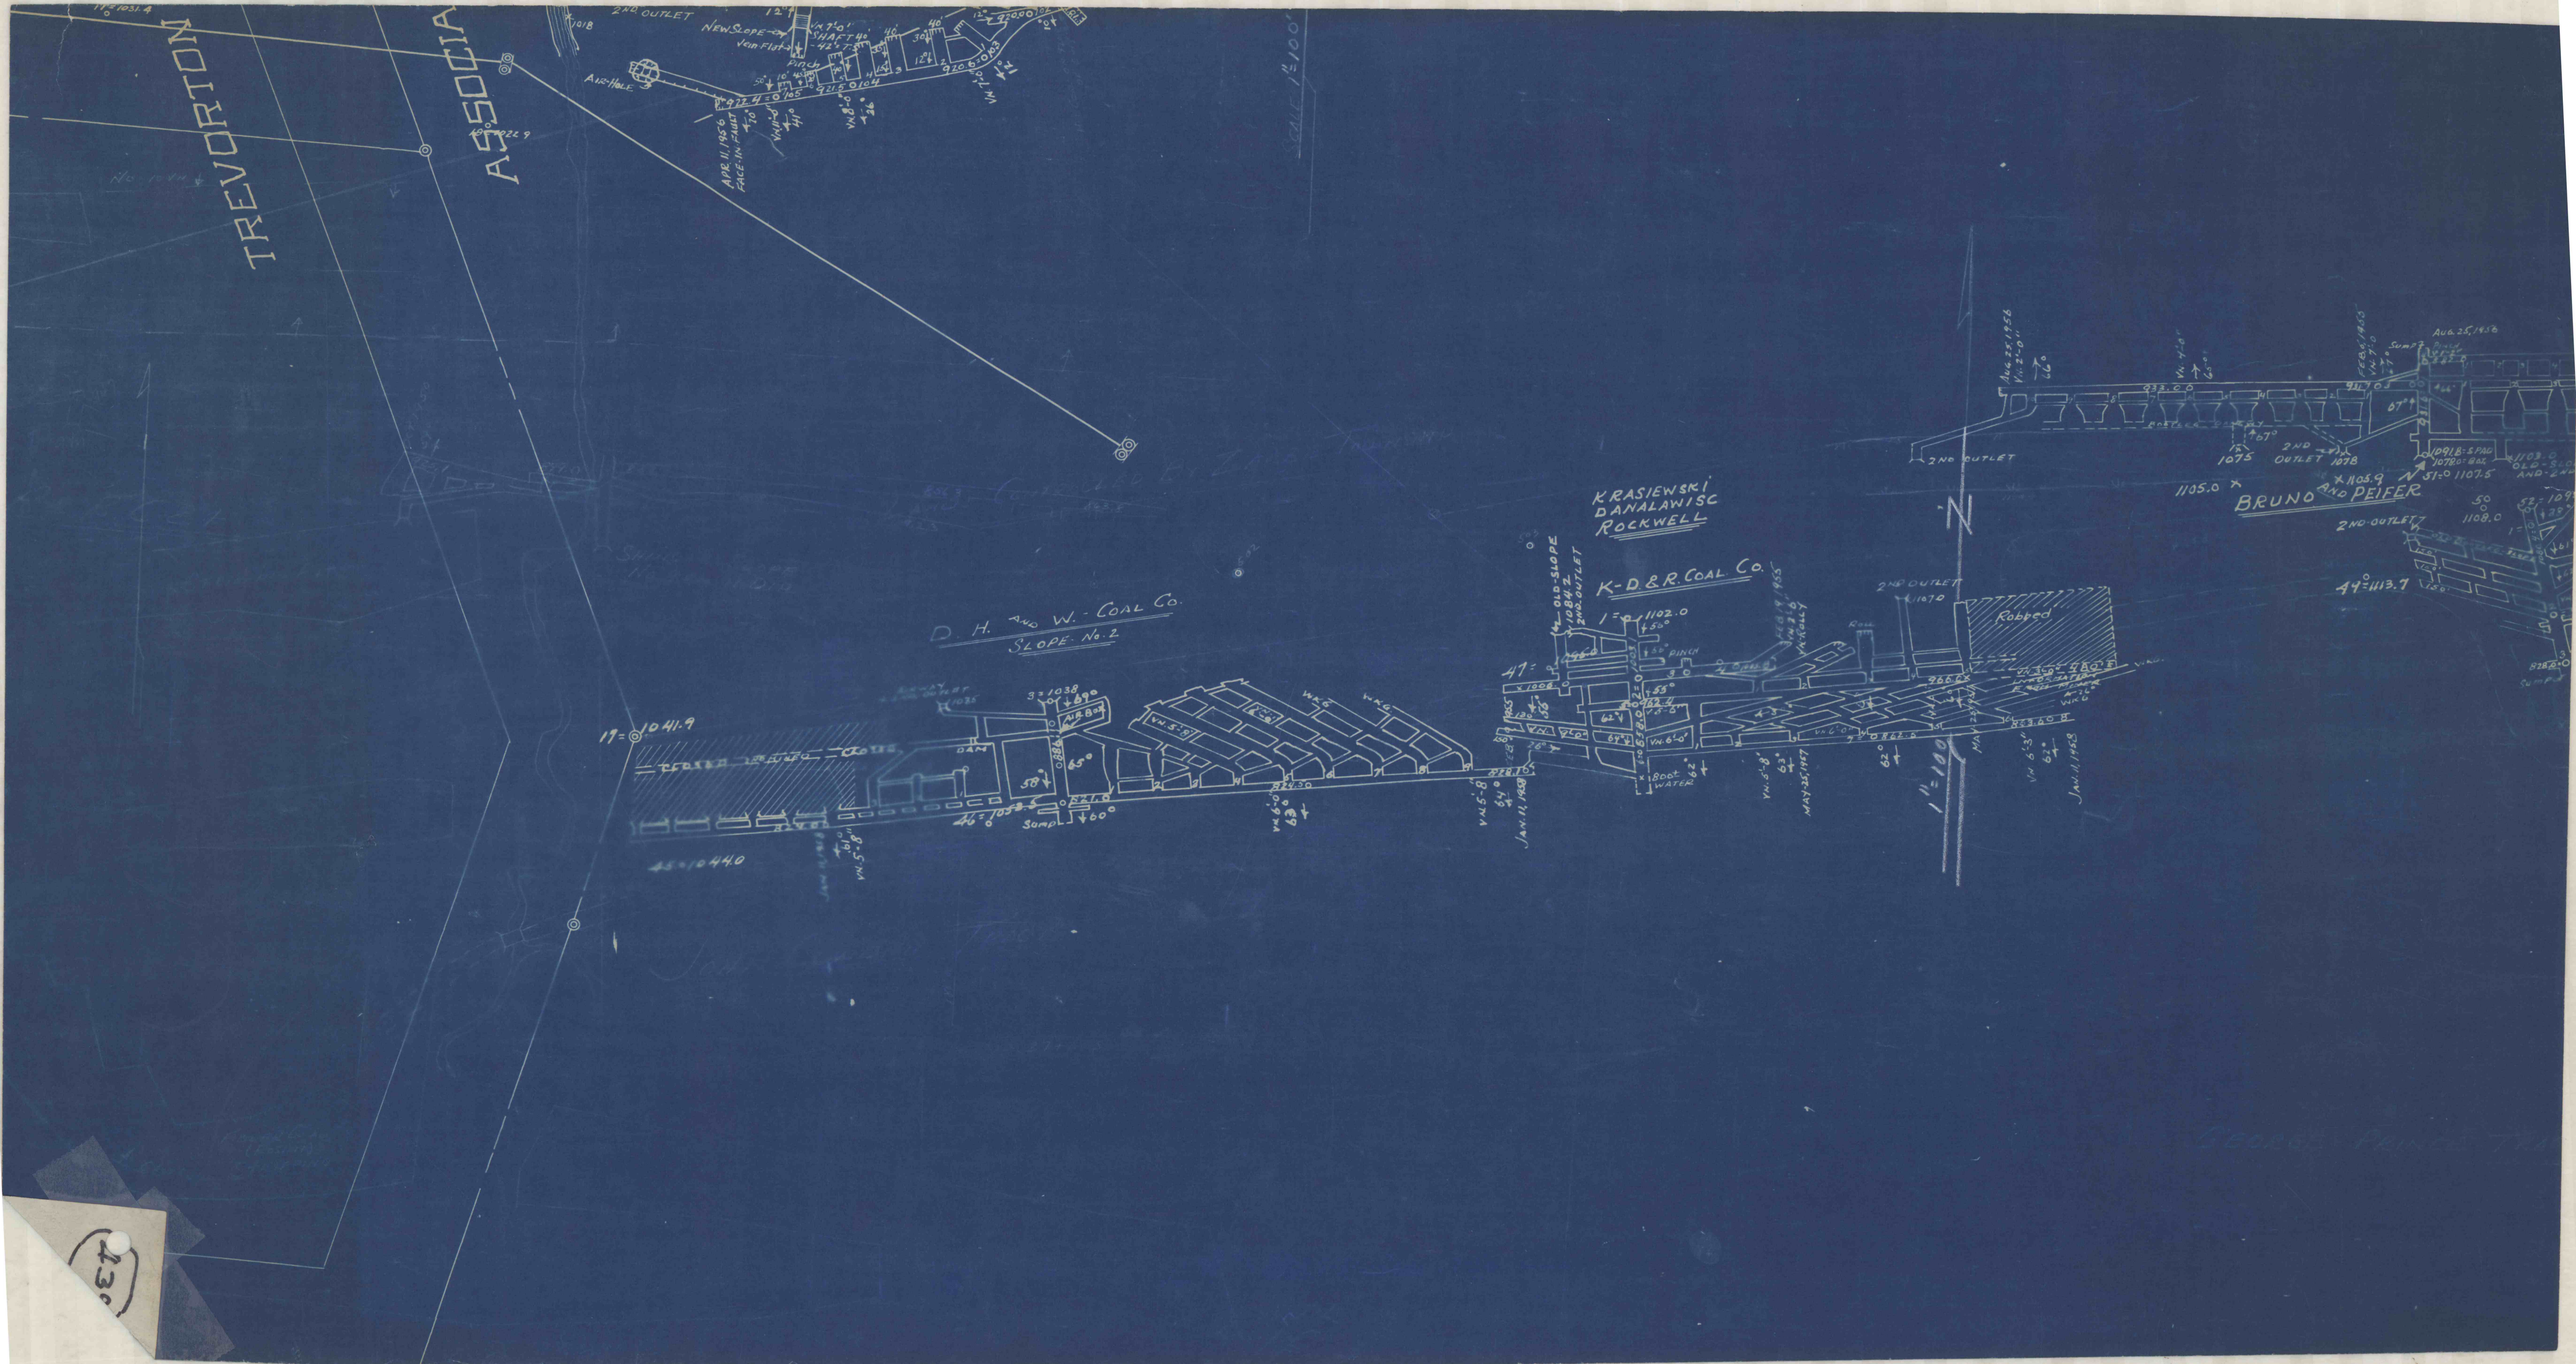
TREVORTON
ASSOCIA
2ND OUTLET
NEW SLOPE
SHAFT
AIR HOLE
APR. 11, 1956
FACE IN FAULT
D. H. AND W. COAL CO.
SLOPE No. 2
SUMP
JAN. 11, 1958
KRASIEWSKI
DANALAWISC
ROCKWELL
K-D & R. COAL CO.
OLD SLOPE
1ND
2ND OUTLET
PINCH
1800 FT WATER
MAY 25, 1947
Robbed
N
BRUNO AND PEIFER
2ND OUTLET
1075
1078
1070
1105.0
1108.0
1113.7
AUG. 25, 1958
SUMP
1041.0
1078.0
1105.9
1107.5
1102.0
1038
1041.9
1044.0
1058.5
1031.4
1022.9
1018
1100
1 = 100