Section Line
Old Road
Excavated & Covered
Road
Bottom of Burning Bank
Active Stripping
Basin Stripping
Zone of Active Stripping
Zone of Future Stripping
Zone of Future Stripping
Plan of Northern Section of Pit
Scale 1" = 100'

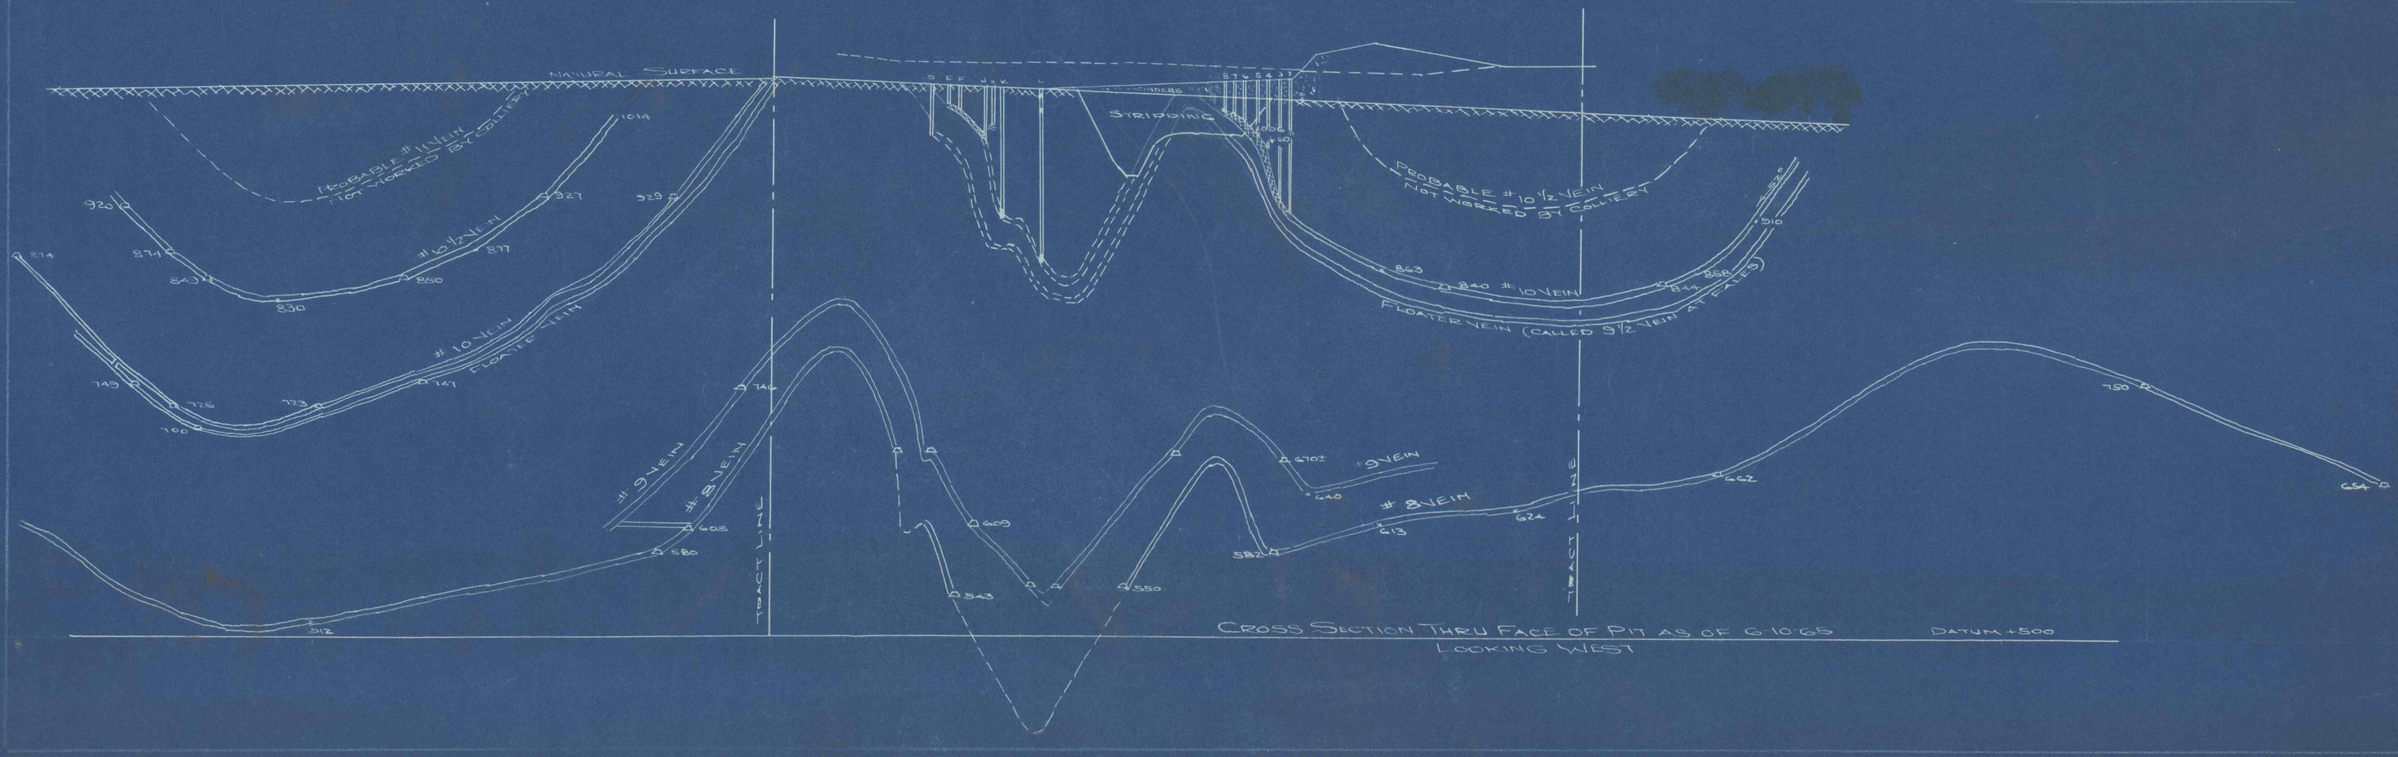
Natural Surface
Stripping
Probable #11 Vein Not Worked by Gallery
#10½ Vein
#10 Vein
Floater Vein
Probable #10½ Vein Not Worked by Gallery
#10 Vein
Floater Vein (Called 9½ Vein at Times)
#9 Vein
#8 Vein
Tract Line
Tract Line
Datum +500
Cross Section Thru Face of Pit as of 6-10-65
Looking West