



DANCOT WORKINGS APRIL 1957

SECTION THRU LYKENS VALLEY NOS 4 & 5 VEIN SLOPE

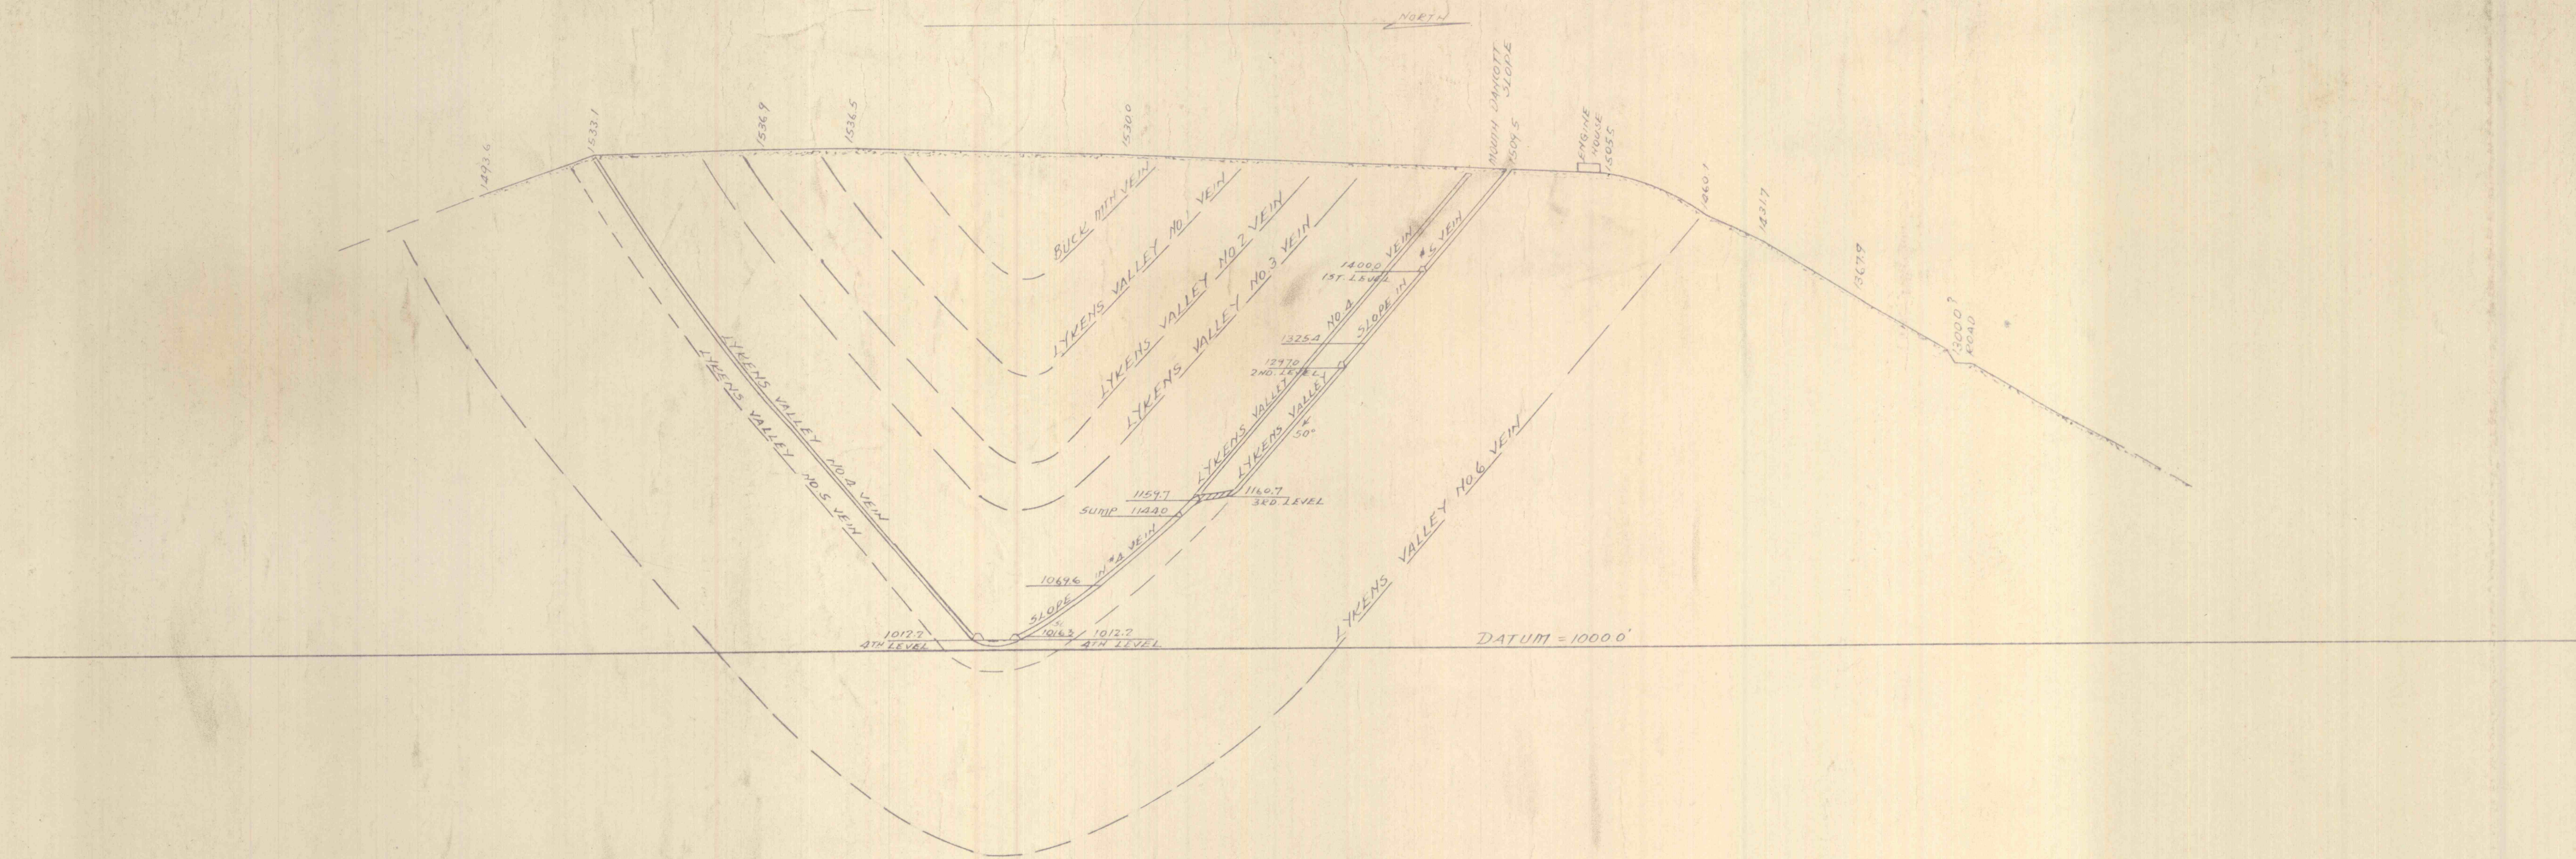

SECTION THRU NO. 17 BREAST S.DIP AND NO. 19 BREAST N.DIP (600' EAST OF SLOPE)

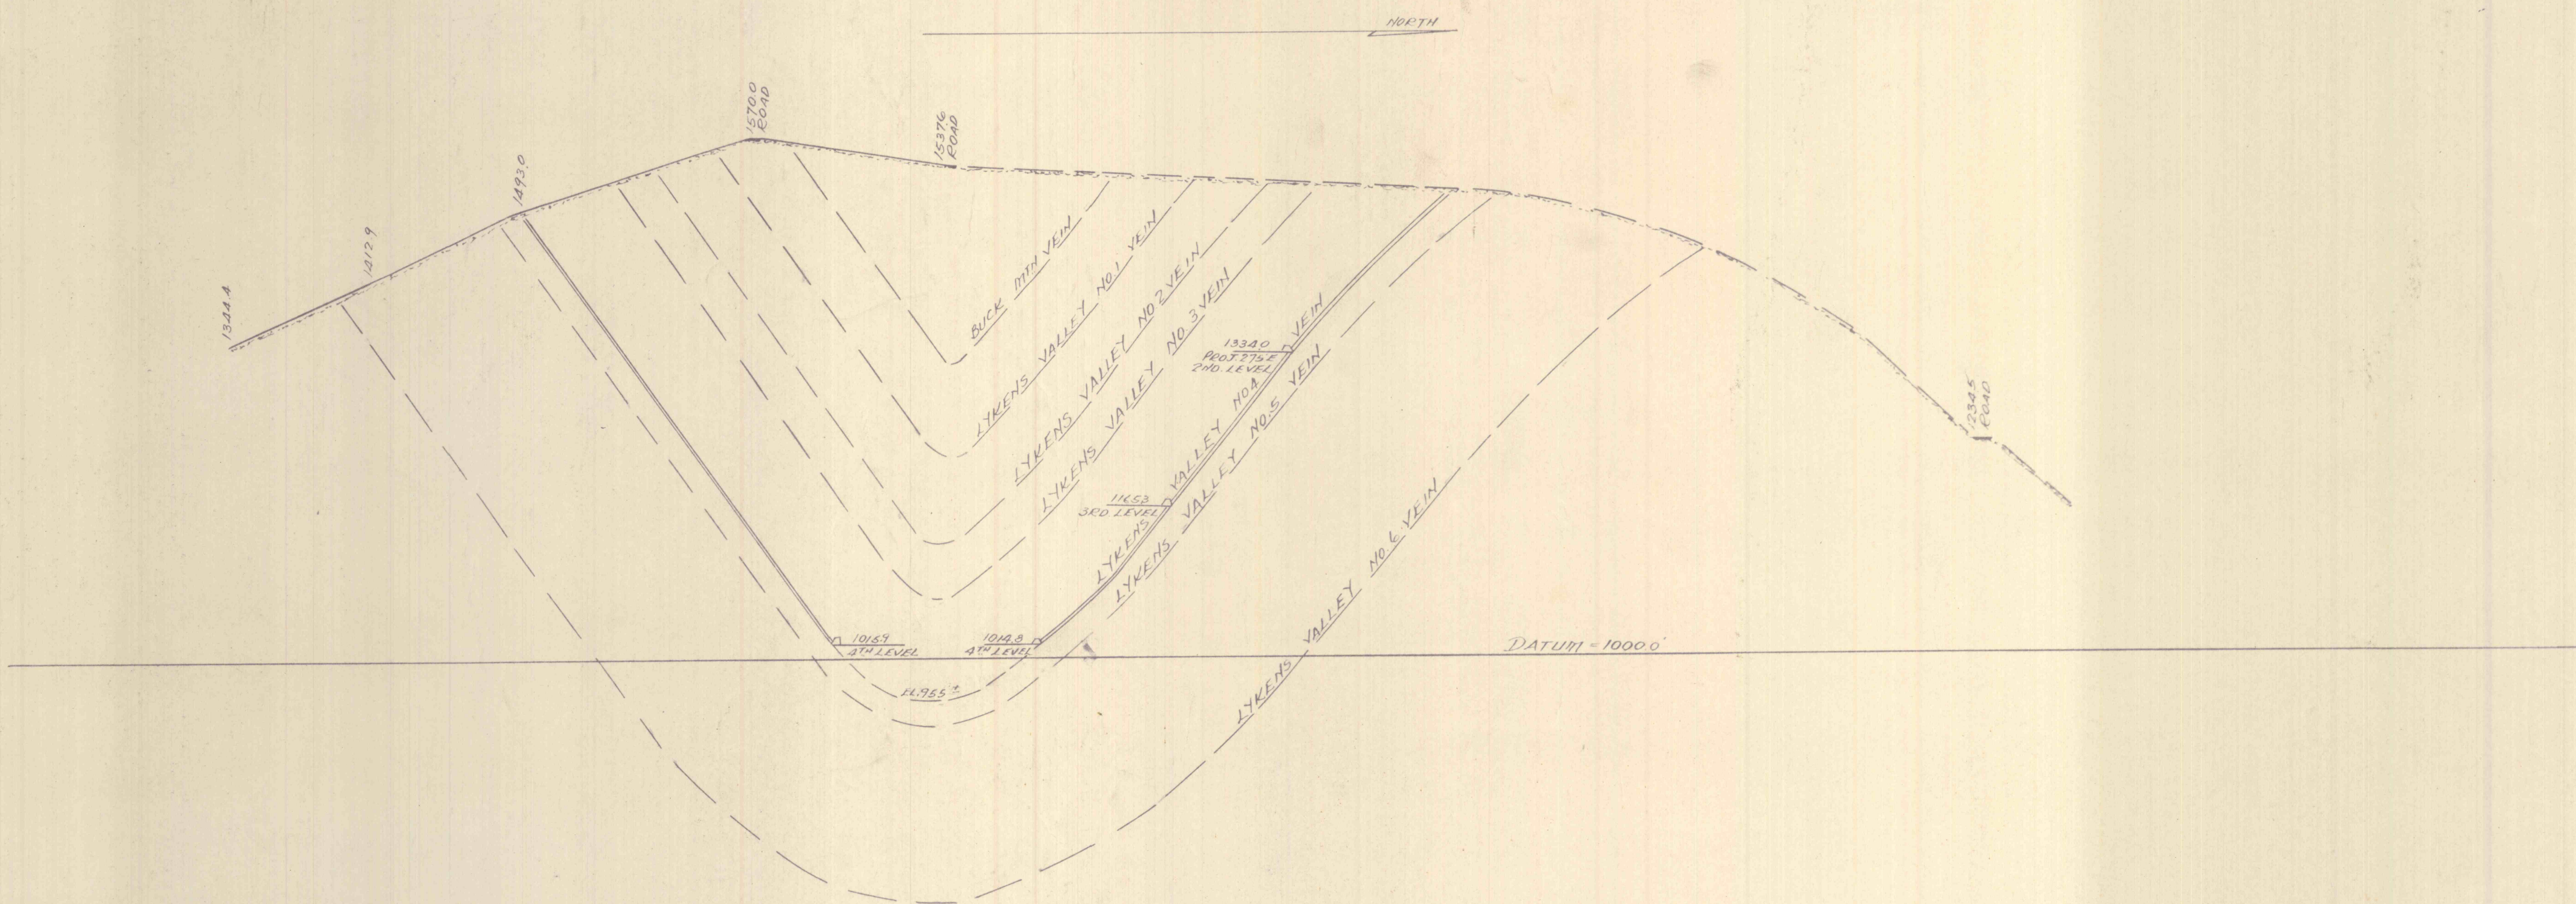

SECTION THRU #33 BREAST S.DIP 4TH LEVEL 1200' EAST OF SLOPE

