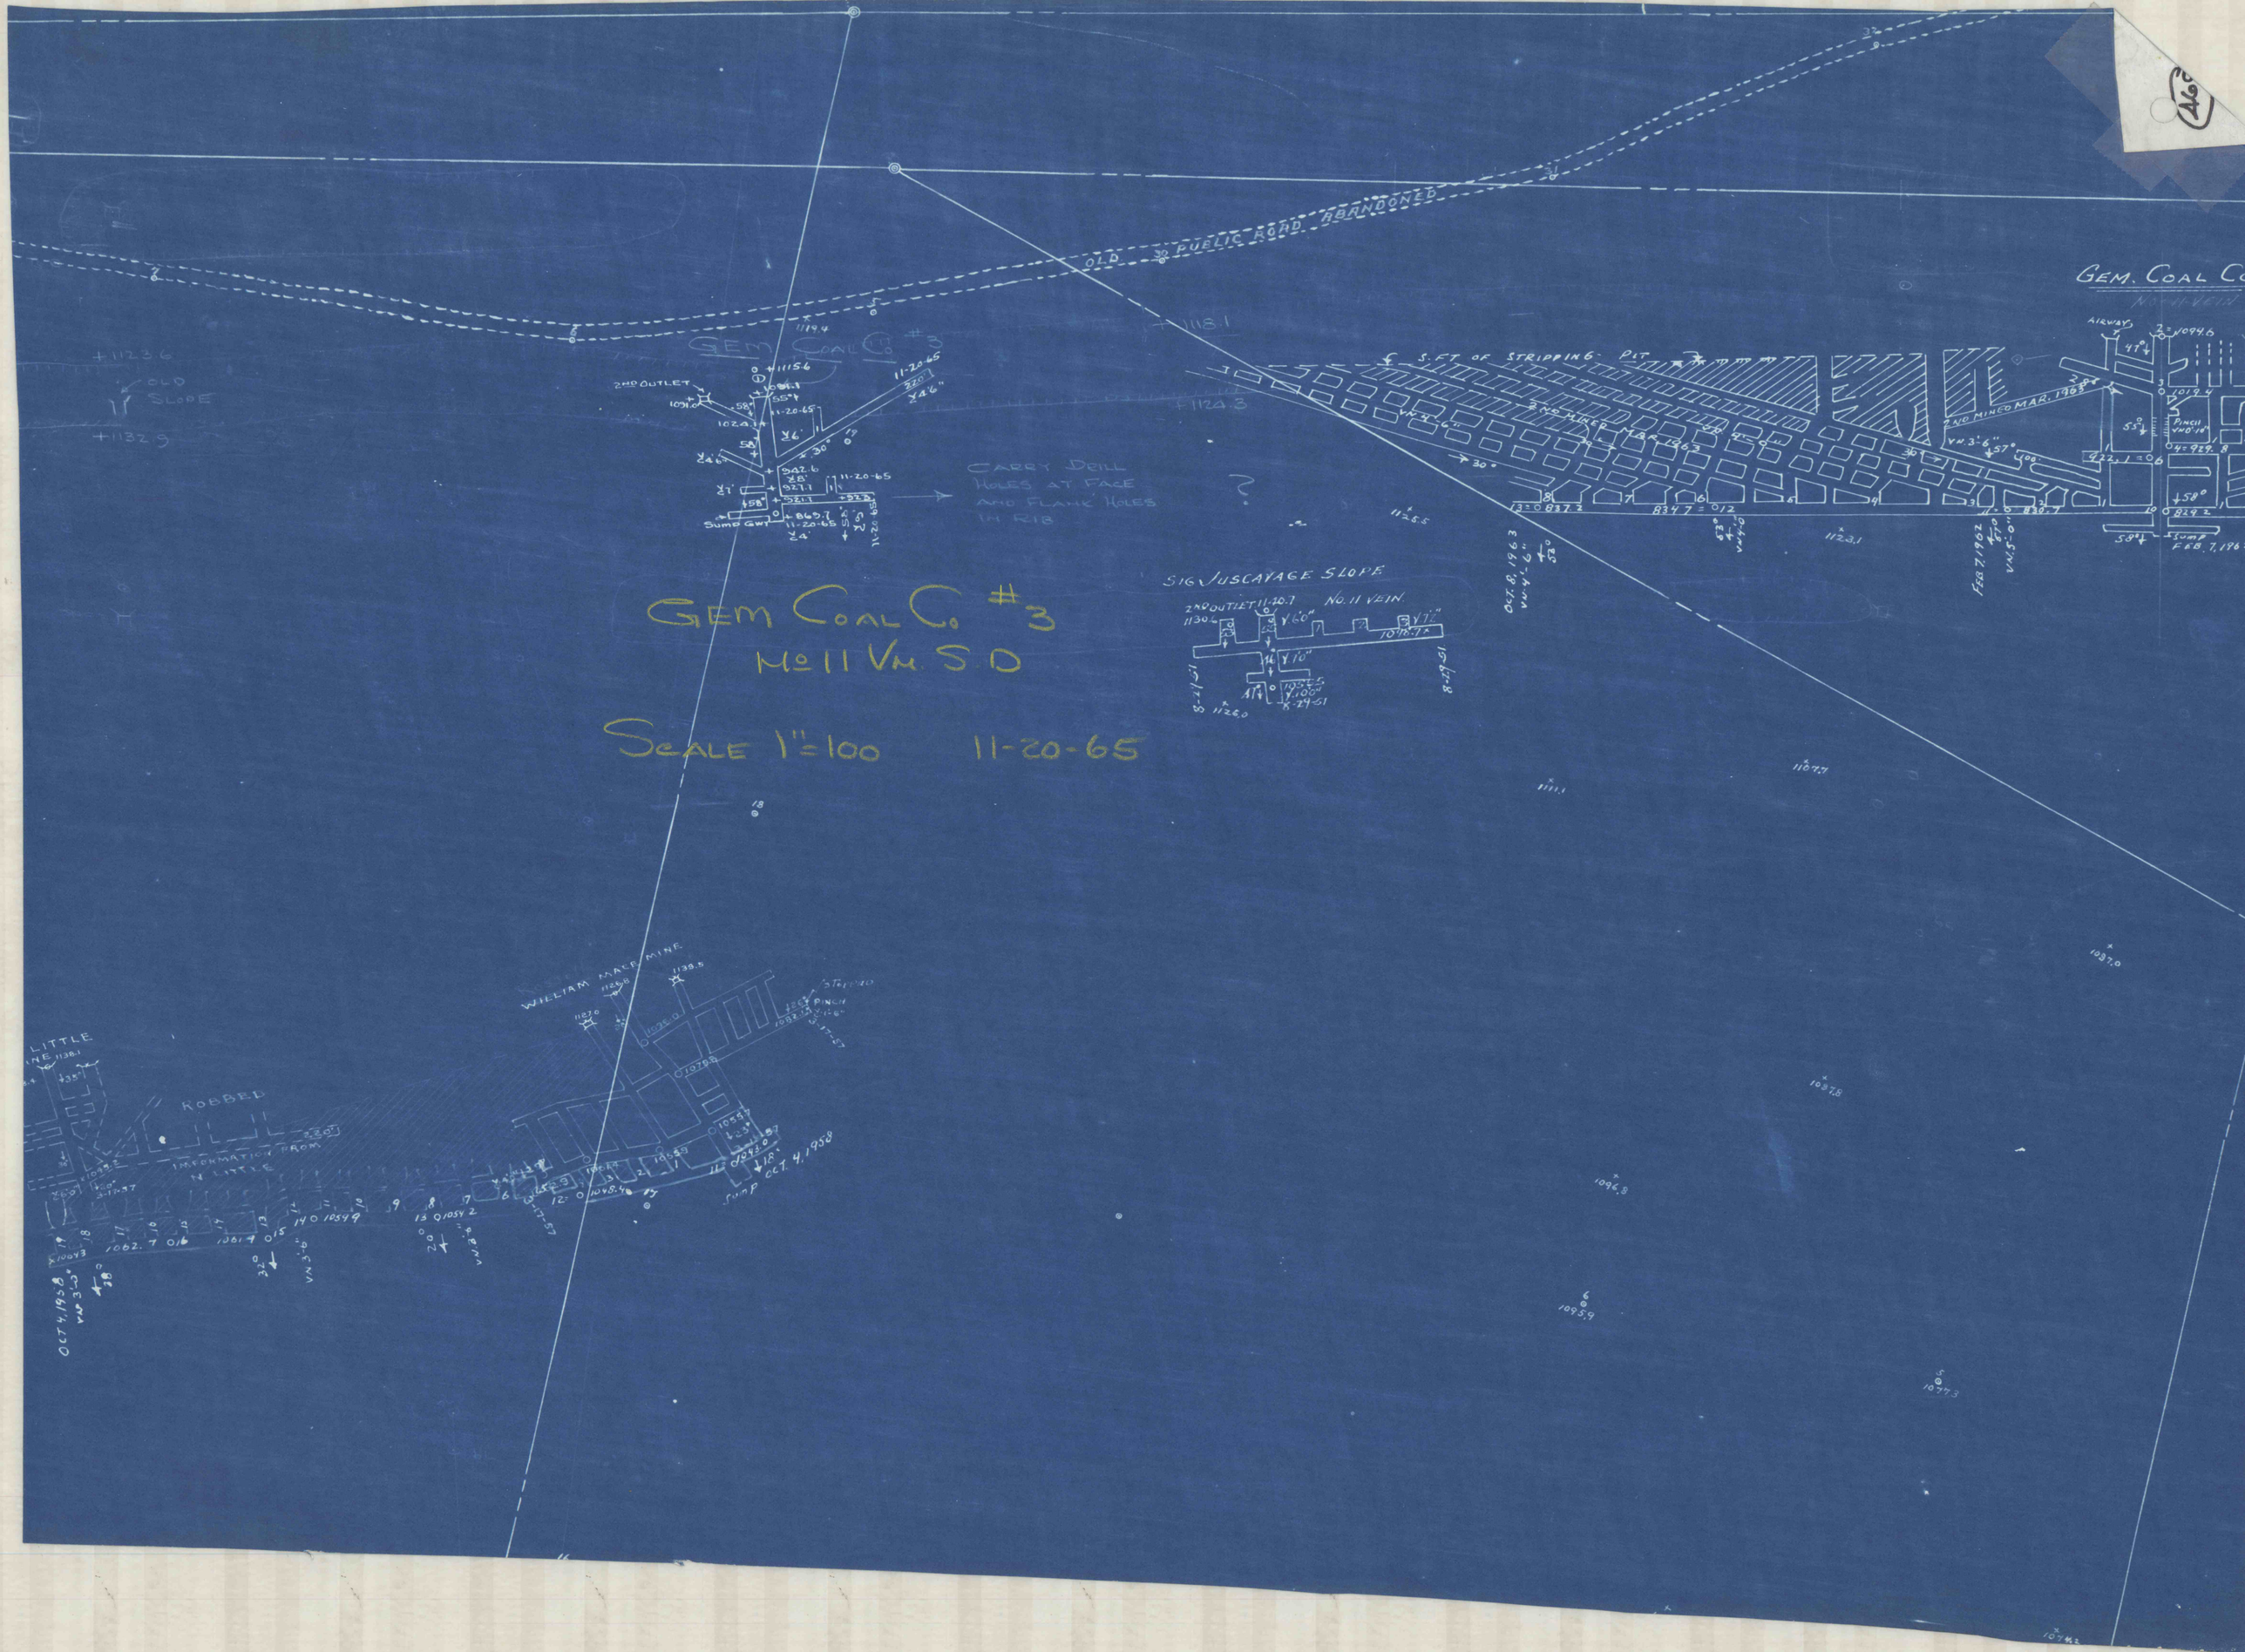
GEM COAL CO #3
No 11 VEIN S.D
SCALE 1" = 100
11-20-65
OLD PUBLIC ROAD ABANDONED
GEM COAL CO #3
2ND OUTLET
SUMP GWY
CARRY DRILL HOLES AT FACE AND FLANK HOLES IN RIB
SIG JUSCAVAGE SLOPE
2ND OUTLET 11-20-7
NO. 11 VEIN
S. FT OF STRIPPING PIT
2ND MINED MAR. 1963
AIRWAYS
PINCH
SUMP FEB. 7, 1962
OCT. 8, 1963
WILLIAM MACE MINE
ROBBED
INFORMATION FROM N. LITTLE
OCT 4, 1958
SUMP OCT. 4, 1958