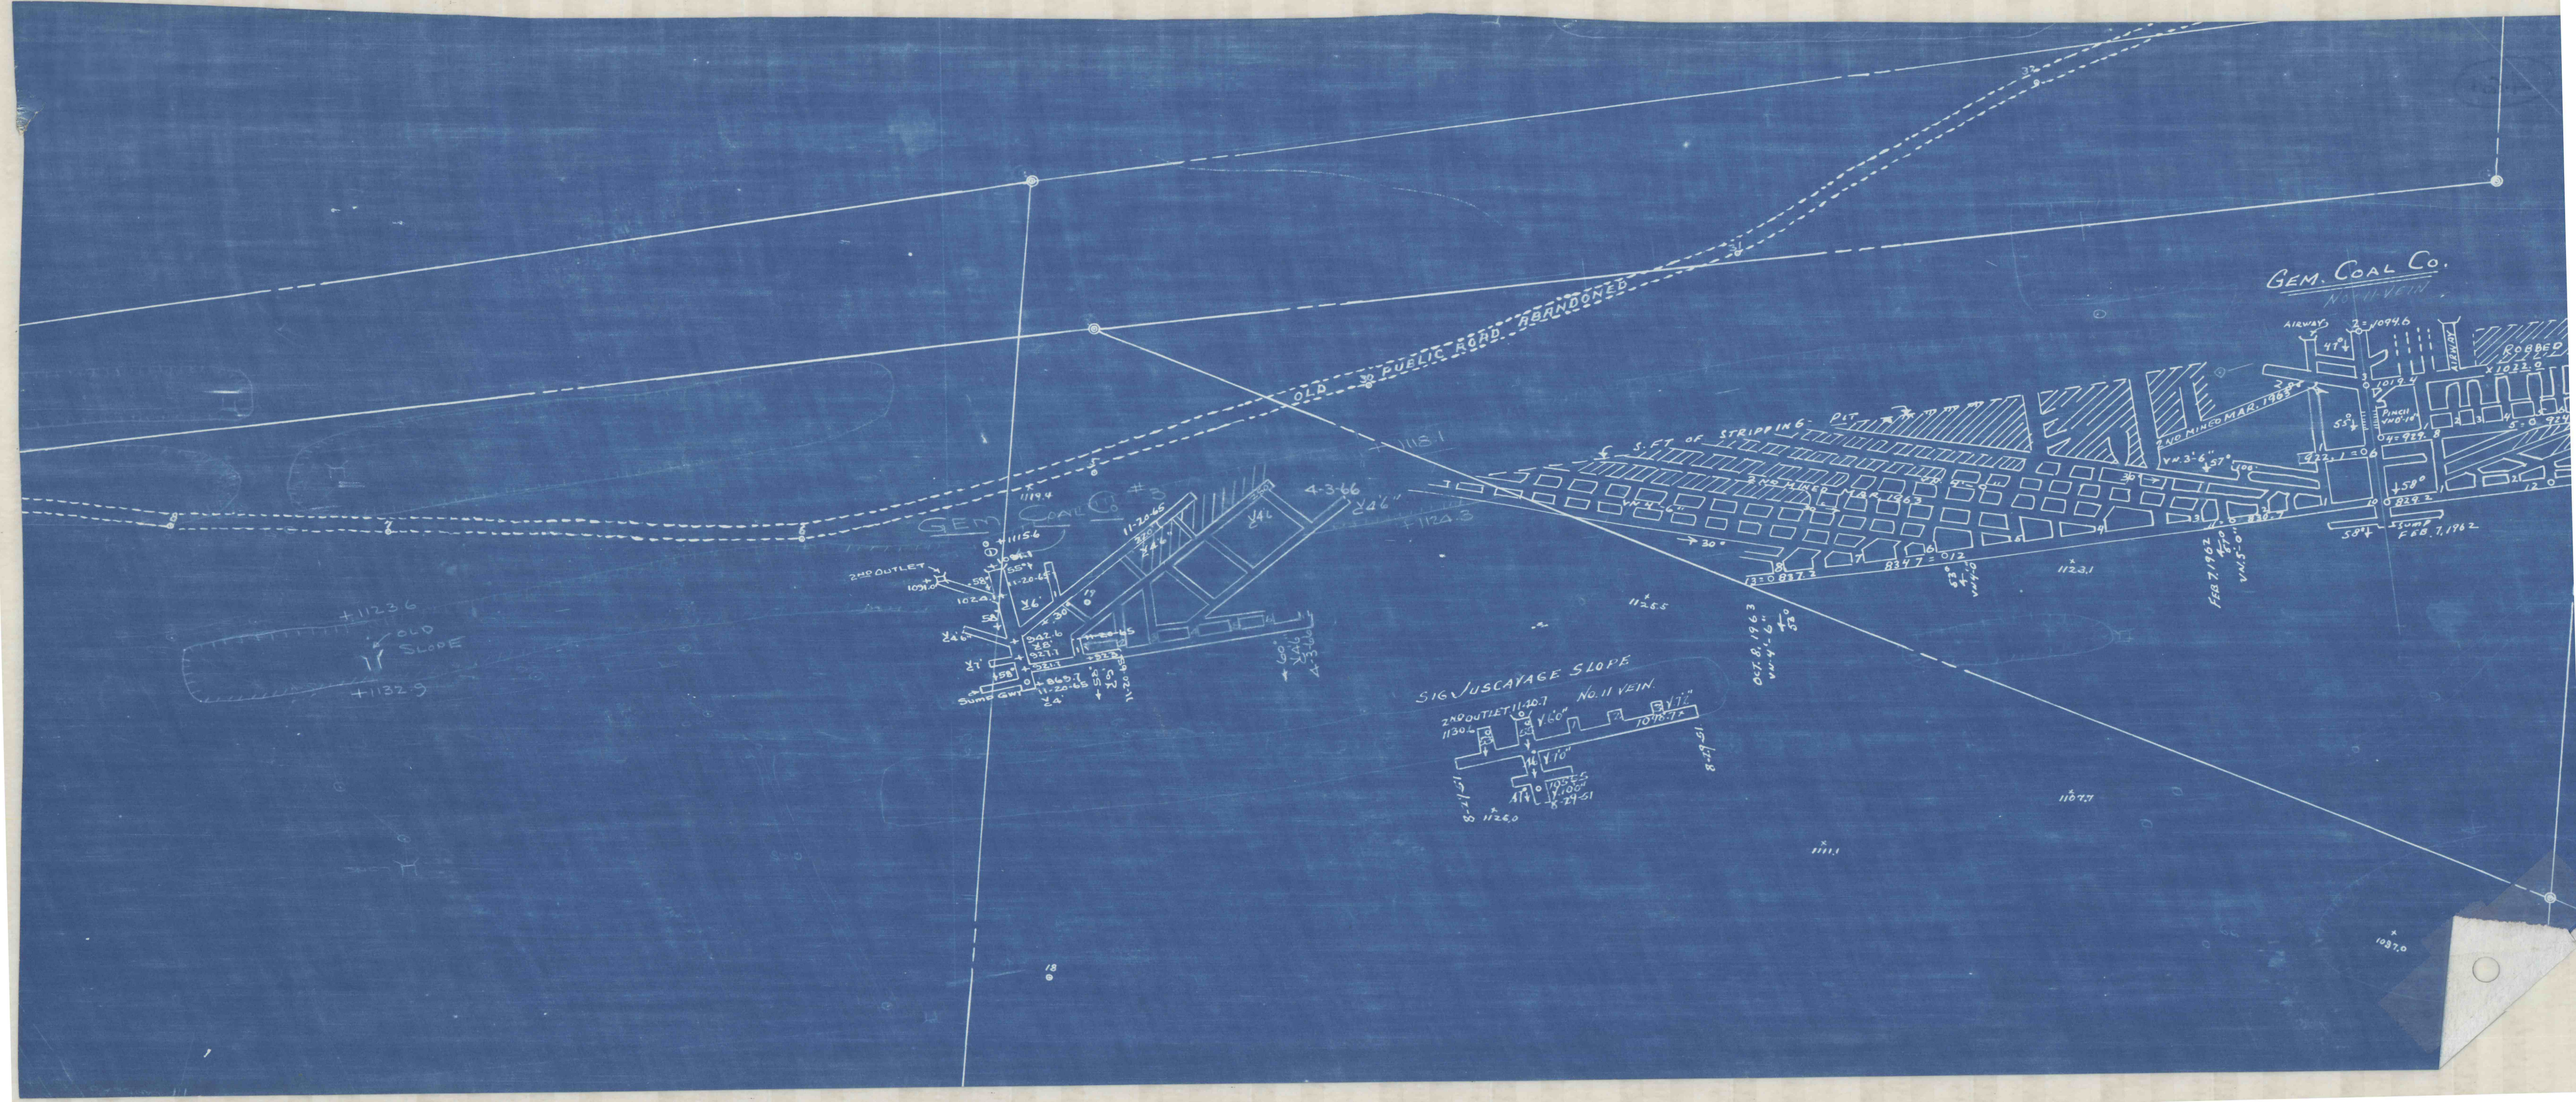
GEM. COAL CO.
NORTH VEIN
OLD PUBLIC ROAD ABANDONED
5 FT. OF STRIPPING PIT
2ND OUTLET
SIG/USCAYAGE SLOPE
No. 11 VEIN
AIRWAY
ROBBED
SUMP
+1123.6
OLD SLOPE
+1122.9
+1124.3
+1118.1
+1126.5
+1123.1
+1107.7
+1111.1
+1087.0