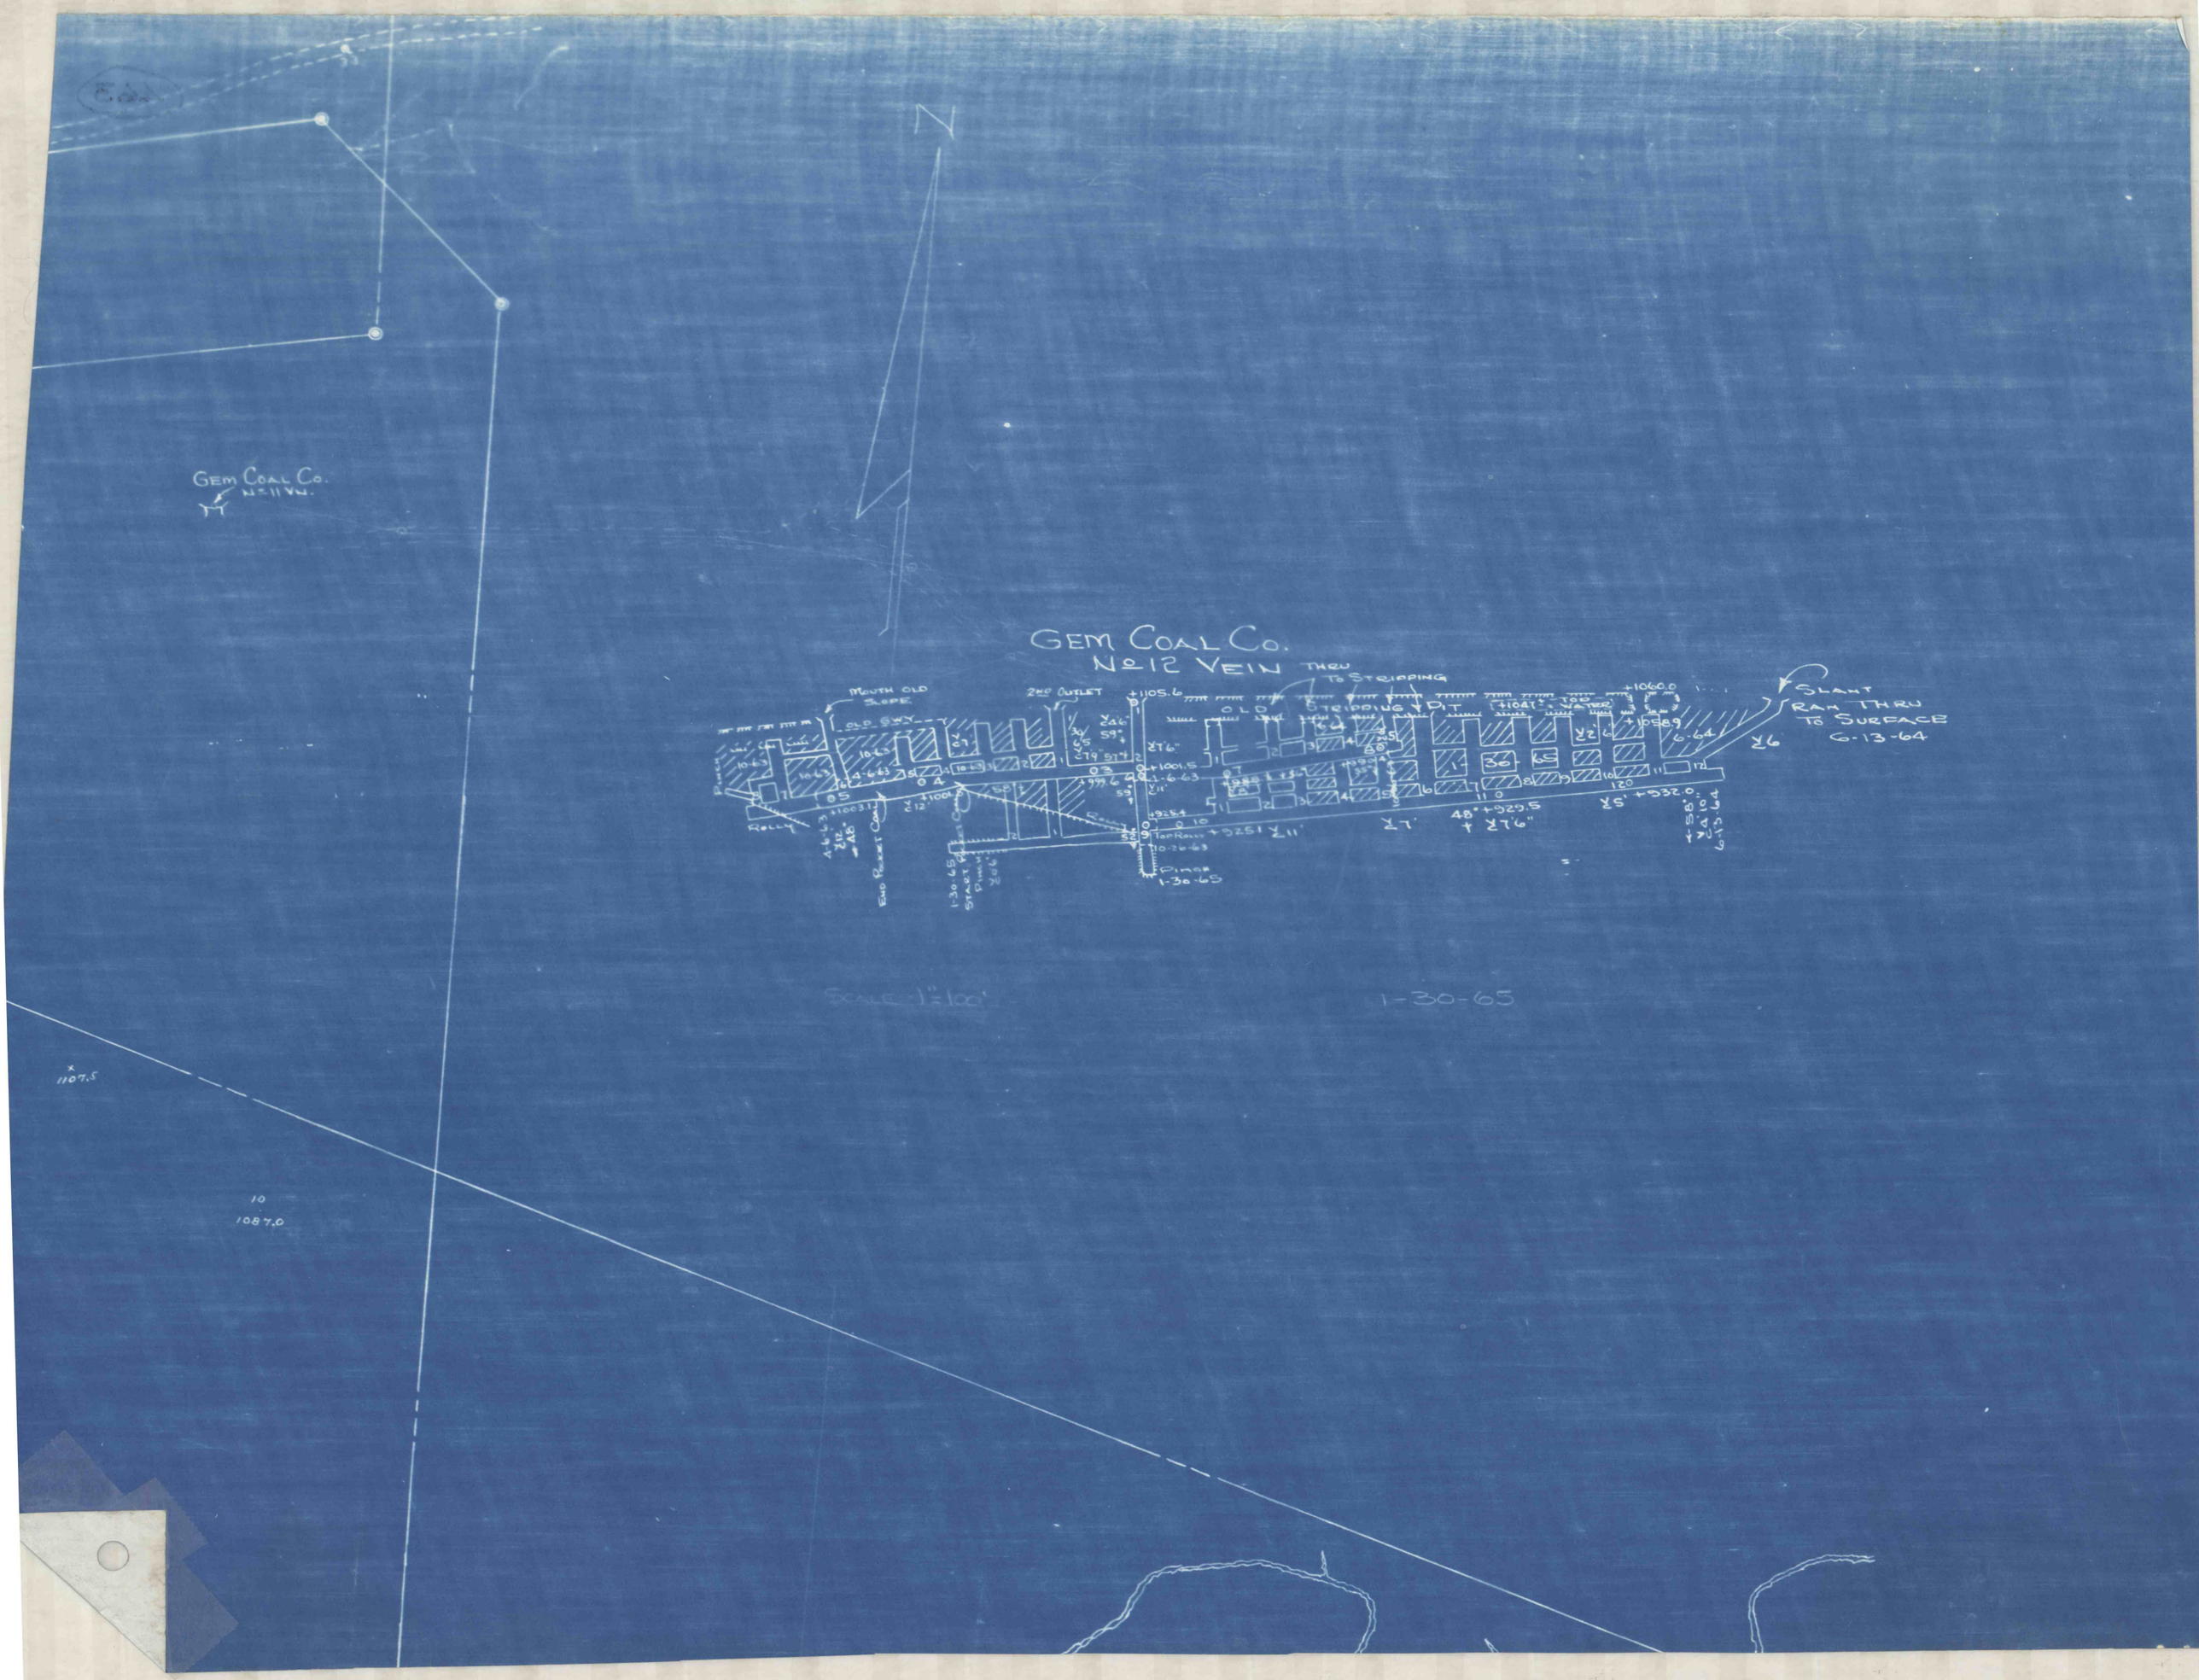

GEM COAL CO.
No 11 VN.
GEM COAL CO.
No 12 VEIN
THRU TO STRIPPING
MOUTH OLD SLOPE
OLD SWY
2ND OUTLET
OLD STRIPPING PIT
SLANT RAN THRU TO SURFACE 6-13-64
ROLLY
END POCKET COAL
START POCKET COAL
PINCH
1-30-65
SCALE 1"=100'
1-30-65
1107.5
10
1087.0