


P24

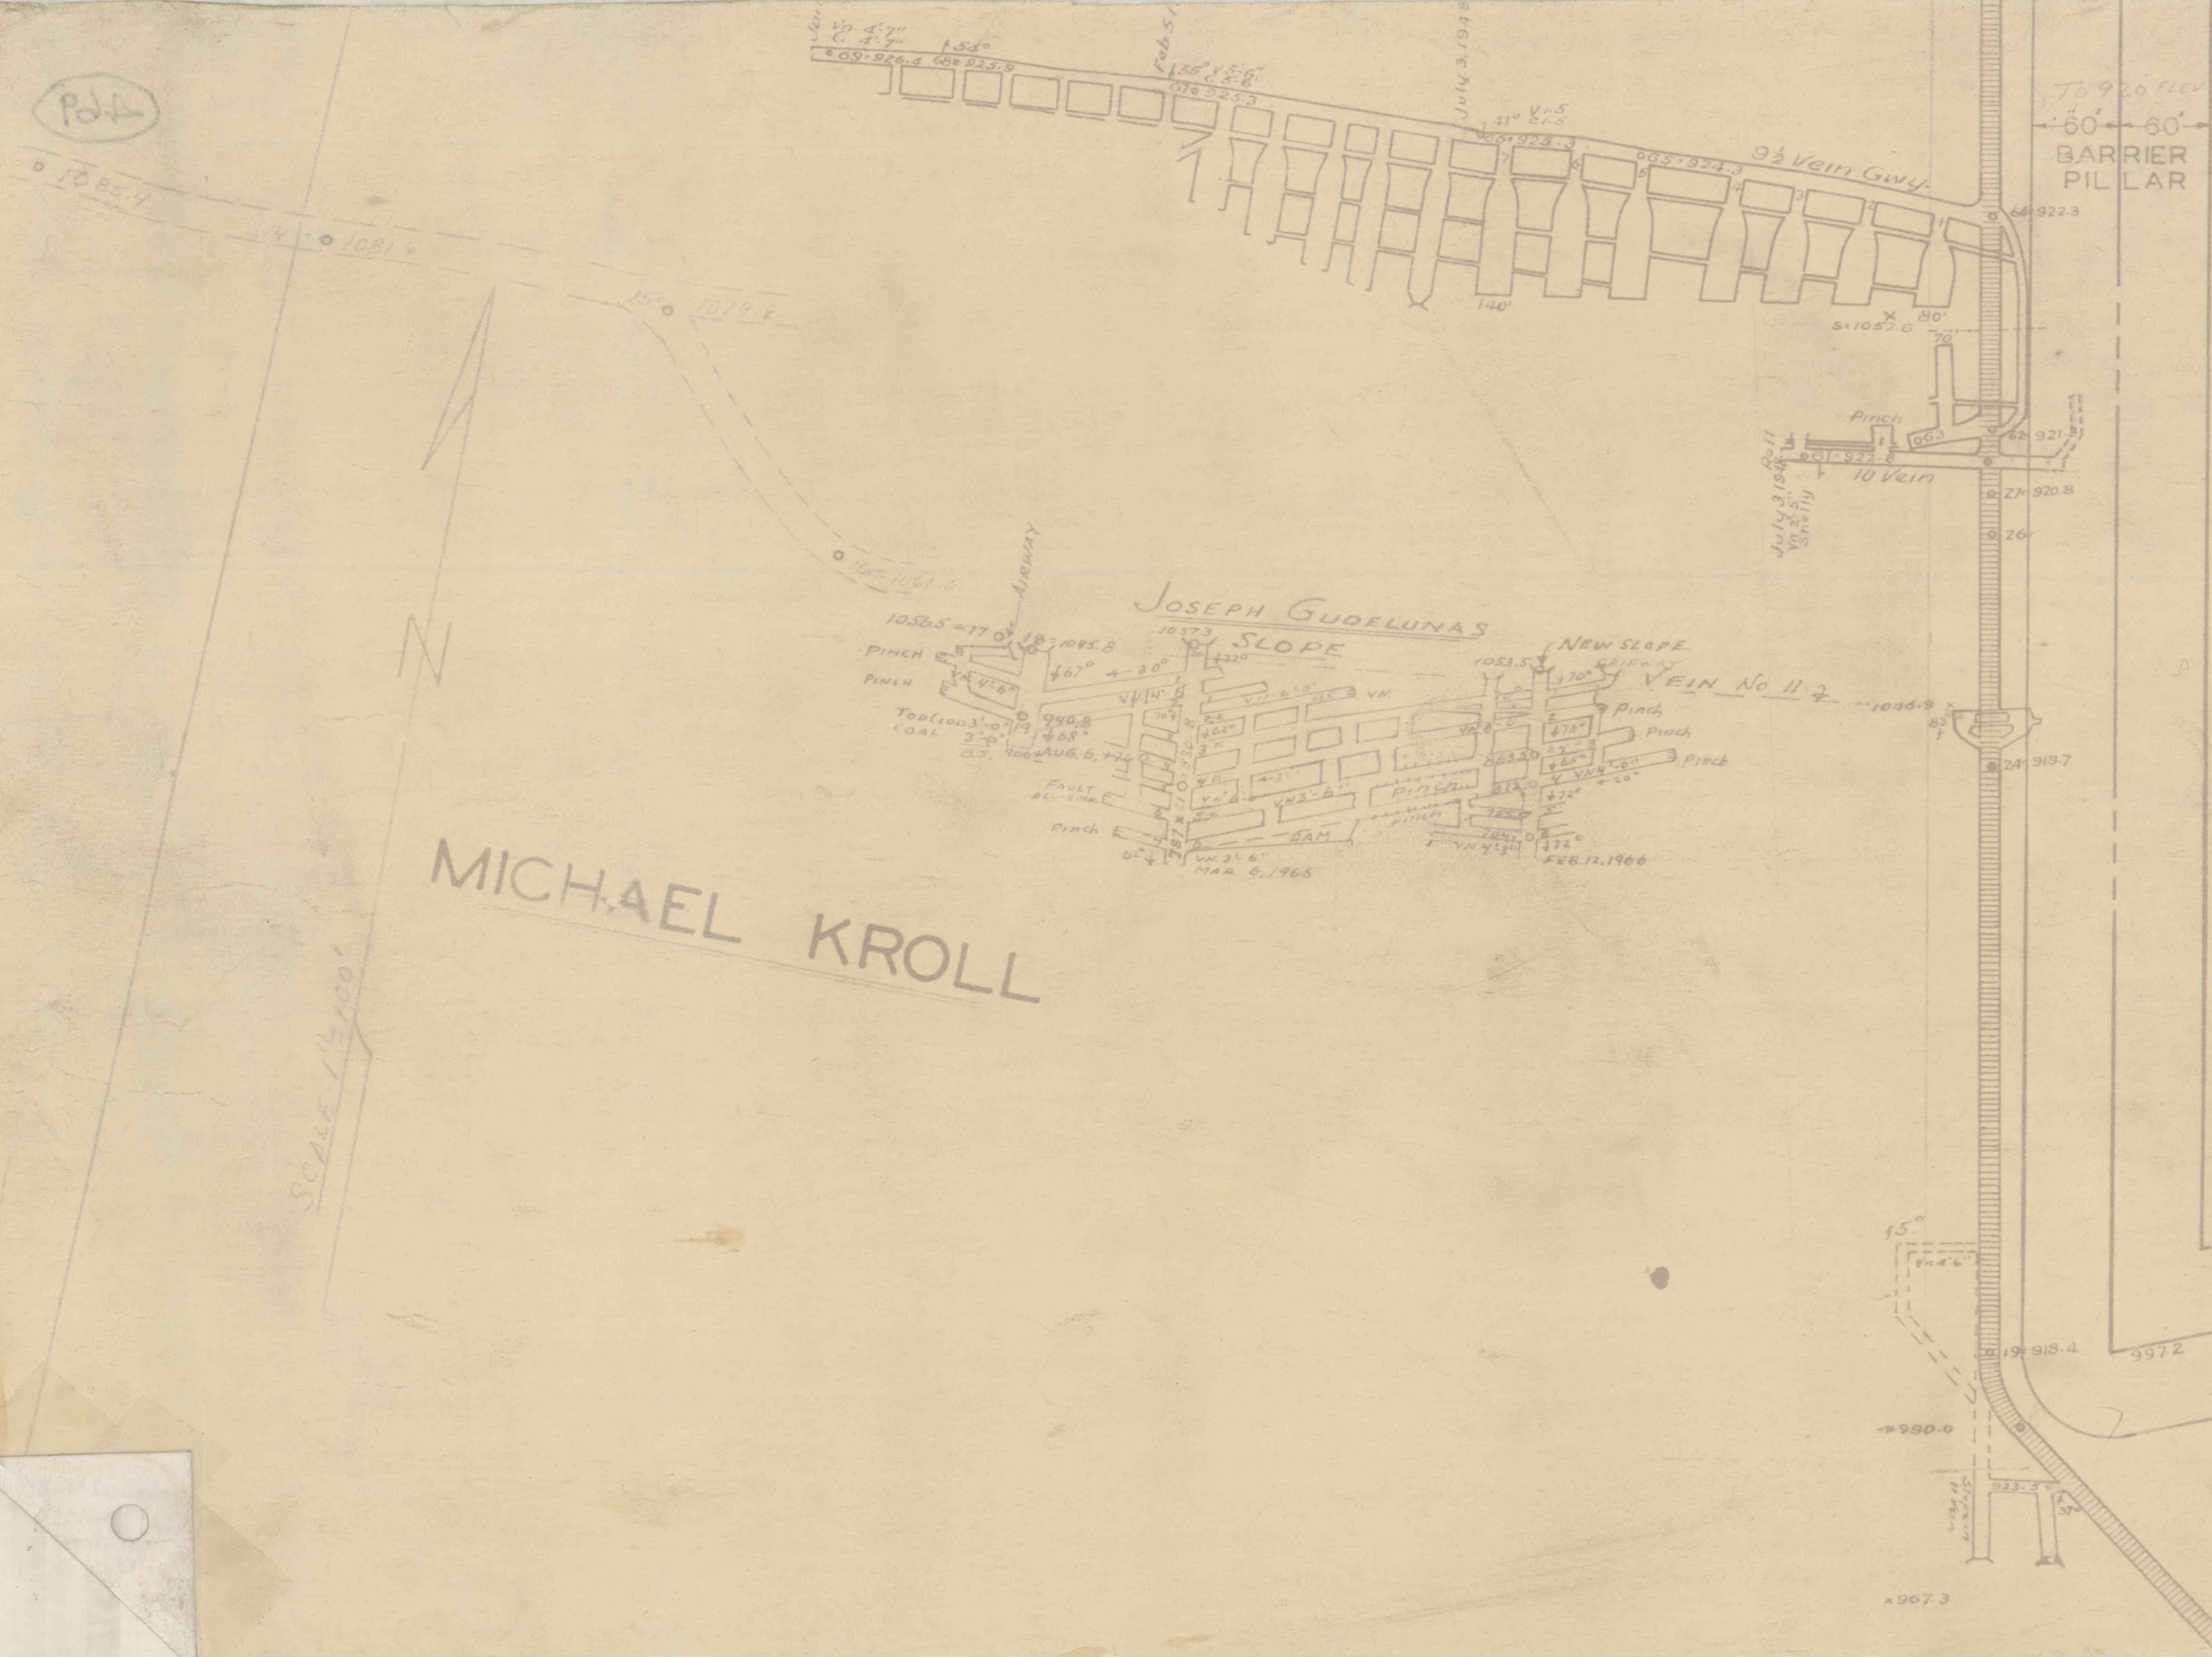

LEHIG

MICHAEL KROLL

SCALE 1"=100'