


30' SOUTH of STOP-STAIRS
70 to 75' West of W. side BRUNO & PEIFER Gwy

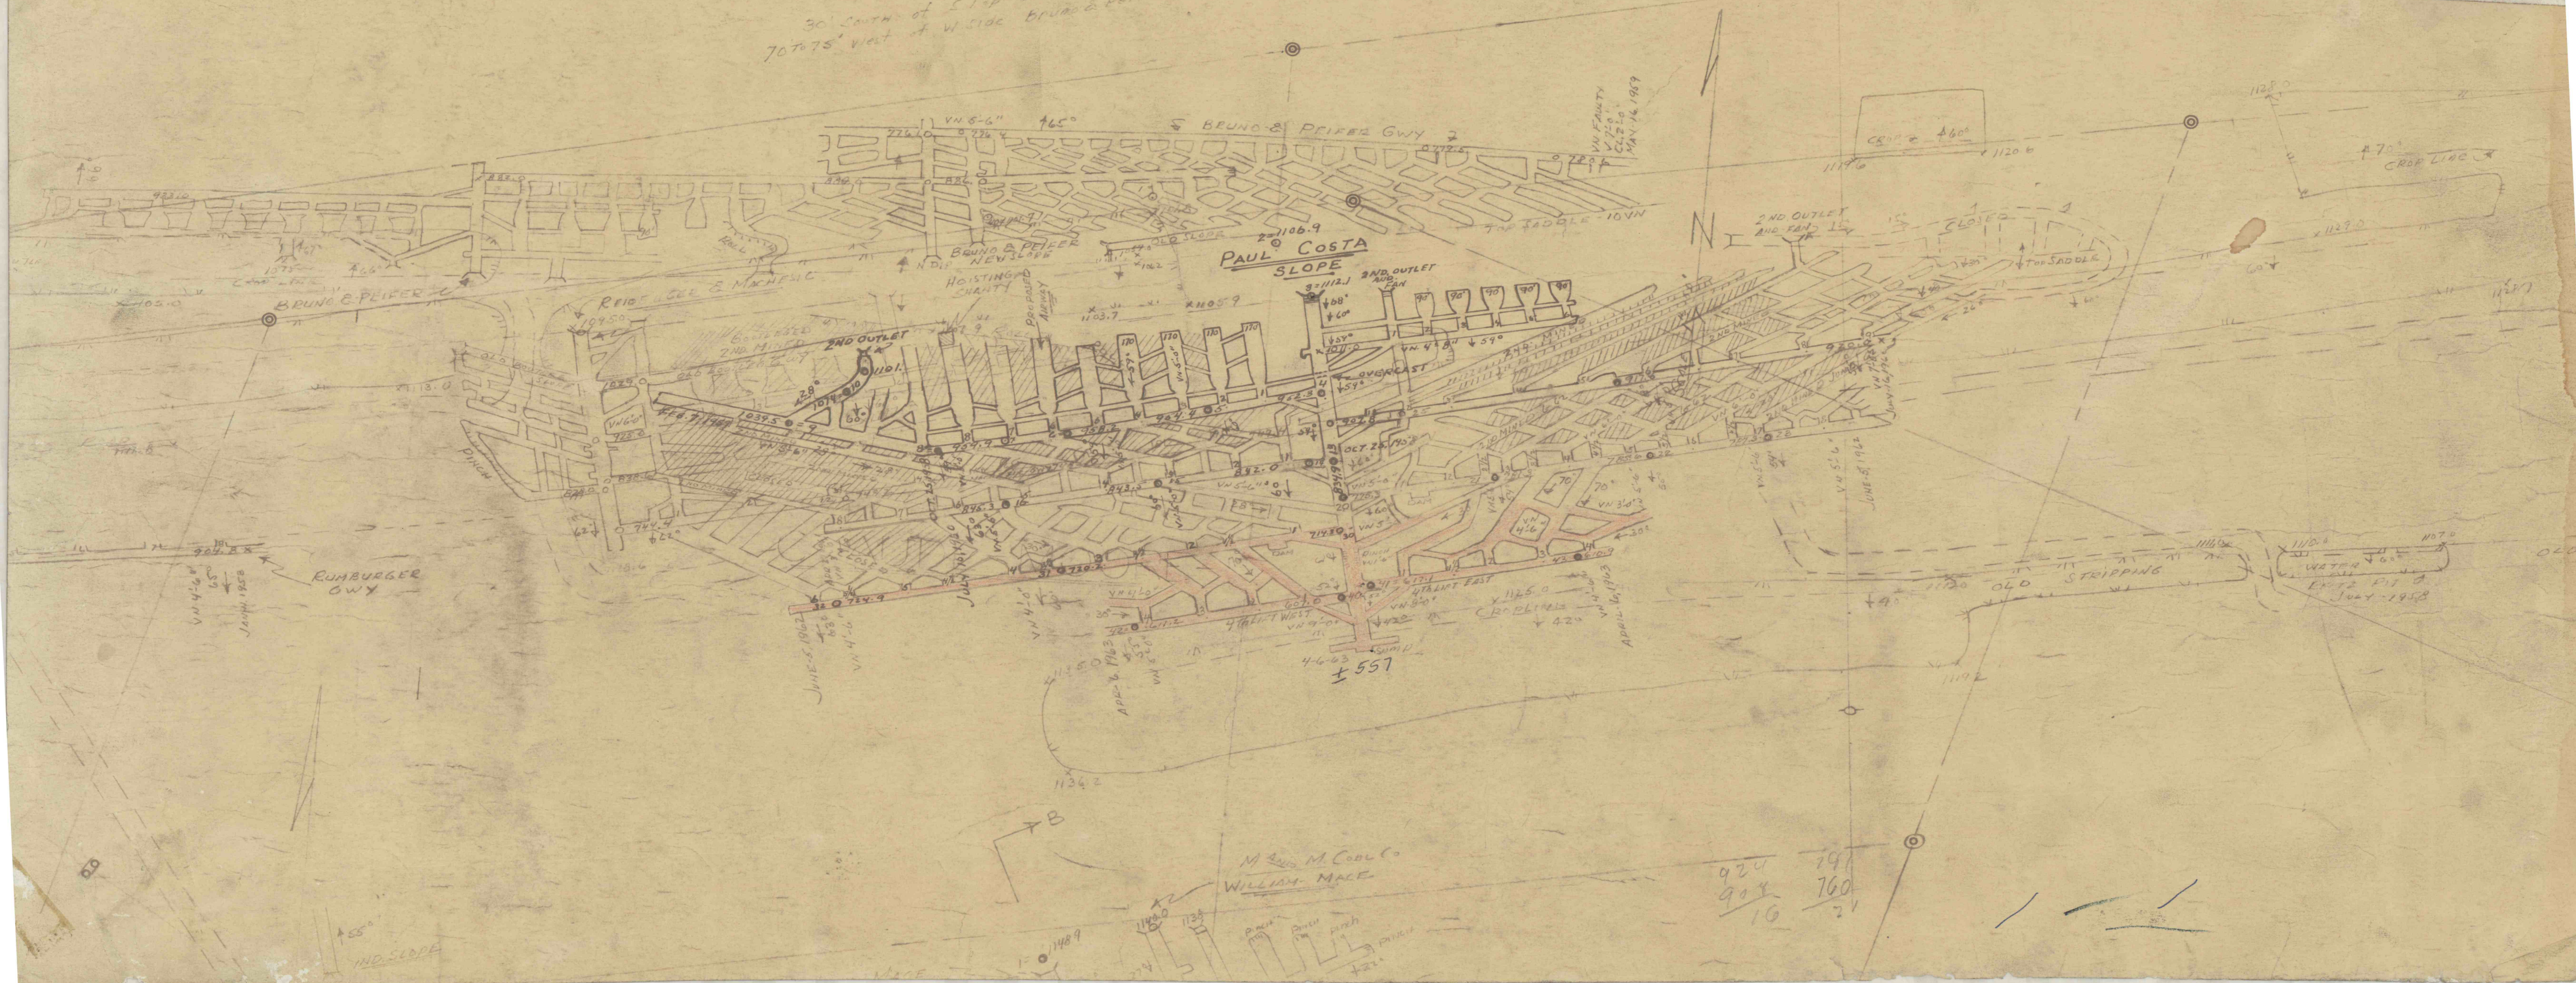

924
904
10

797
760
21

M. and M. COBLE Co
WILLIAM MACE

1-0-1489

IND. SLOPE

WATER
EXT. PIT
JULY 1958

OLD STRIPPING

CROP LINE

4-6-63

APRIL 6, 1962

JUNE 5, 1962

FEB 7, 1962

JAN 1958