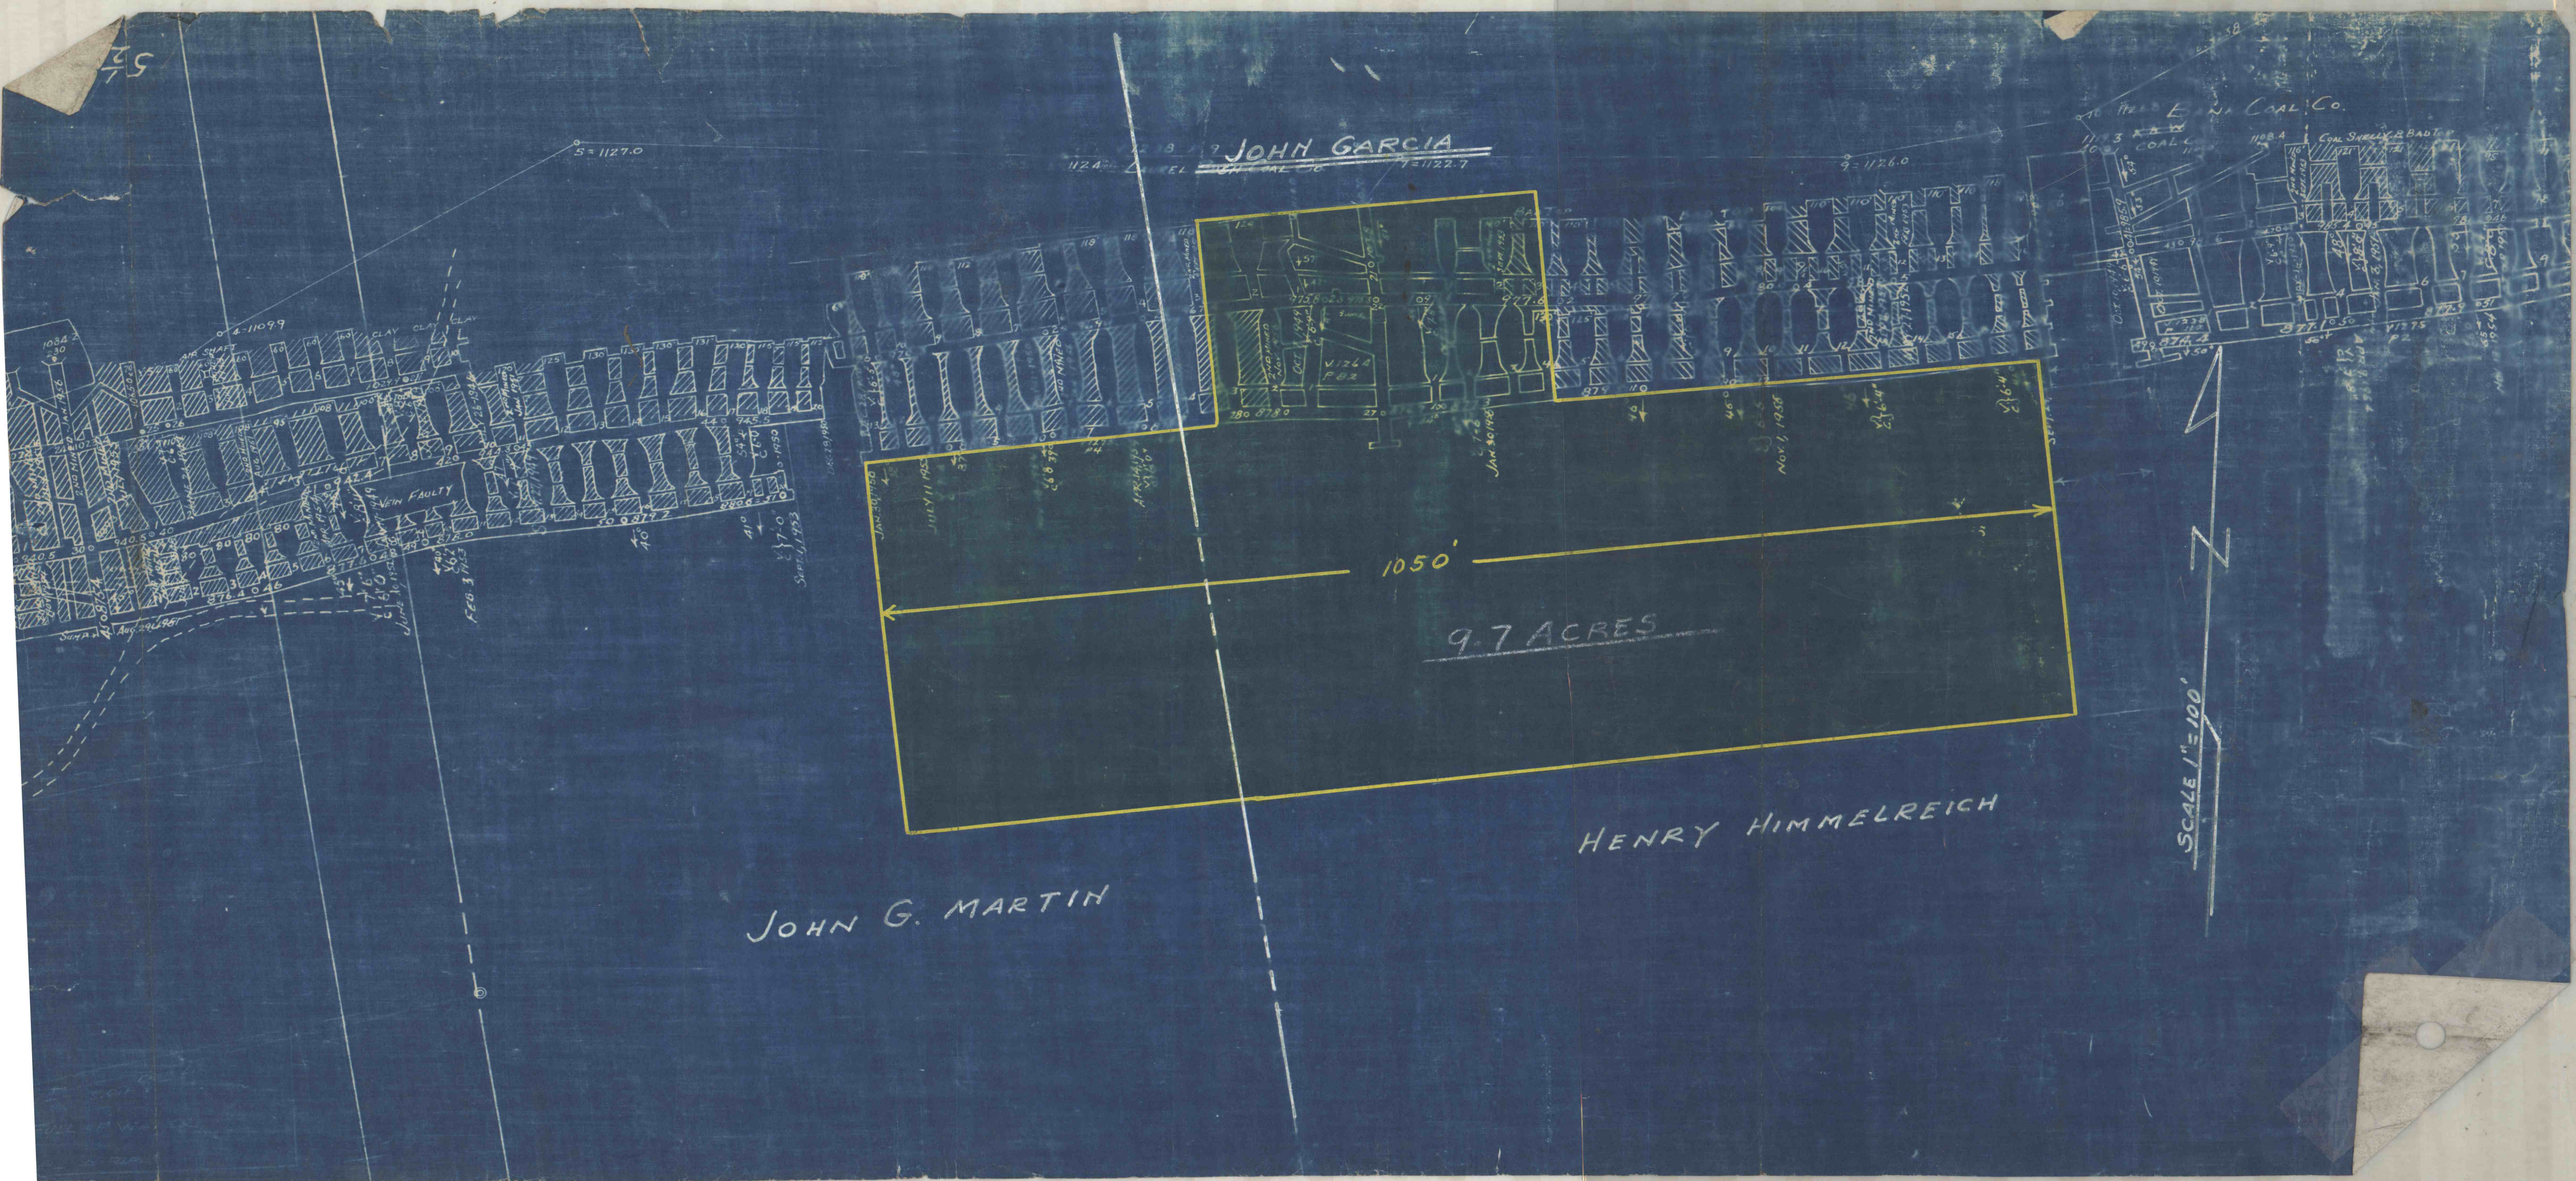
JOHN GARCIA
1050'
9.7 ACRES
JOHN G. MARTIN
HENRY HIMMELREICH
SCALE 1" = 100'
AIR SHAFT
CLAY
COAL
S = 1127.0
E = 1122.7
S = 1126.0