


JOHN G. MARTIN TRACT

JOHN BAILY TRACT

TREVORTON
NORTH FRANKLIN COAL
LANDS
ASSOCIATION

P. & L. 66 K.V. LINE

THE TOWNSHIP LANDS
DING ANTHRACITE

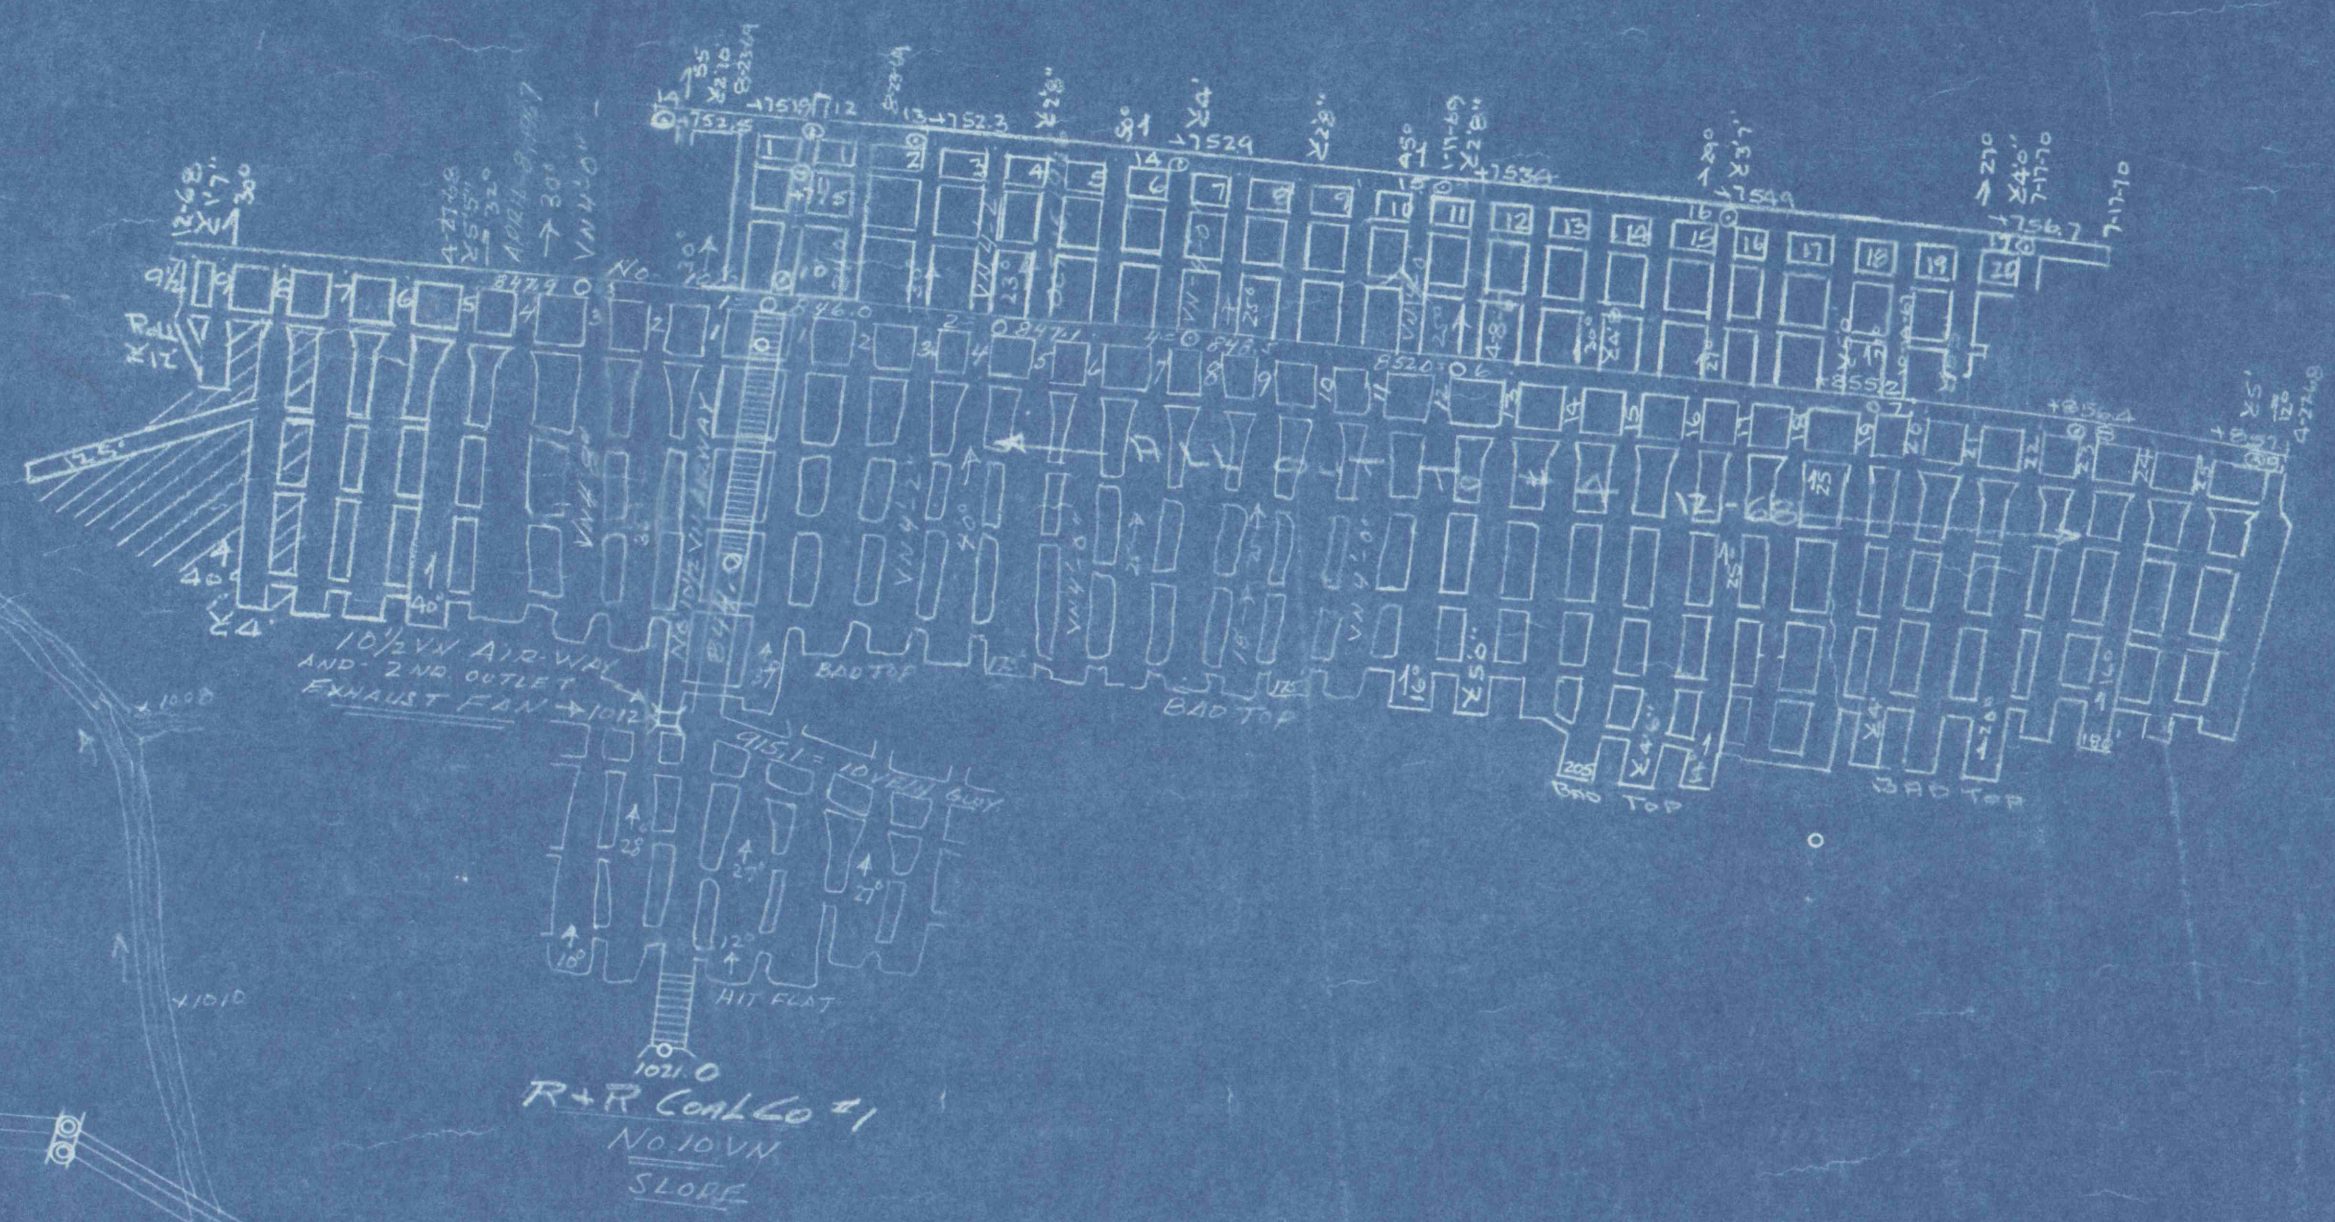

ROAD

SCALE 1"=100'