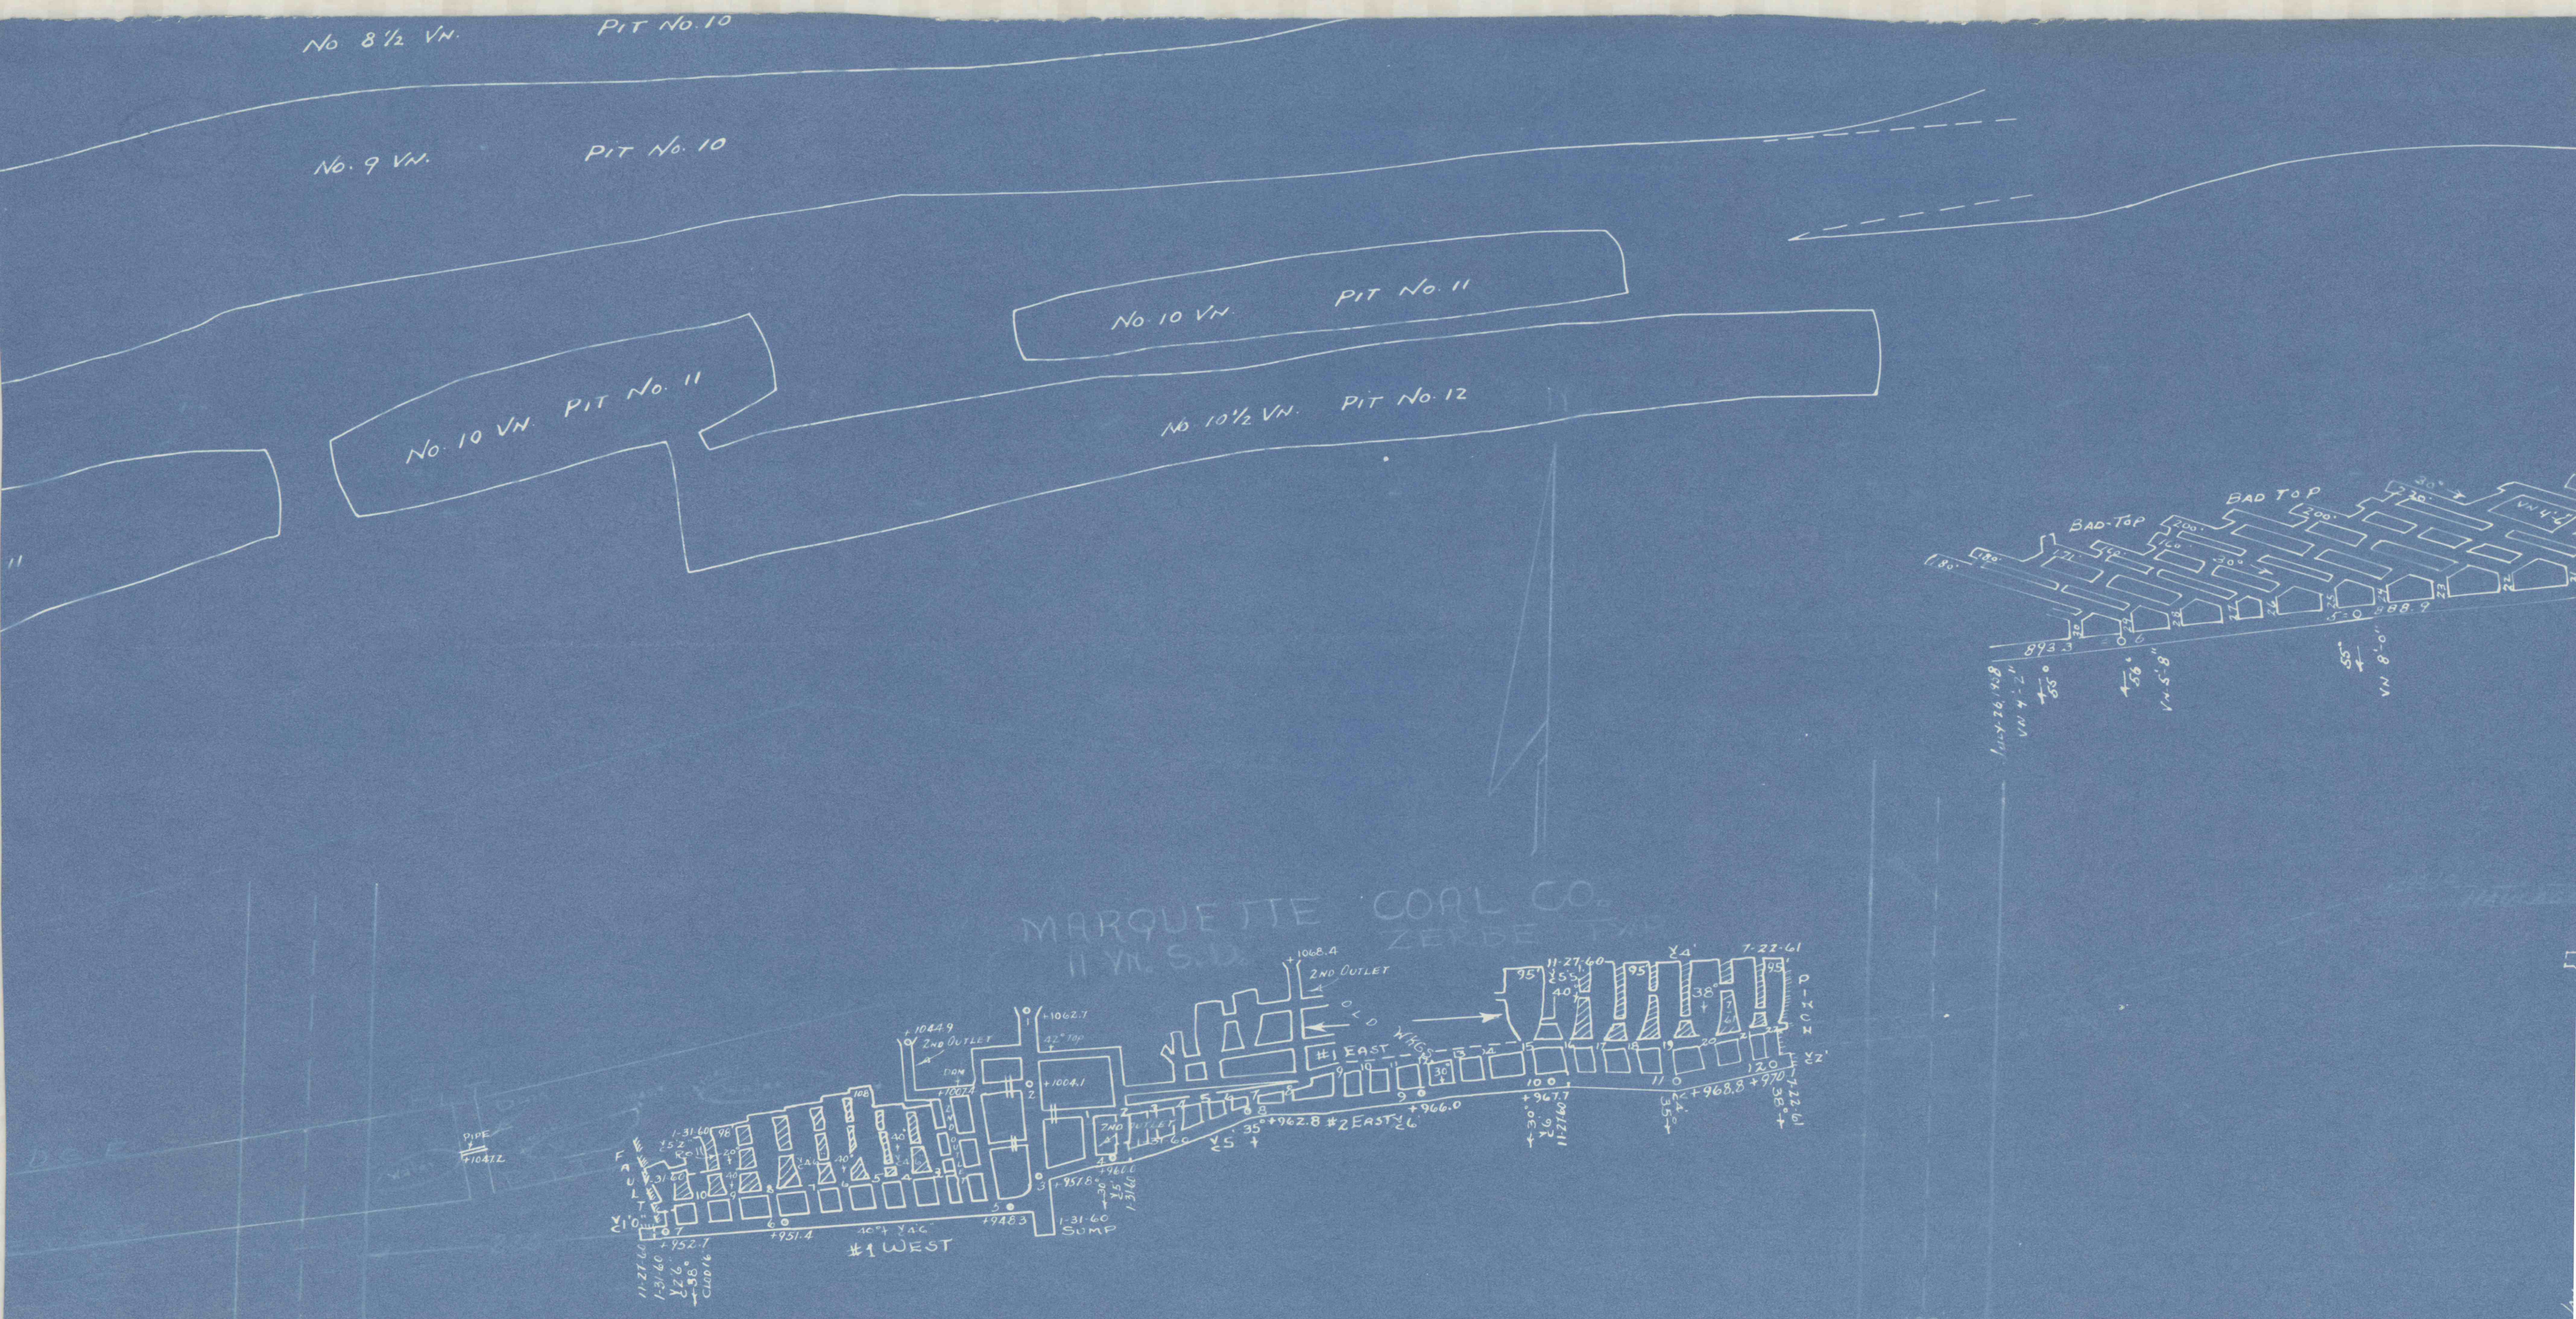
No 8 1/2 VN.
PIT No. 10
No. 9 VN.
PIT No. 10
No. 10 VN.
PIT No. 11
No. 10 VN.
PIT No. 11
No. 10 1/2 VN.
PIT No. 12
BAD TOP
BAD TOP
#1 EAST
#2 EAST
#1 WEST
SUMP
2ND OUTLET
PINCH
7-22-61
11-27-60
1-31-60