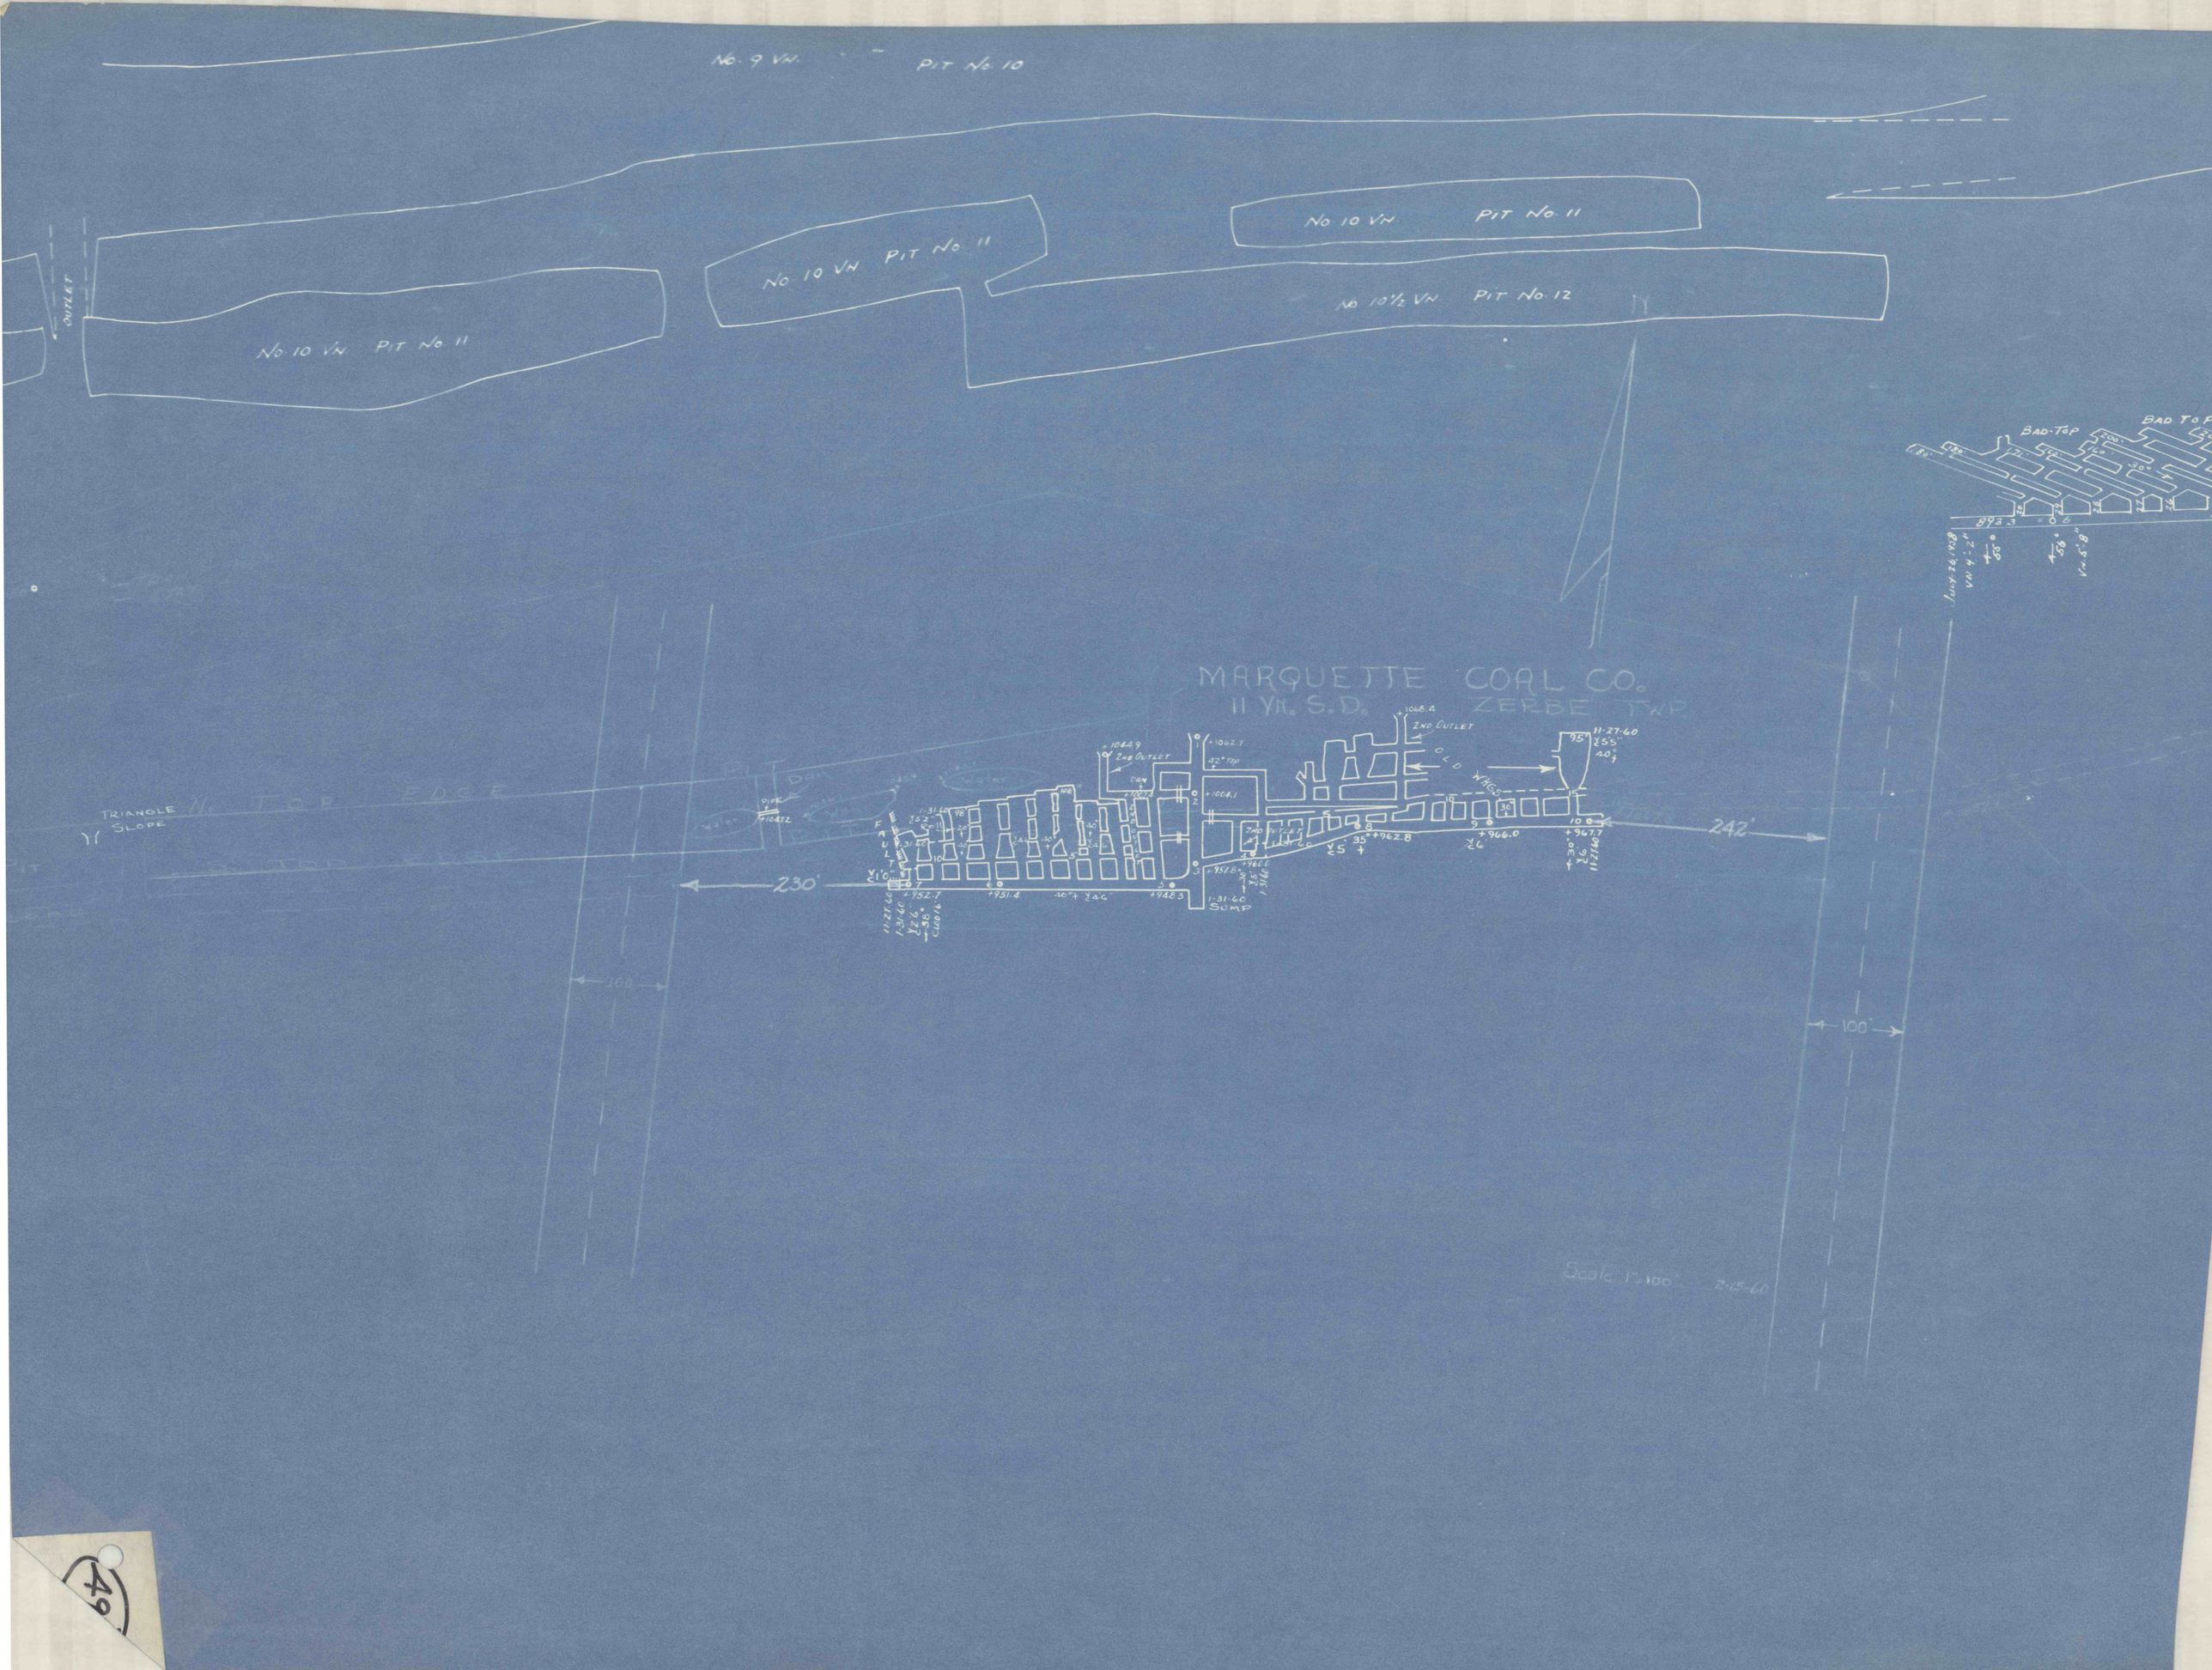
No. 9 VN.
PIT No. 10
No. 10 VN. PIT No. 11
No. 10 VN. PIT No. 11
No. 10 VN. PIT No. 11
No. 10½ VN. PIT No. 12
OUTLET
BAD TOP
MARQUETTE COAL CO.
11 VN. S.D.
ZERBE TWP.
TRIANGLE SLOPE
PIPE
+1047.2
+1068.4
2ND OUTLET
+1064.9
2ND OUTLET
+1062.7
42" TOP
+1064.1
OLD WORKS
11-27-60
95'
25'5"
40'
FAULT
230'
242'
+952.7
+951.4
+948.3
+951.8
+962.8
+966.0
+967.7
1-31-60
SUMP
100'
100'
Scale 1"=100'
2-15-60

49