


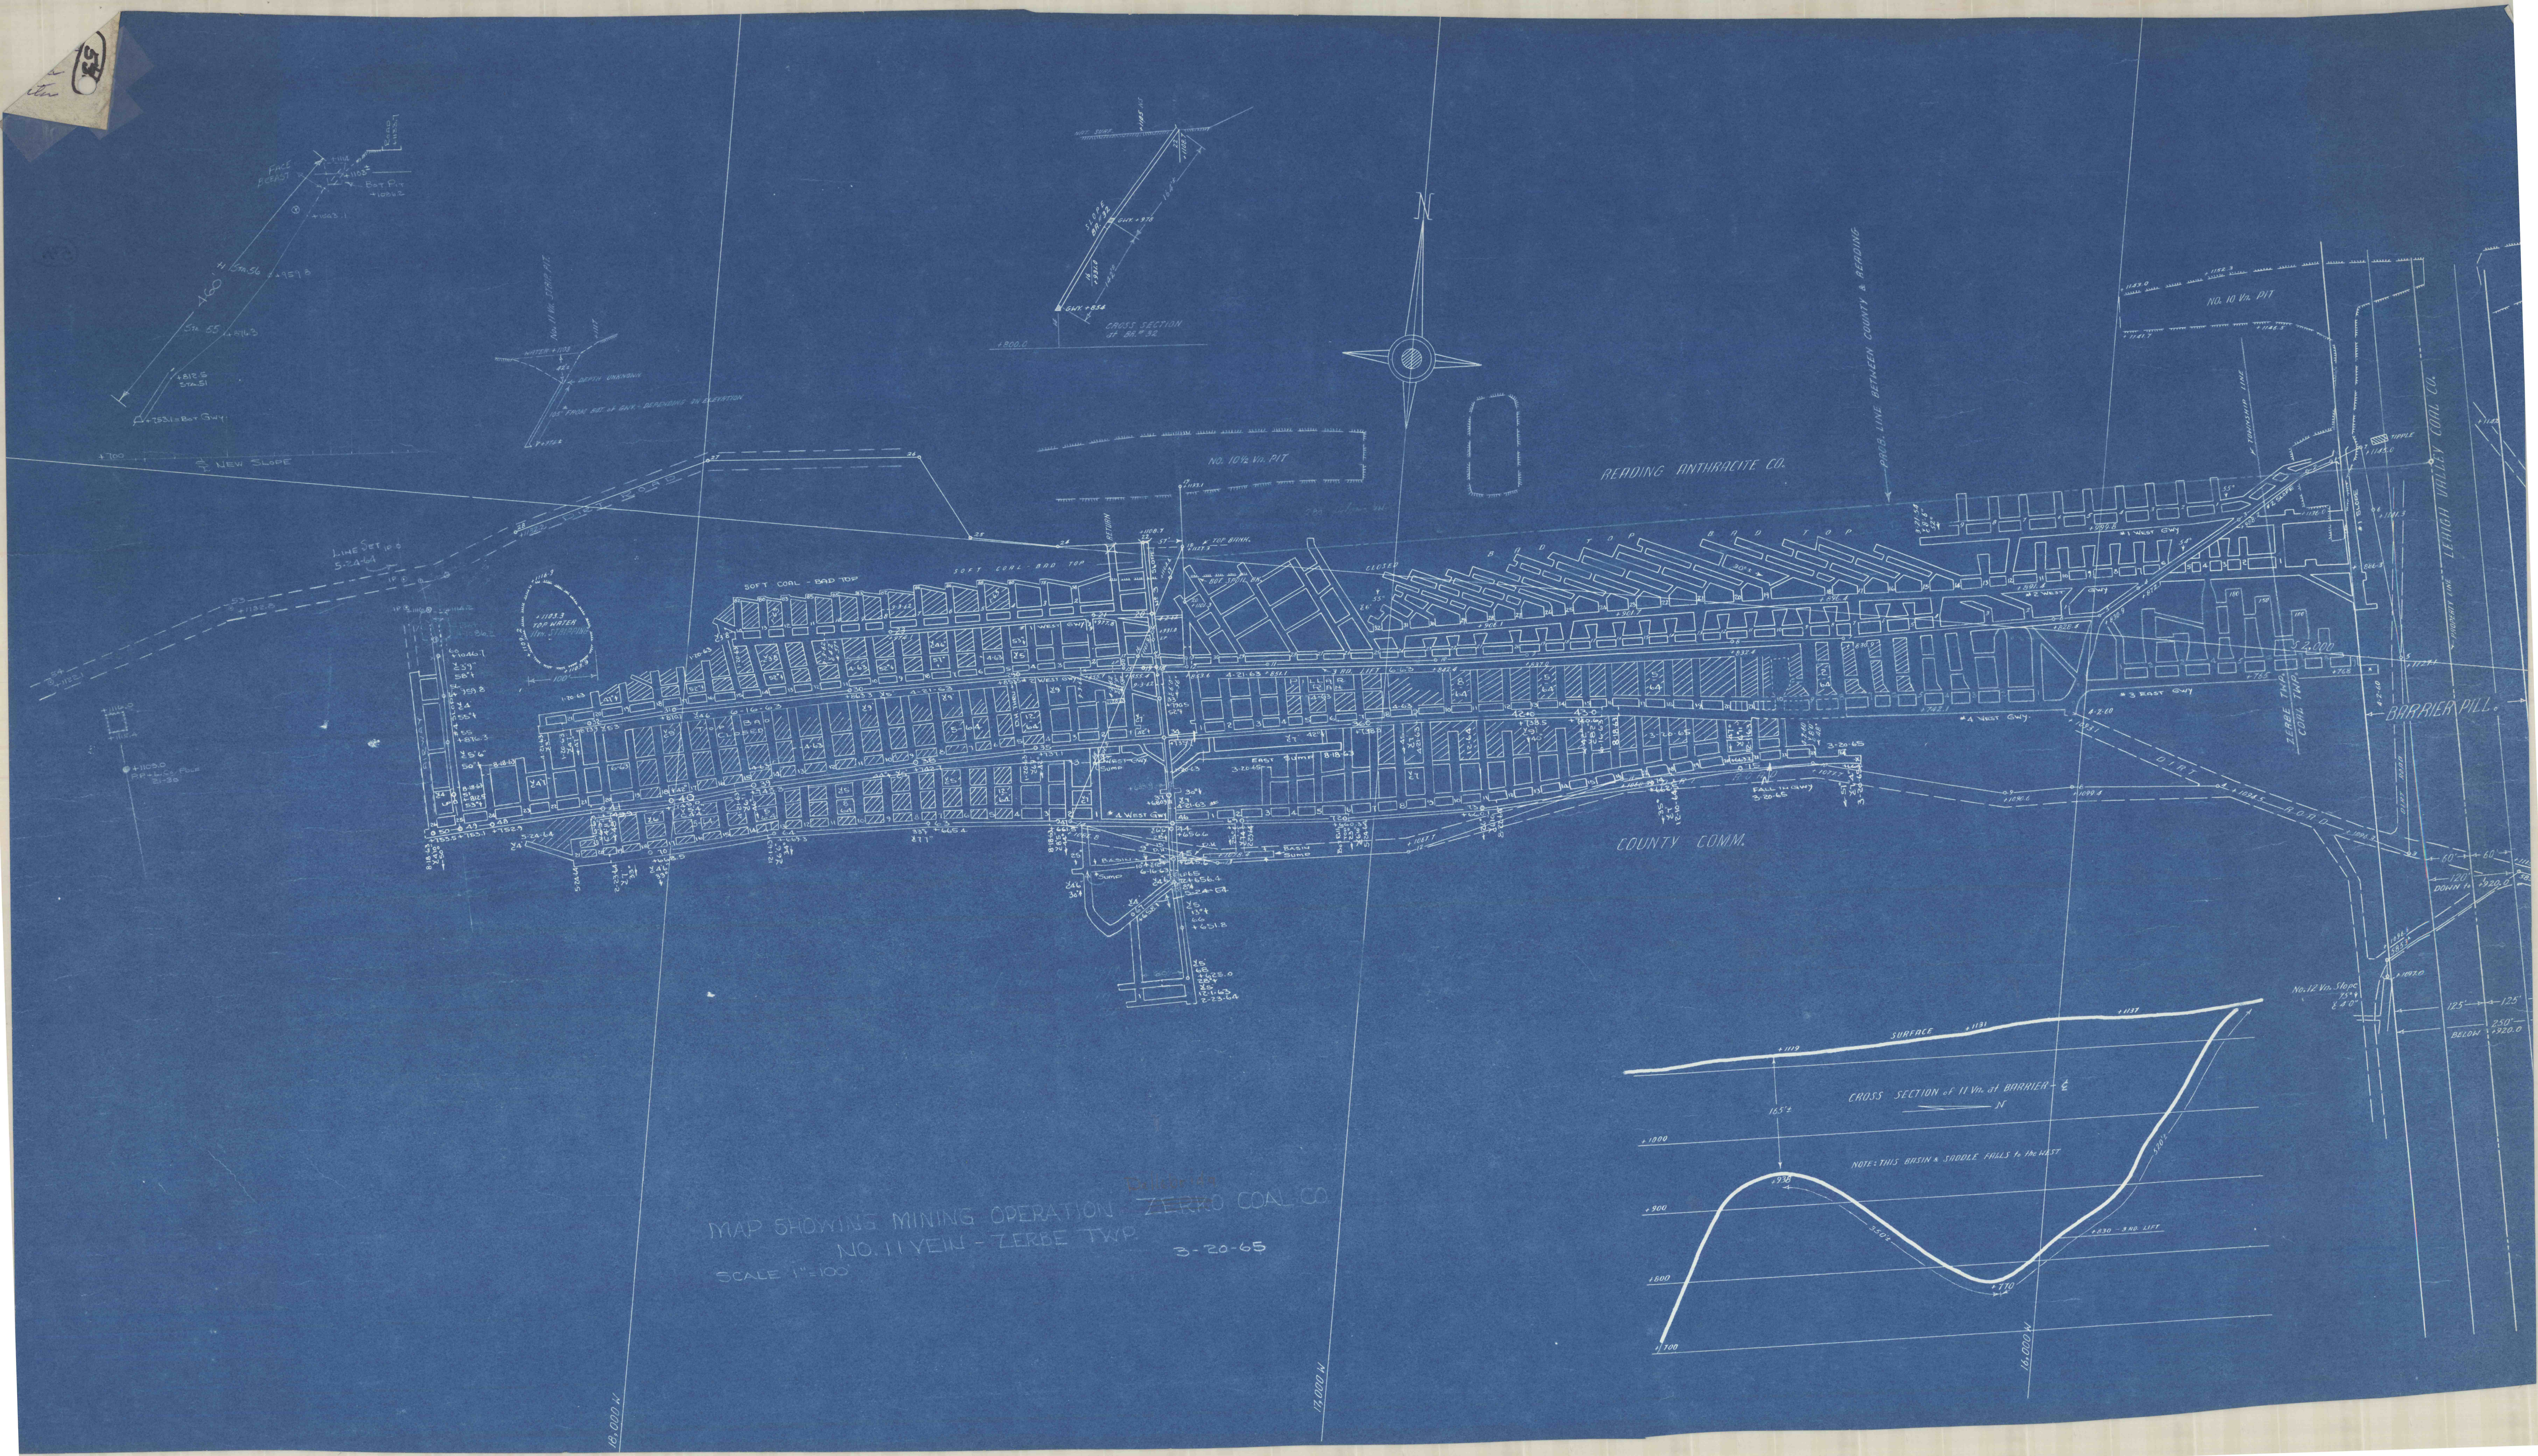

MAP SHOWING MINING OPERATION - ZERBE COAL CO.
NO. 11 Vn. - ZERBE TWP.
SCALE 1"=100'
3-20-65

