

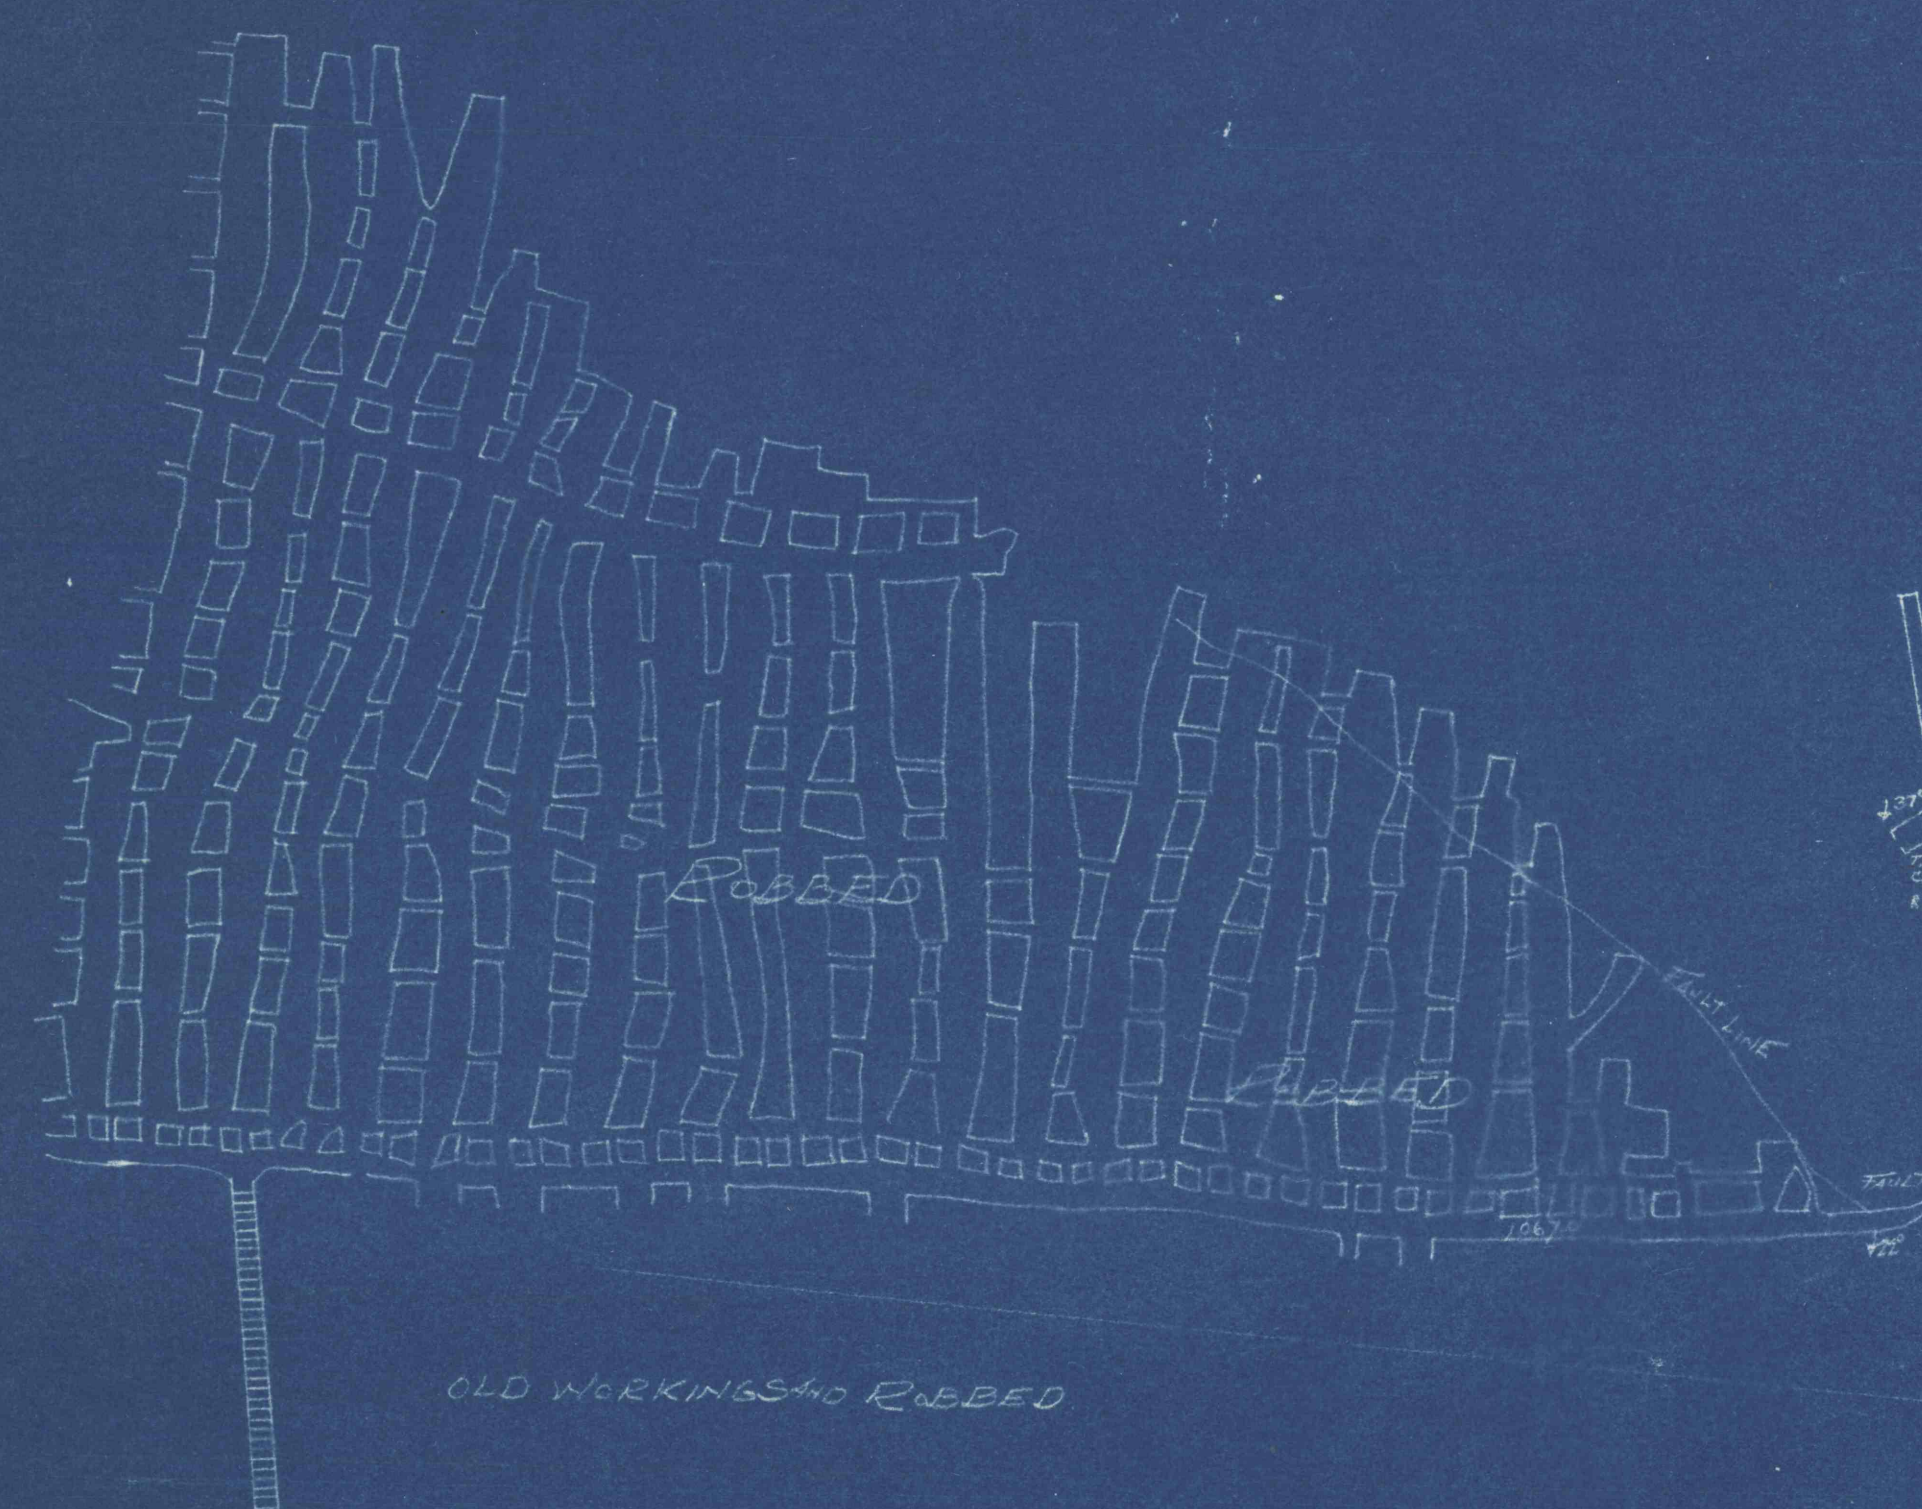


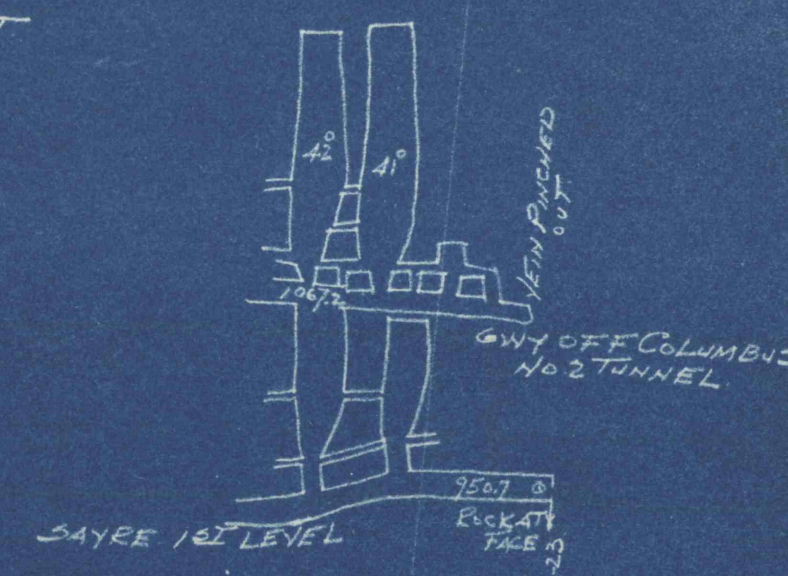


NICK AMARON SLOPE

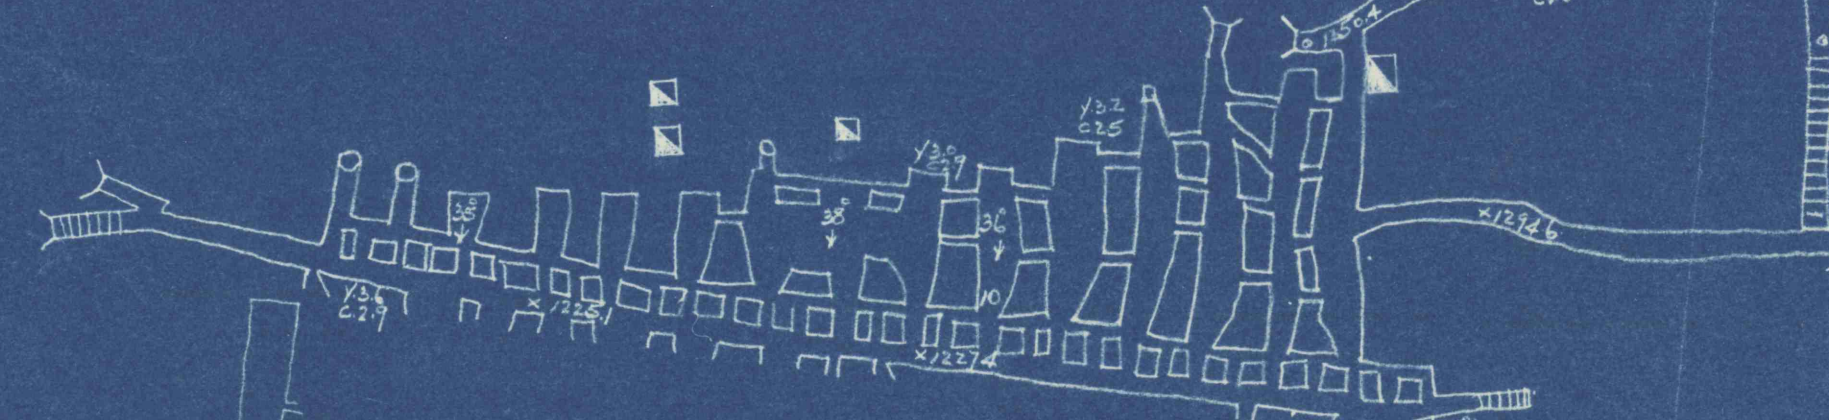

J. VATSKO, J. KORZENICKI, & H. BERNAS

BY HAND

BY HAND

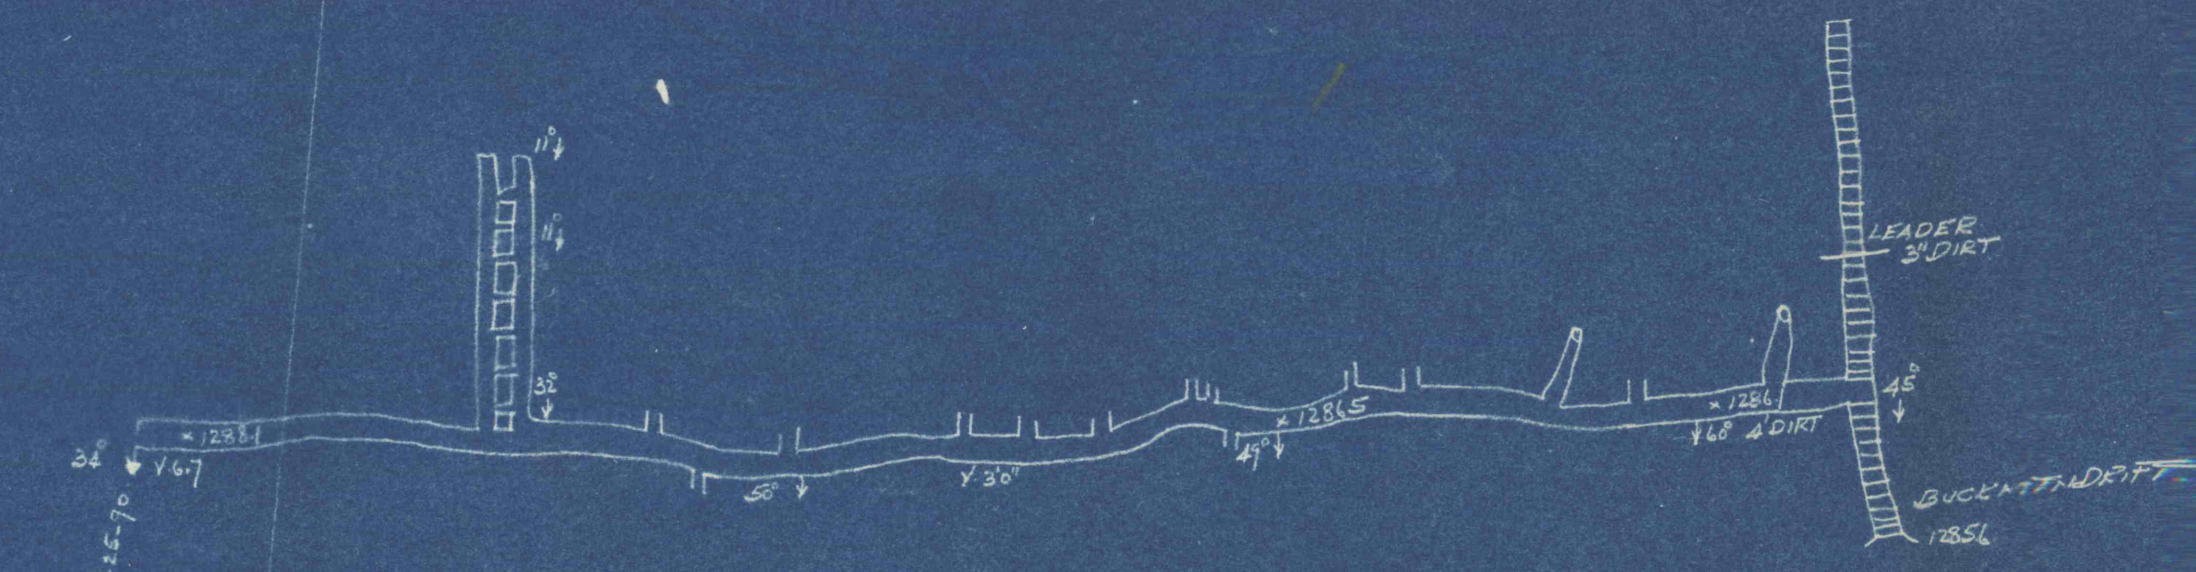

BARRE PILLAR

SHAKE SHAFT

ROUGH LINE

ROUGH LINE