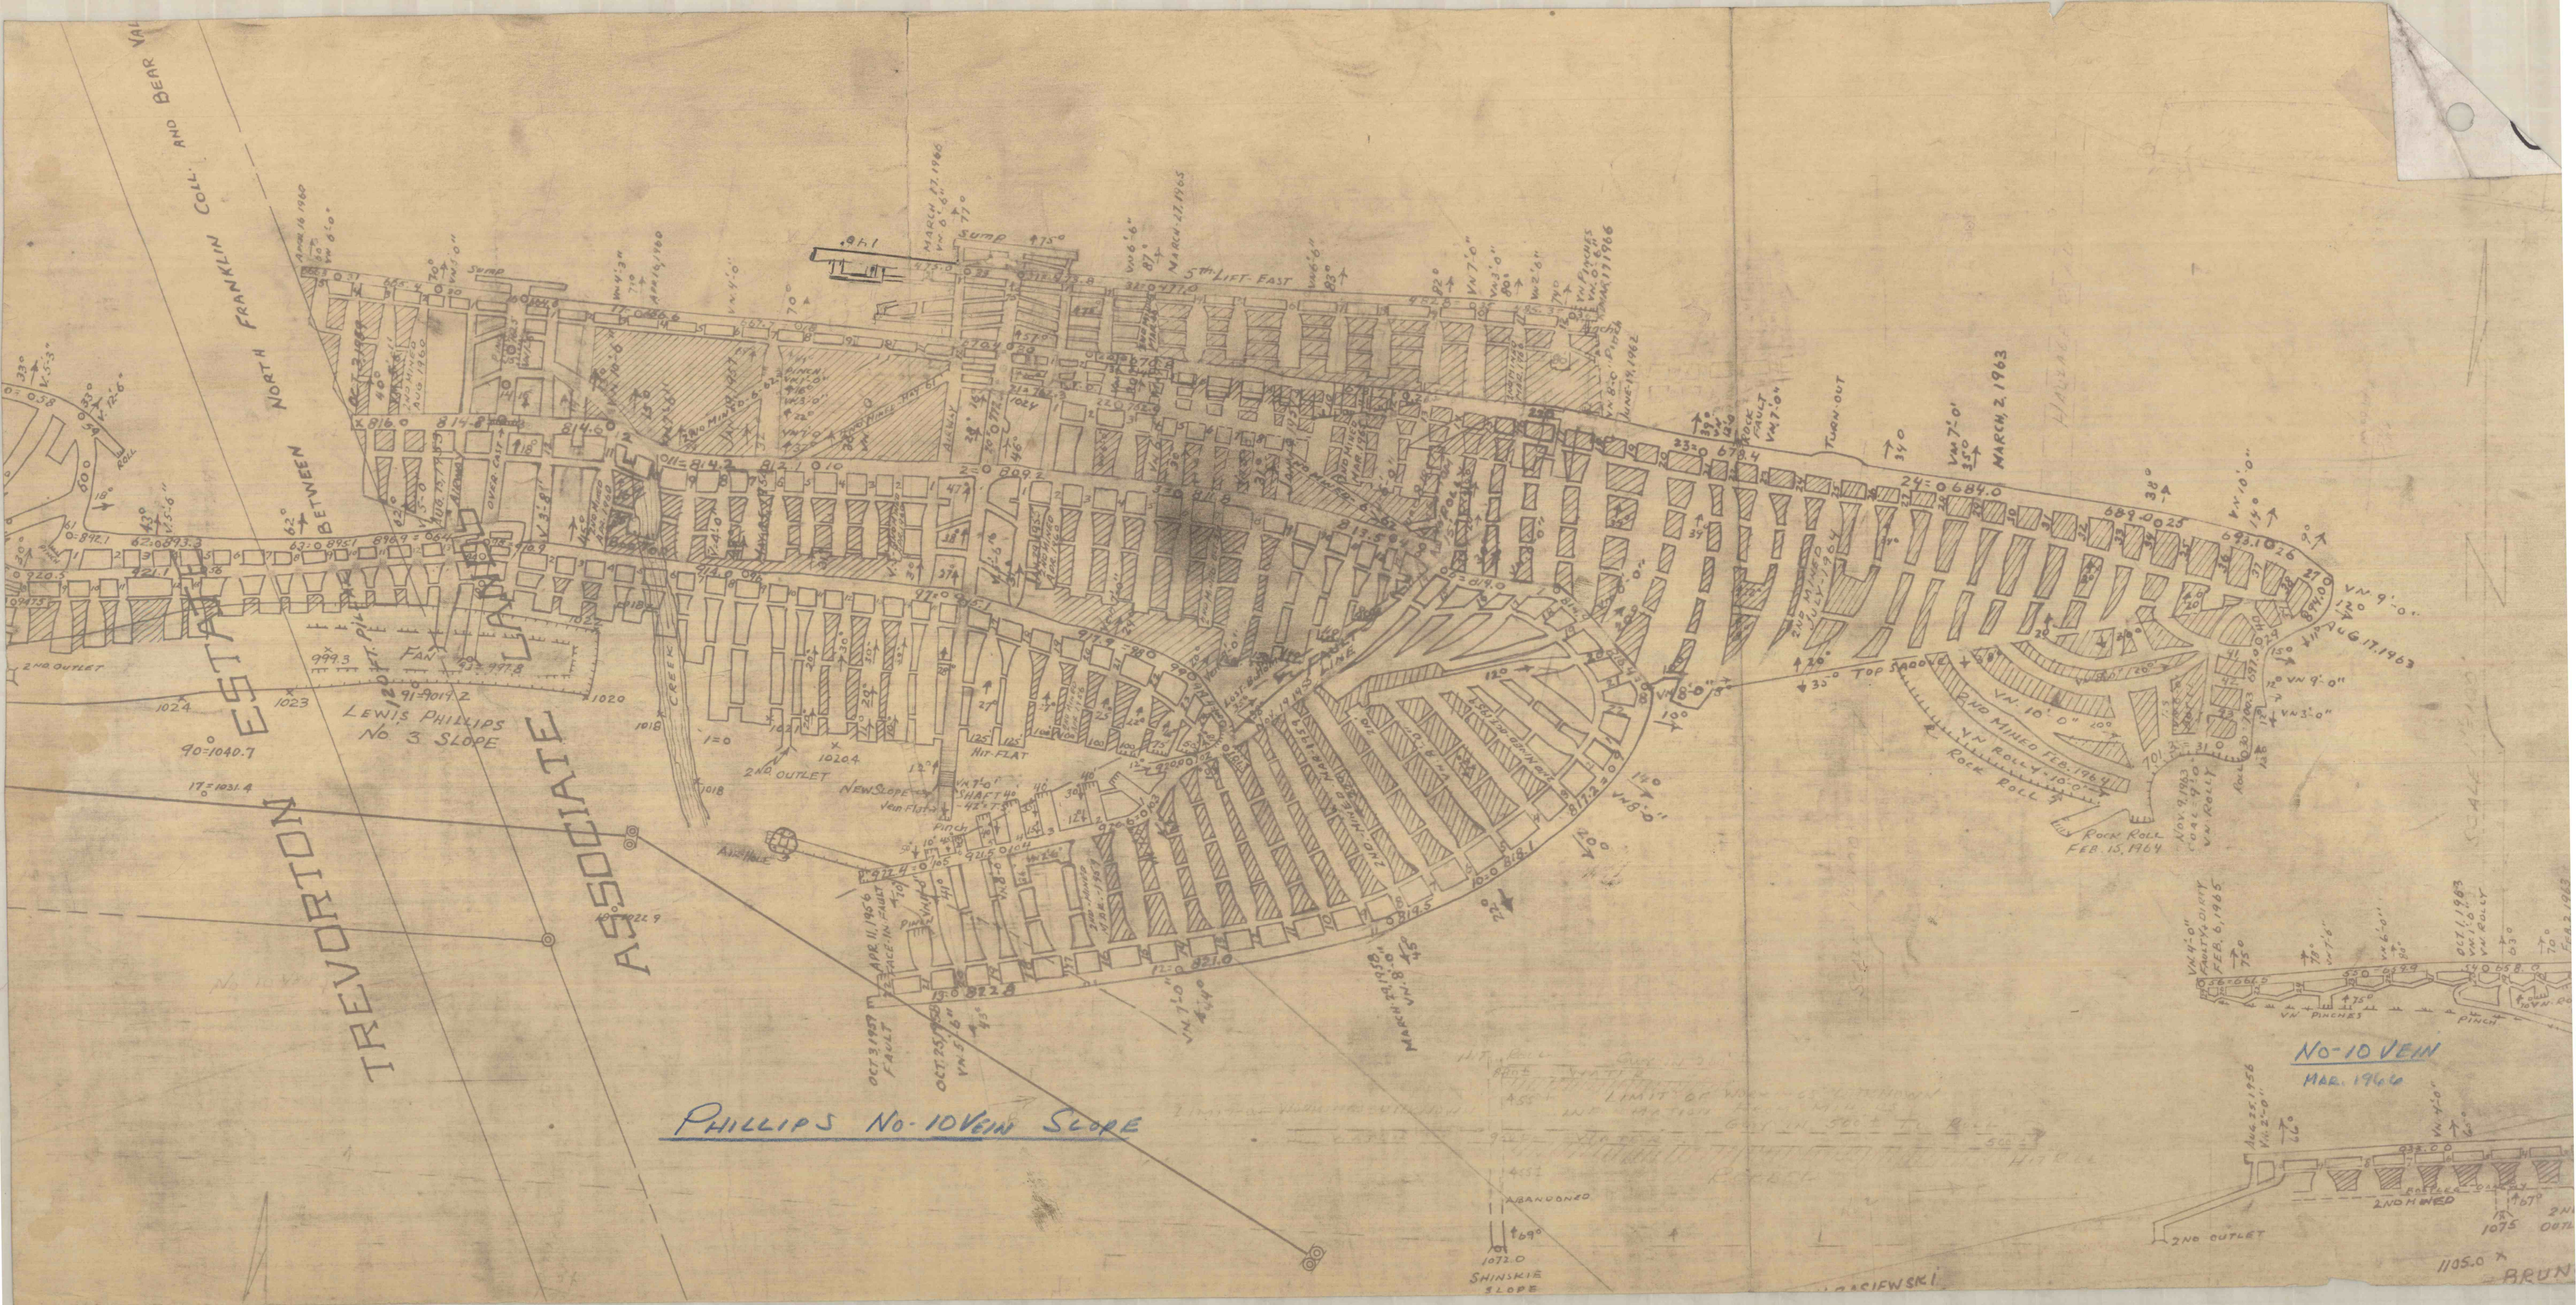
PHILLIPS No-10 VEIN SLOPE
No-10 VEIN
MAR. 1966
TREVORTON ESTATE ASSOCIATE
NORTH FRANKLIN COLL. AND BEAR VA
BETWEEN
LEWIS PHILLIPS No 3 SLOPE
5th LIFT-EAST
MARCH, 2, 1963
AUG 17, 1963
TOP SLOPE
2ND MINED FEB. 1964
ROCK ROLL FEB. 15, 1964
2ND OUTLET
NEW SLOPE
SHINSKIE SLOPE
ABANDONED
LIMIT OF WORKINGS
FAN
CREEK
SUMP
TURN OUT
ROCK FAULT
HIT-FLAT
PINCH
VN PINCHES
2ND MINED
1105.0