

JOHN G. MARTIN TRACT
JOHN BAILY TRACT

TREVORTON ESTATE



North Franklin Creek and Bear Valley

LANDS

ASSOCIA

P.P.E.L. 66 KV. LINE

ZEBE TOWNSHIP LANDS
READING ANTHRACITE

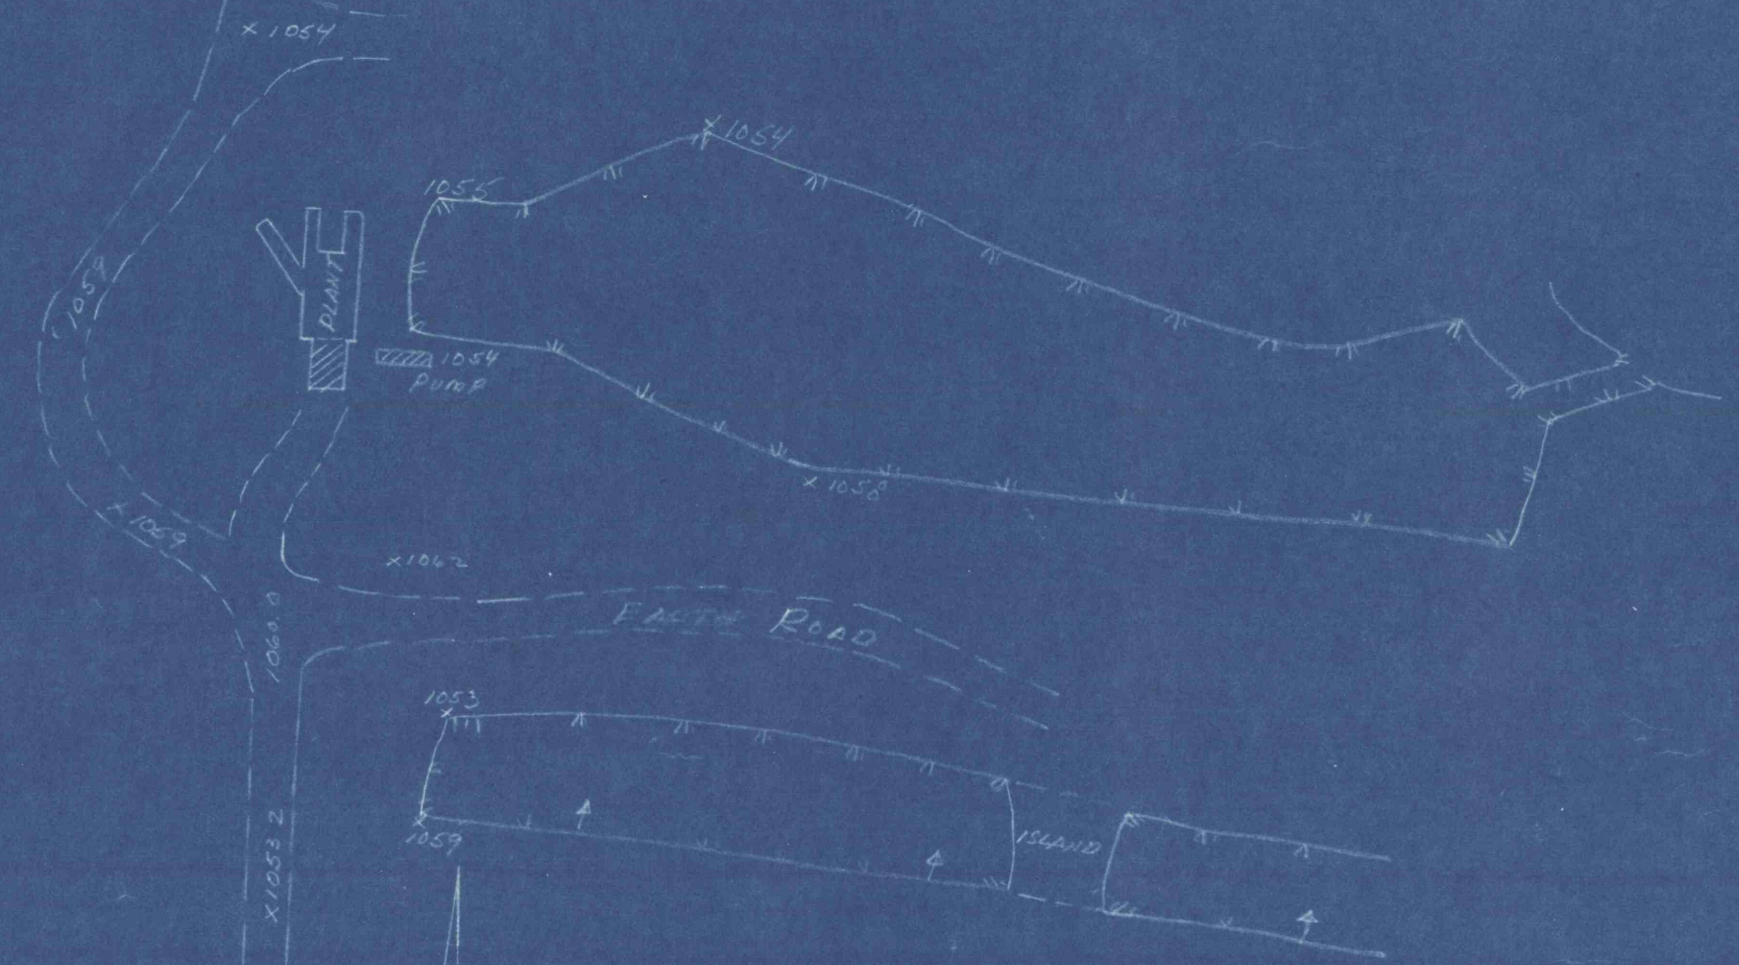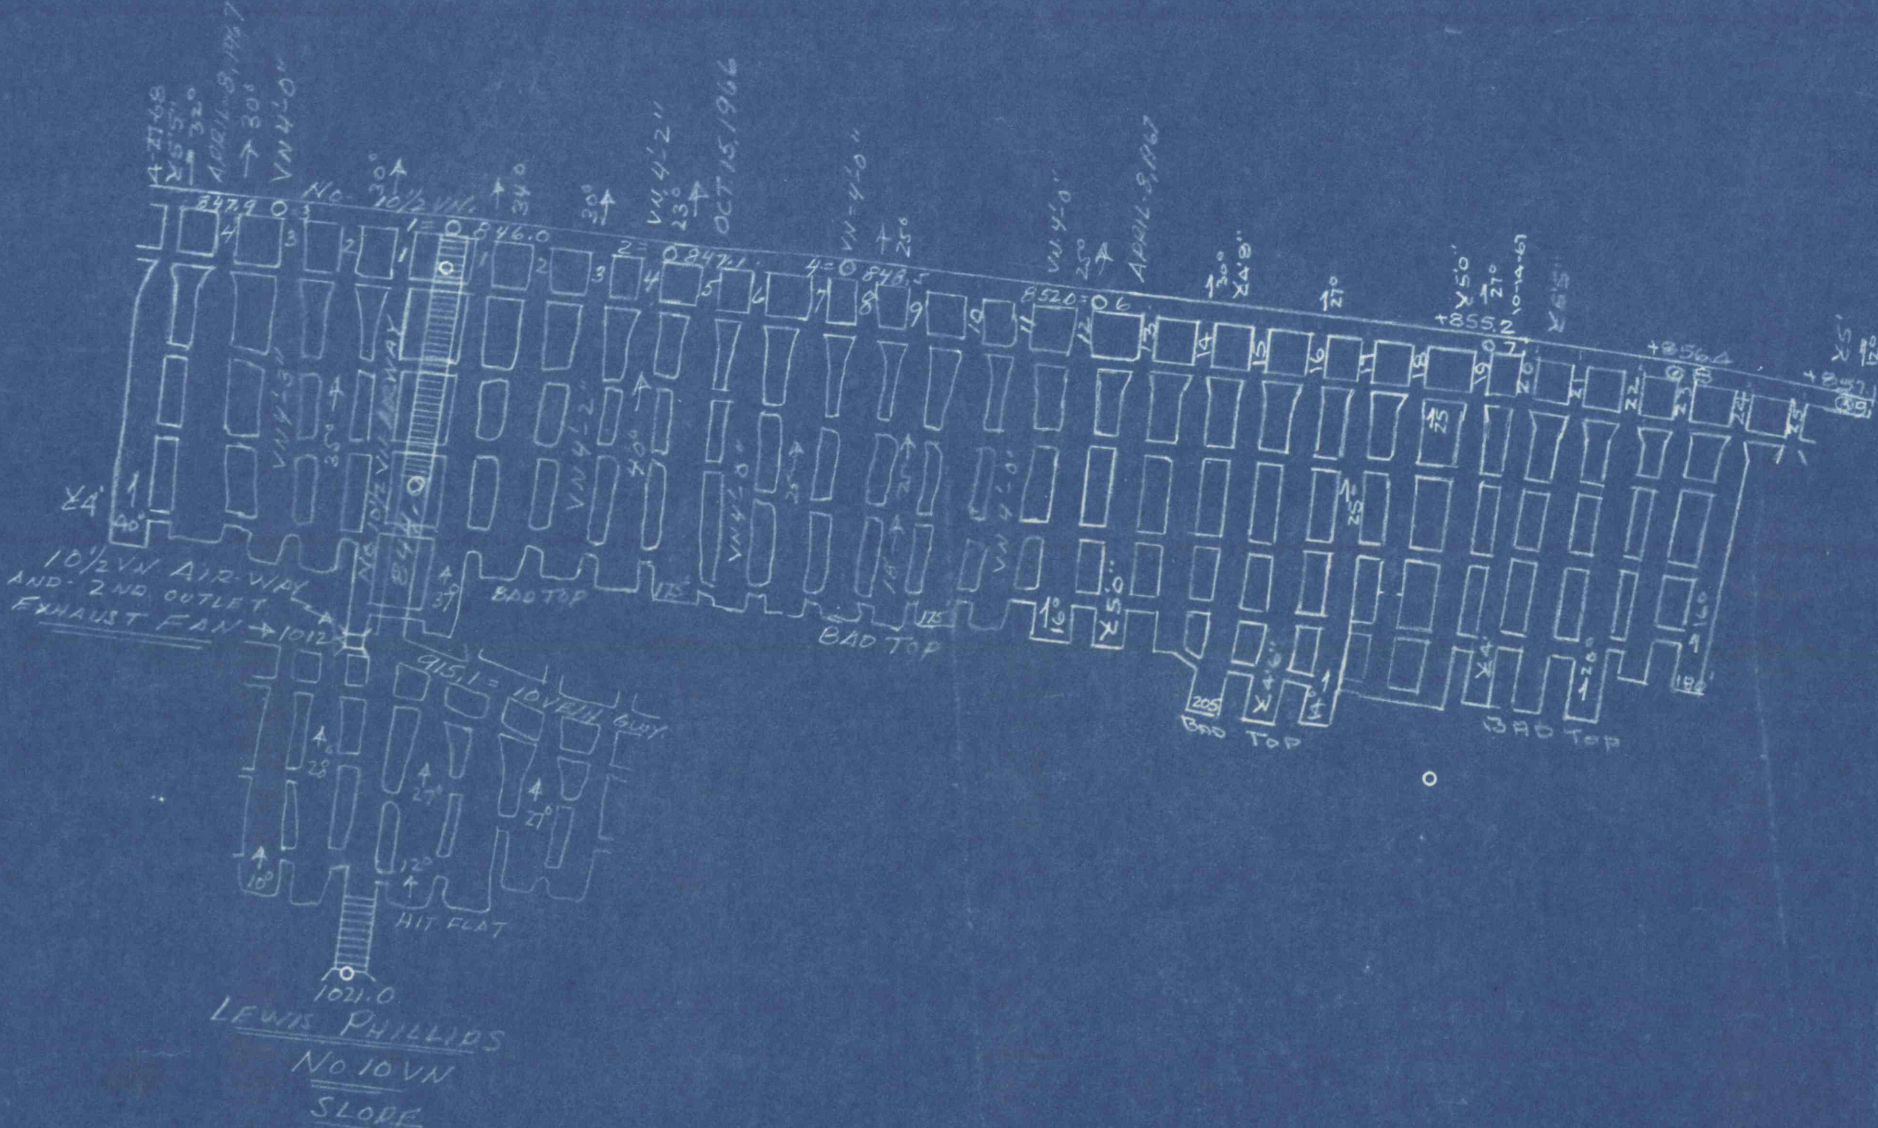

SCALE 1"=100'