(5)

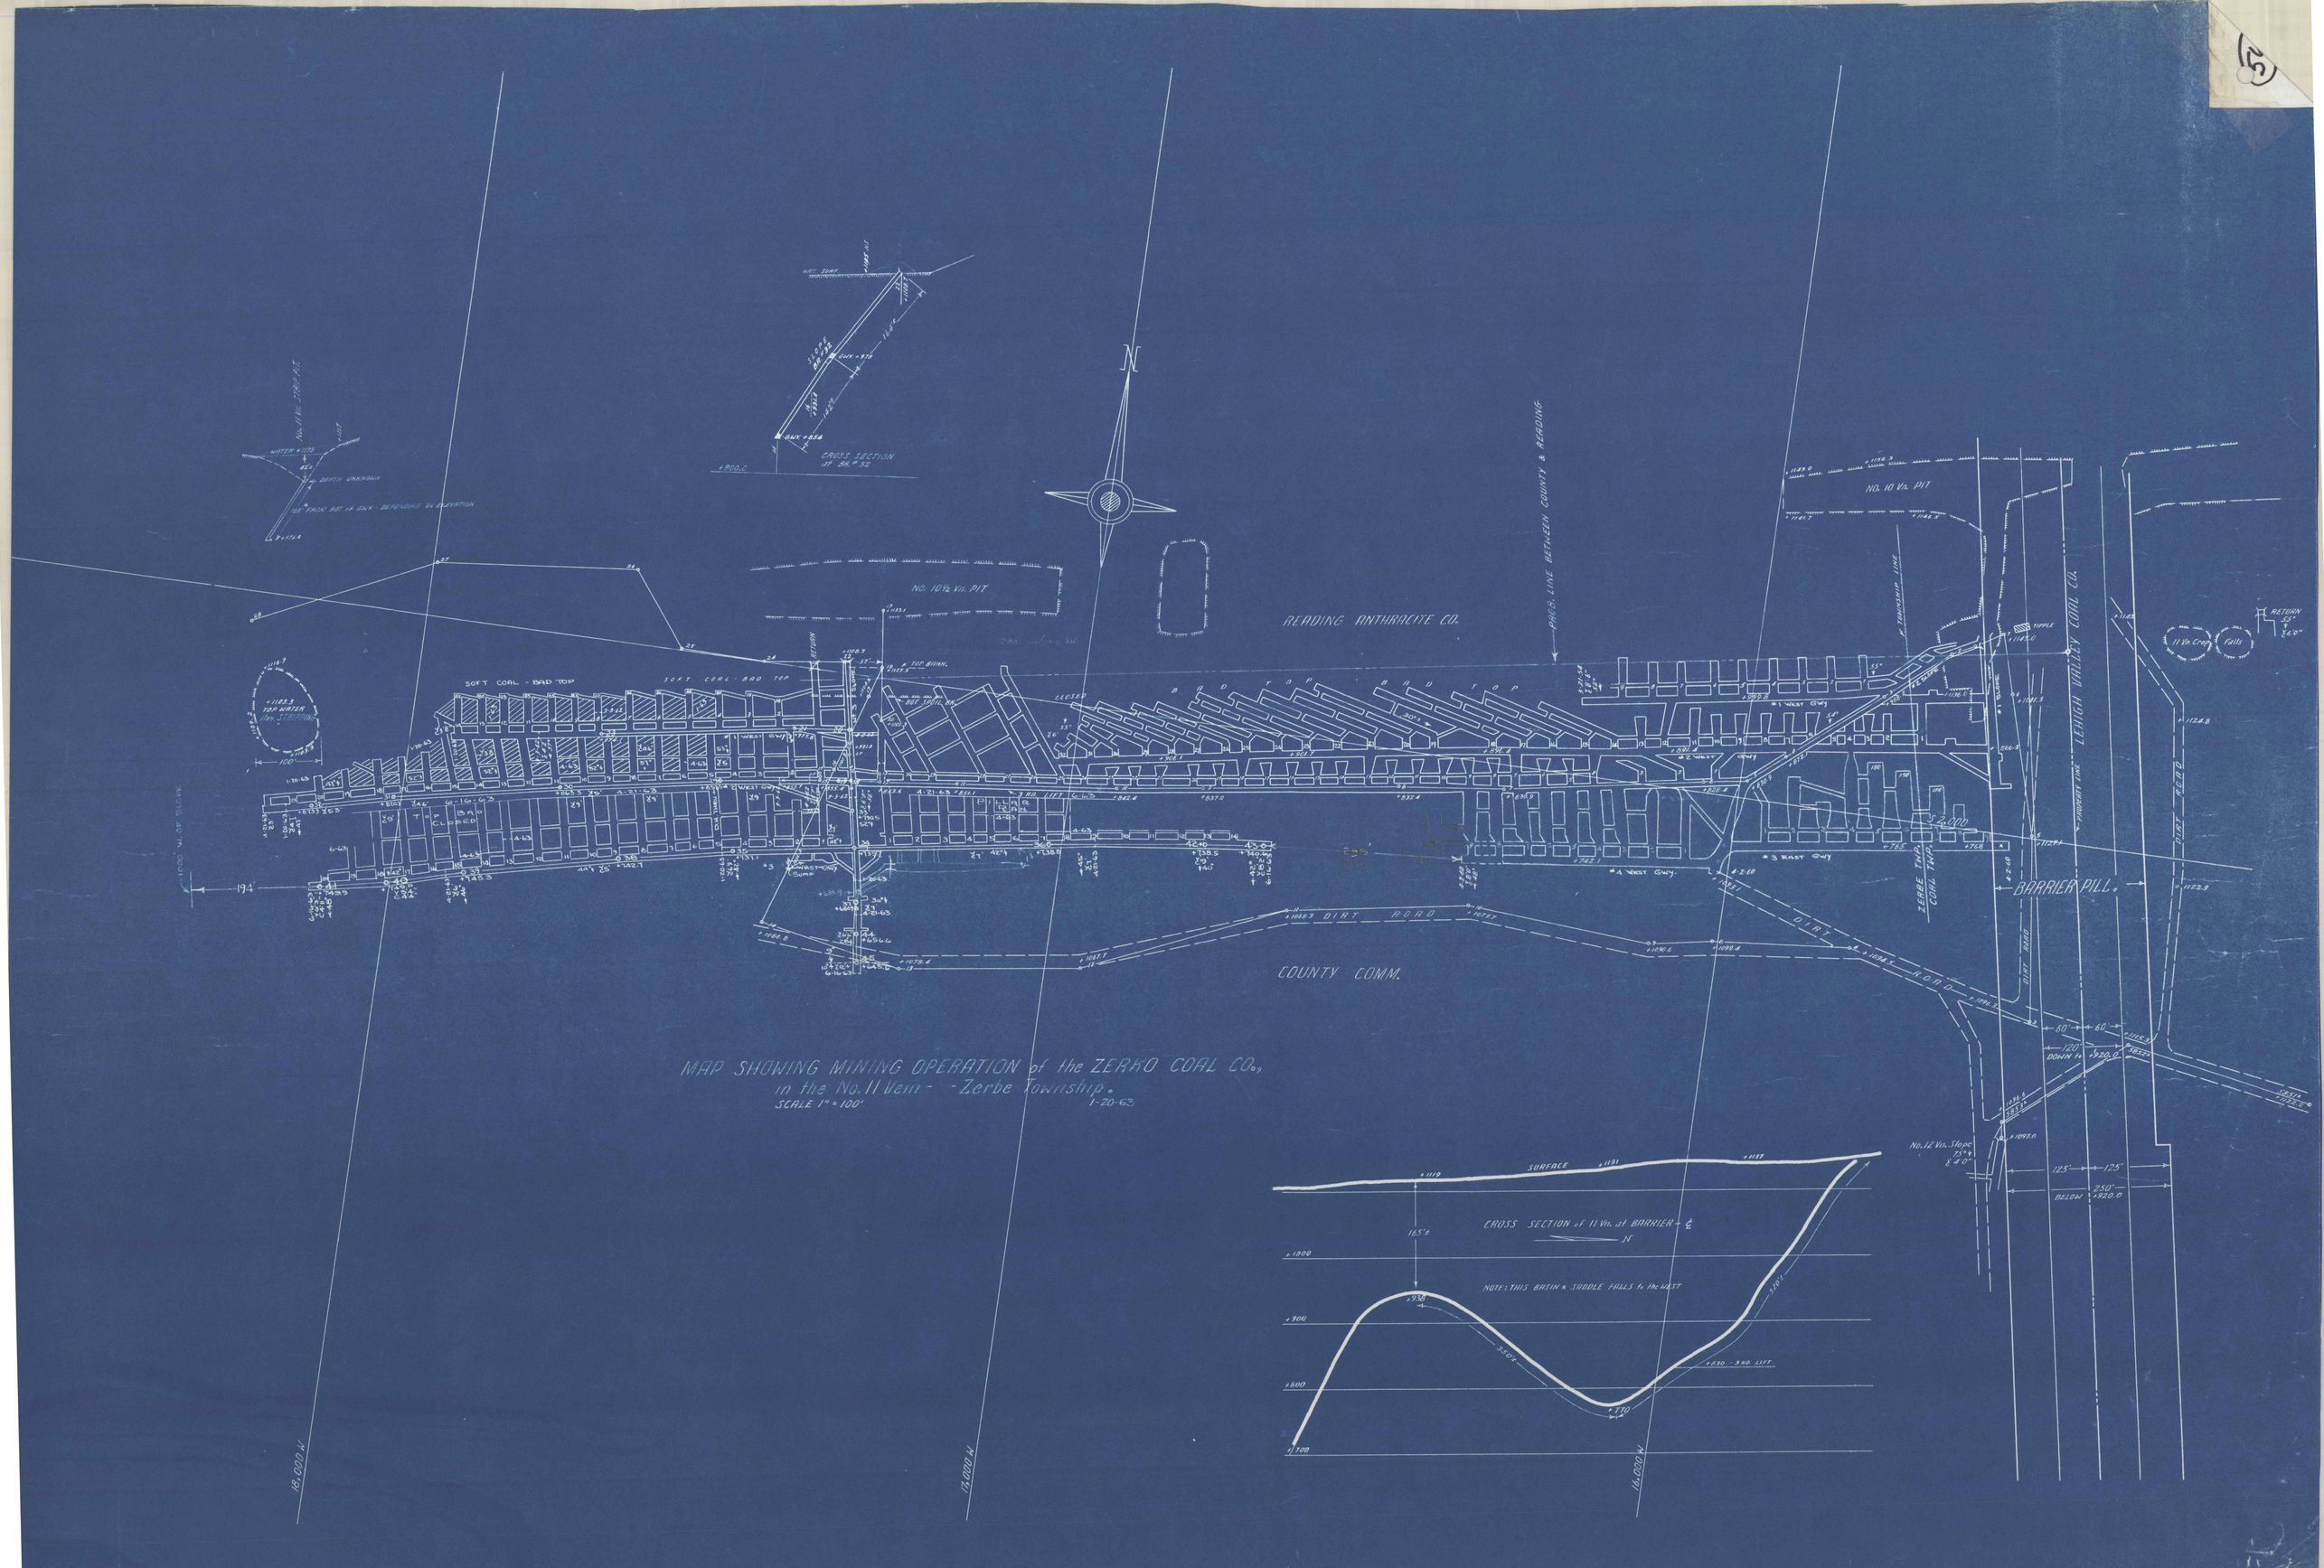
MAP SHOWING MINING OPERATION of the ZERKO COAL CO.,
in the No. 11 Vein - - Zerbe Township.
SCALE 1" = 100'
1-20-63
N
READING ANTHRACITE CO.
PROP. LINE BETWEEN COUNTY & READING
COUNTY COMM.
LEHIGH VALLEY COAL CO.
ZERBE TWP. COAL TWP.
BARRIER PILL.
NO. 10½ Vn. PIT
NO. 10 Vn. PIT
SOFT COAL - BAD TOP
BAD TOP
CLOSED
#1 WEST GWY
#2 WEST GWY
#3 EAST GWY
#4 WEST GWY.
DIRT ROAD
TIPPLE
RETURN
11 Vn. Crop
Falls
No. 12 Vn. Slope
CROSS SECTION of 11 Vn. at BARRIER
SURFACE
NOTE: THIS BASIN & SADDLE FALLS to the WEST
18,000 N
17,000 N
16,000 N