

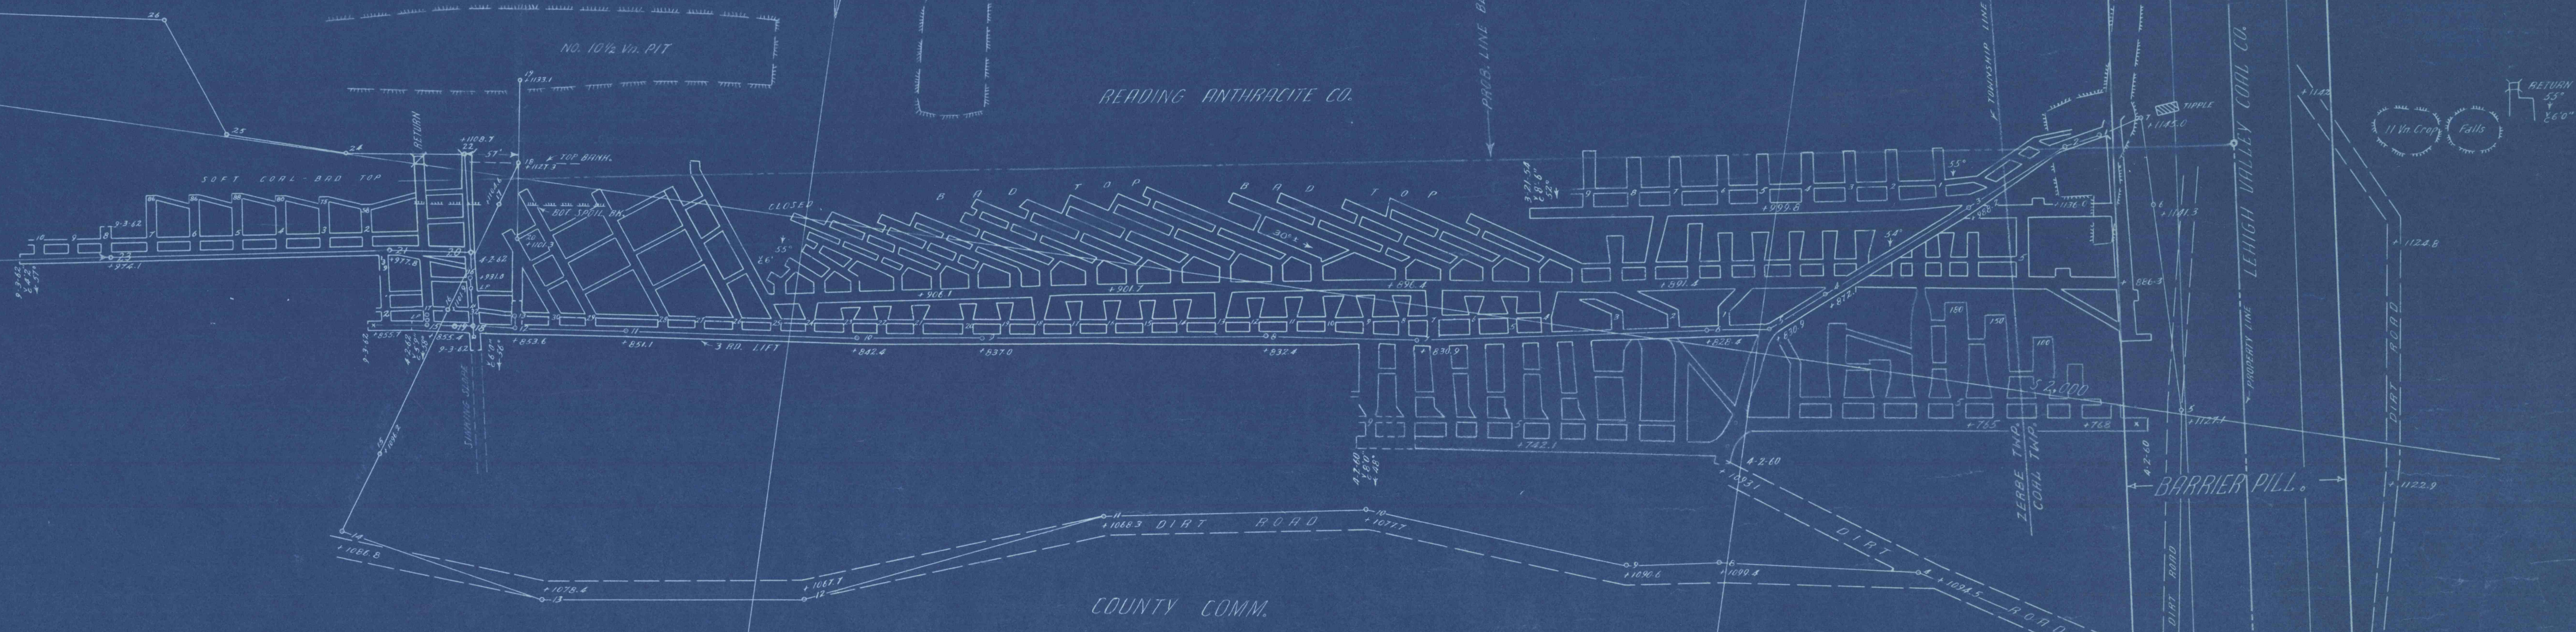
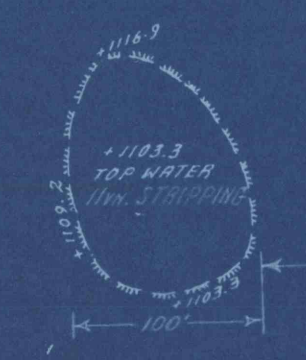
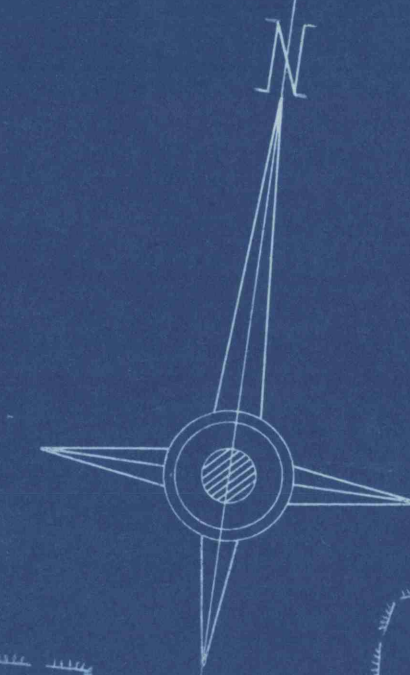


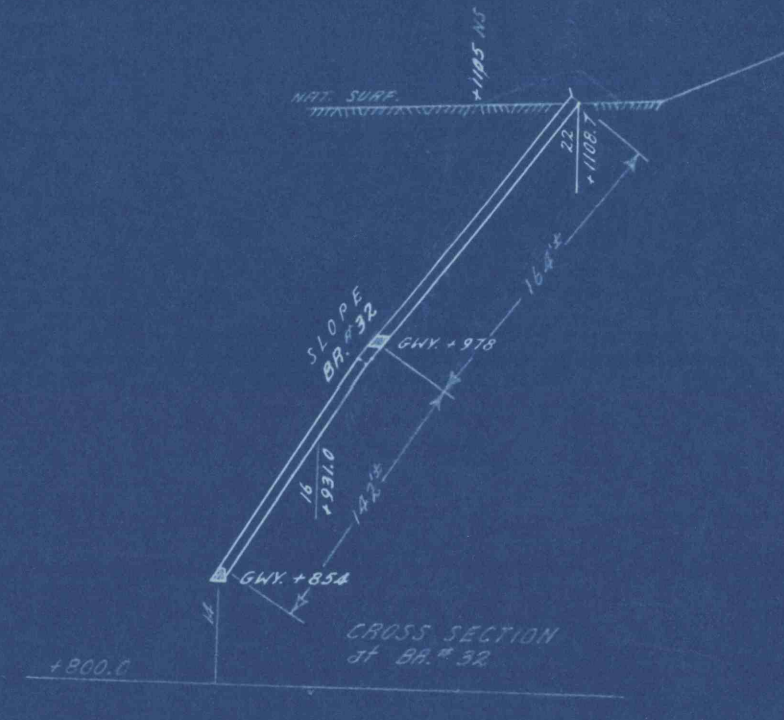

MAP SHOWING MINING OPERATION of the ZERBO COAL CO.,
in the No. 11 Vein - Zerbo Township.
SCALE 1" = 100' 2-13-62

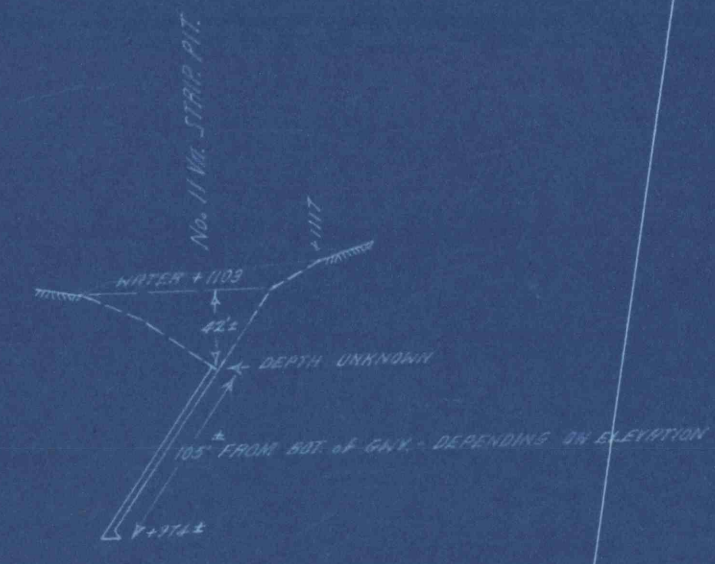