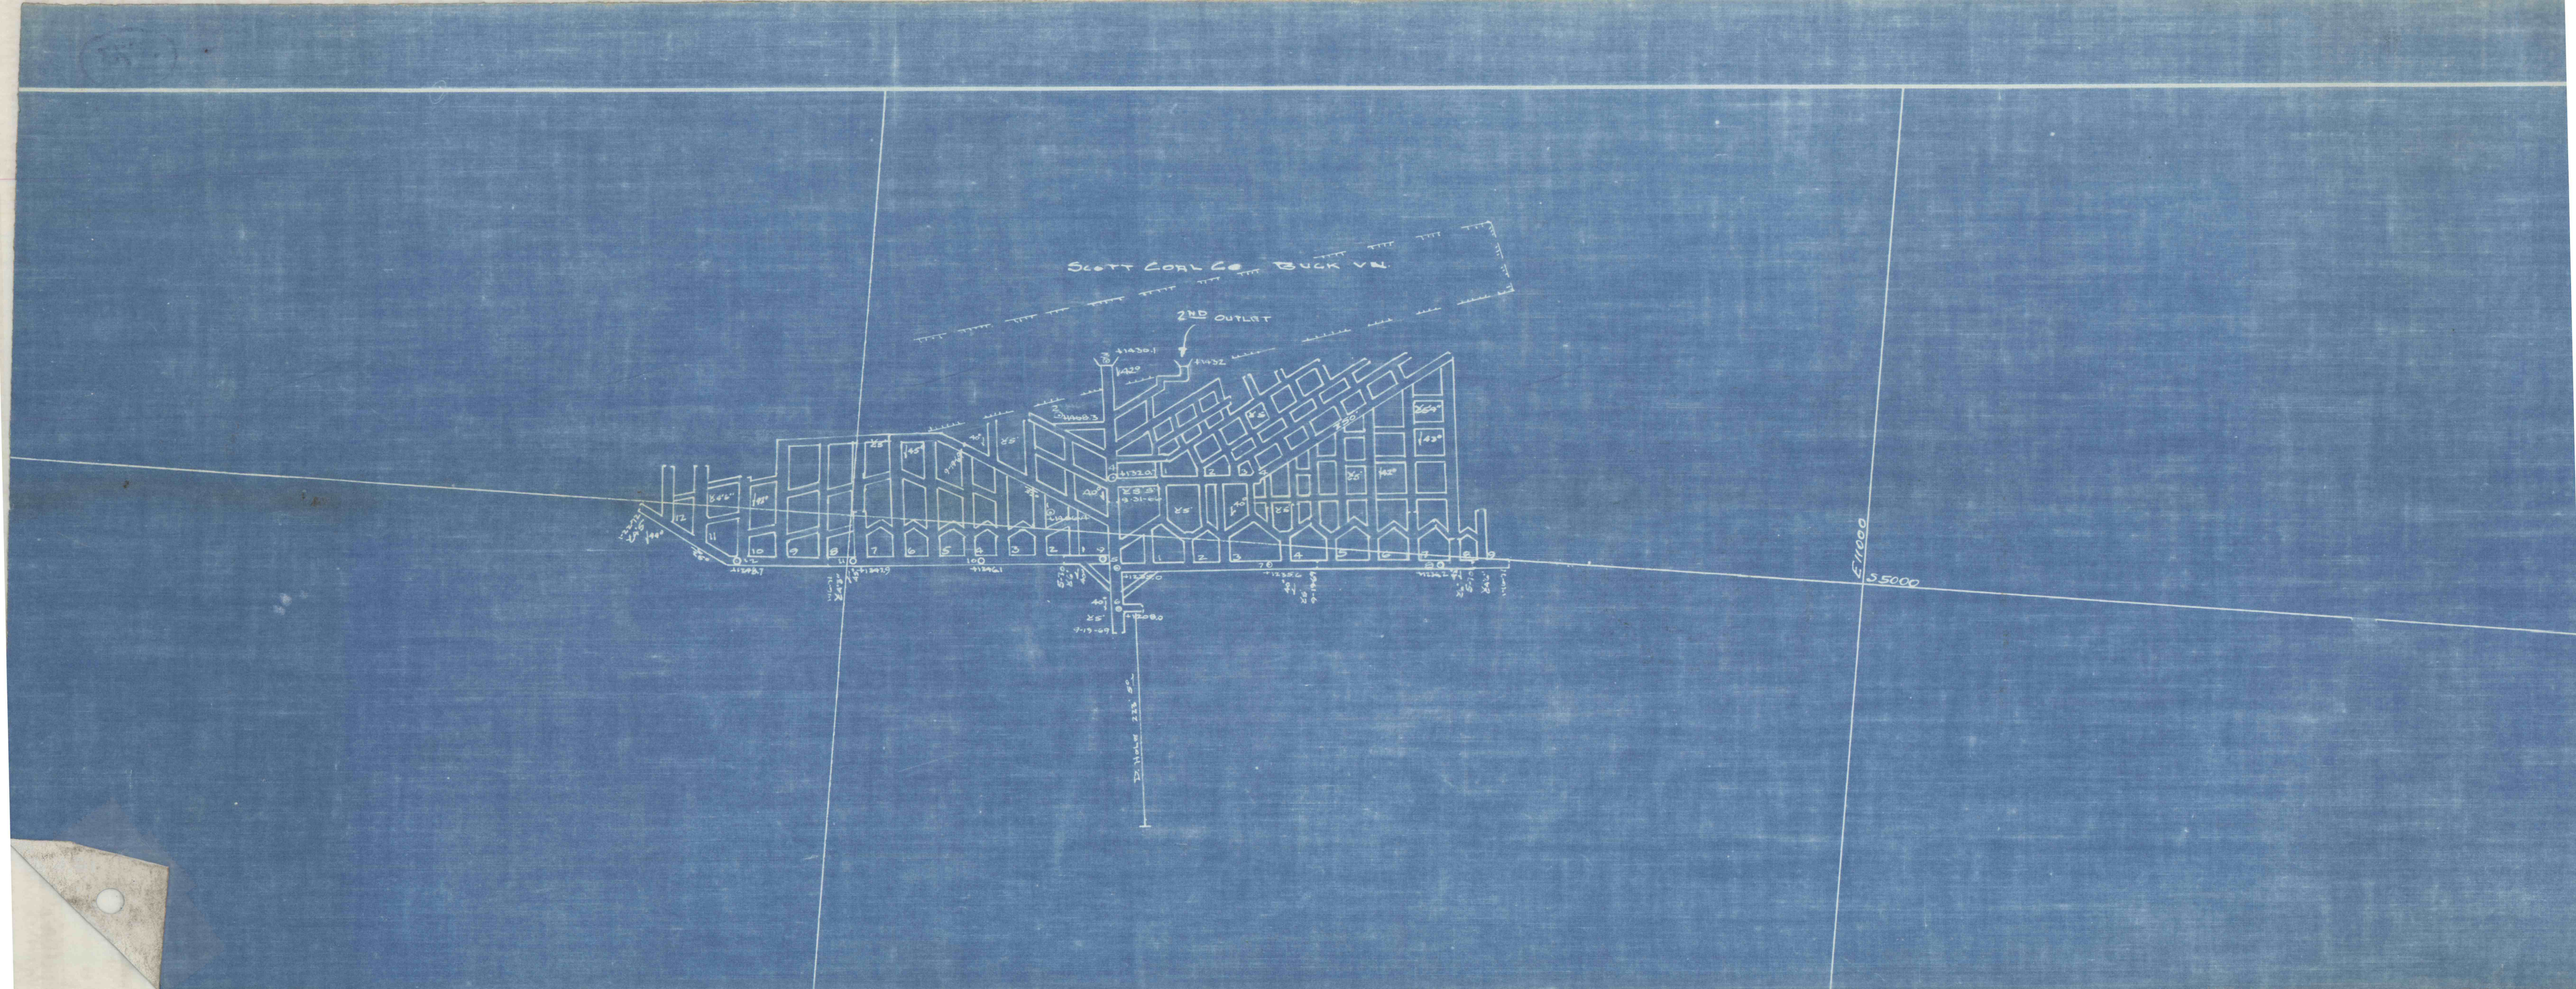
SCOTT COAL CO. BUCK VN.
2ND OUTLET
E 11000
S 5000