


425

WILLIAM WILSON


WILLIAM WILSON

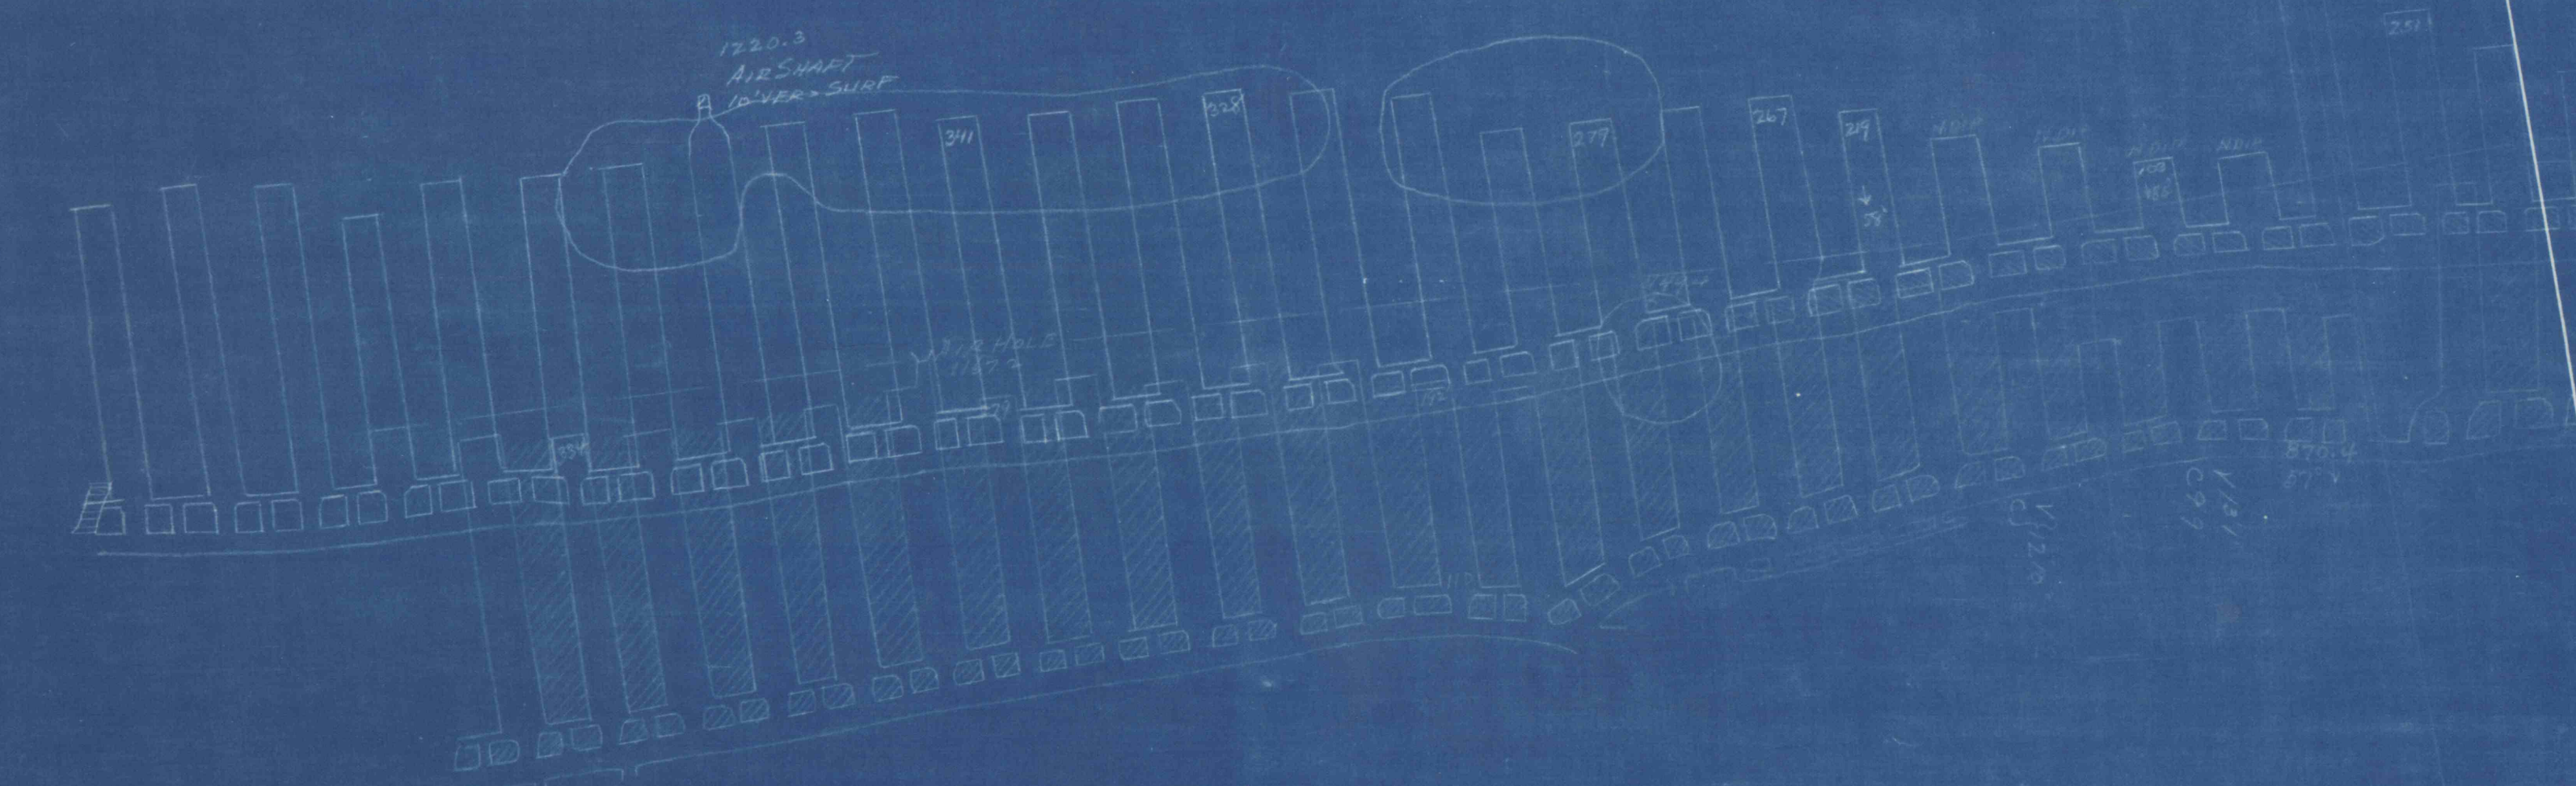

JOHN G. MARTIN

GARCIA
LAUREL BUSH COAL CO.

BANK COAL CO.

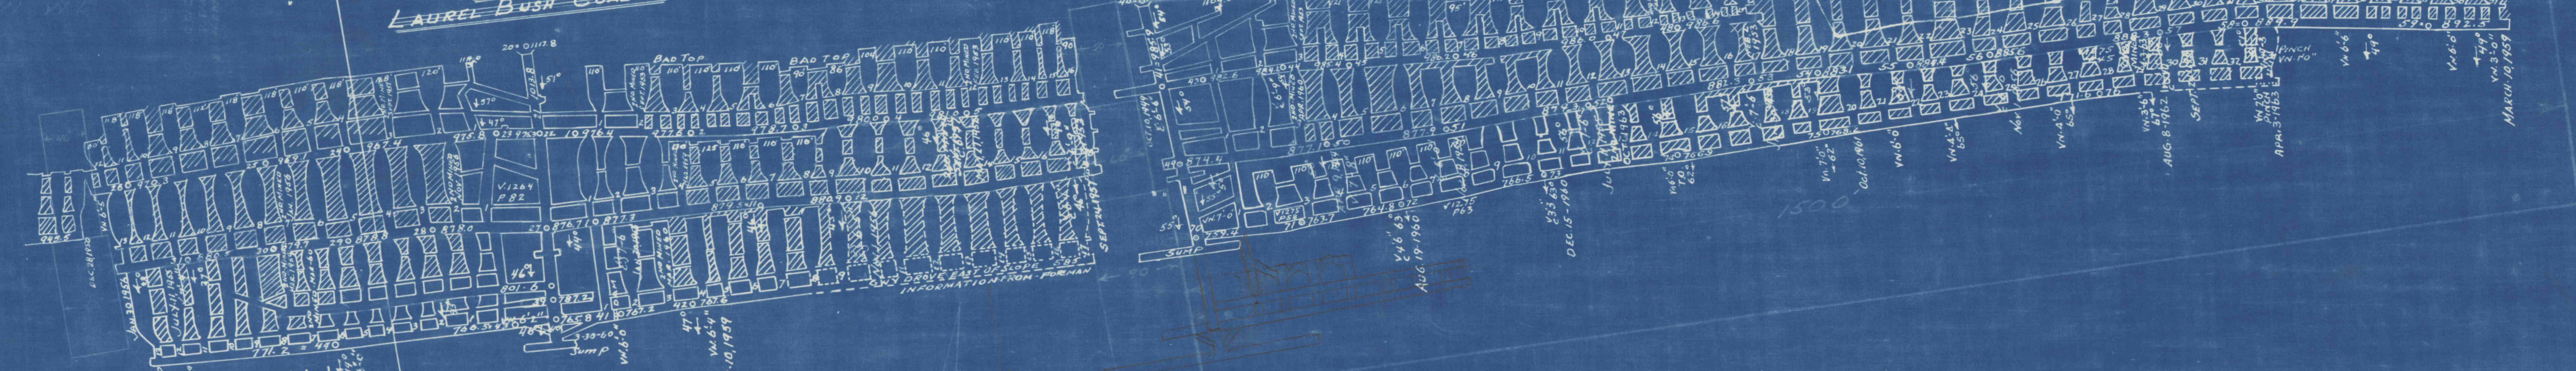

No. 10 VEIN PIT

No. 9 VEIN PIT

No. 8 1/2 VEIN PIT

BENJAMIN F. YOUNG