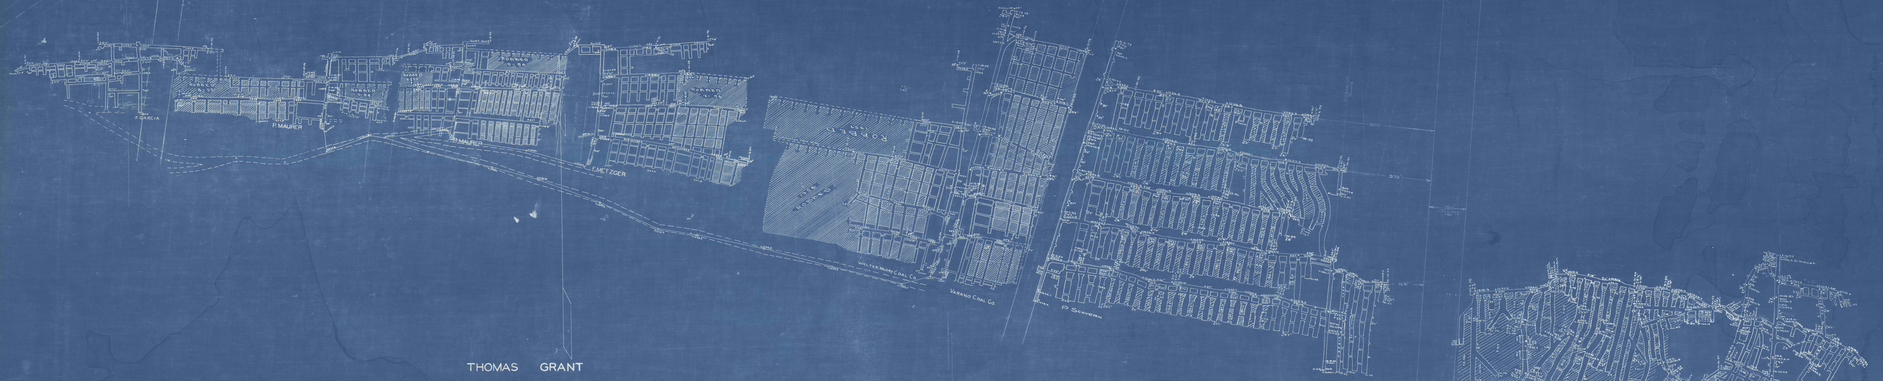

THOMAS GRANT
P. MAURER
P. MAURER
P. MAURER
METZGER
