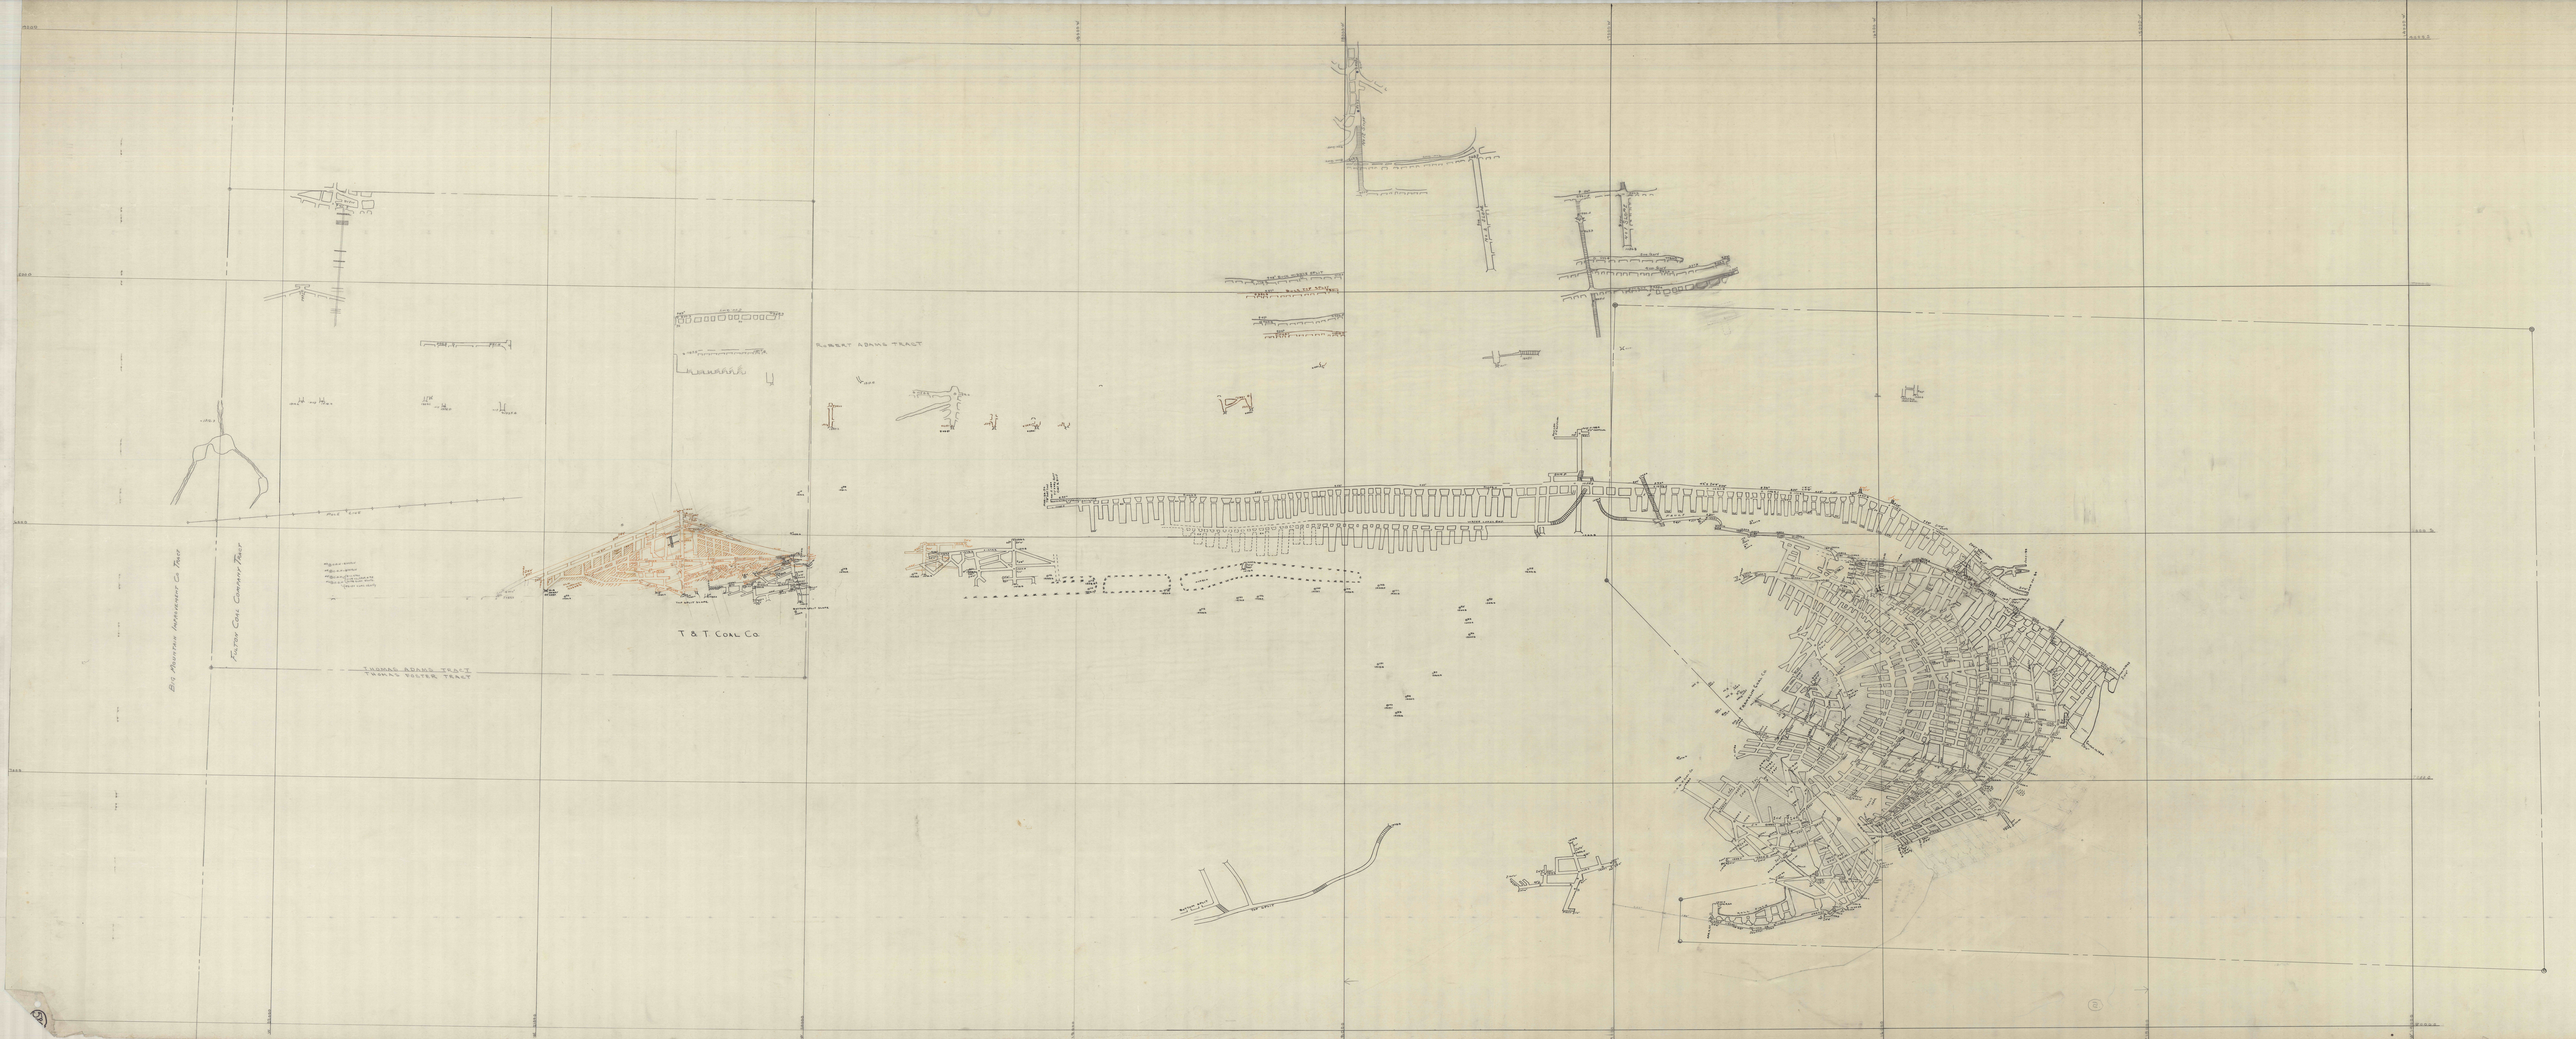

BIG MOUNTAIN INDEPENDENT CO. TRACT
FLATIRON COAL COMPANY TRACT
THOMAS ADAMS TRACT
THOMAS VOLTER TRACT
T & T COAL CO.
GILBERT ADAMS TRACT