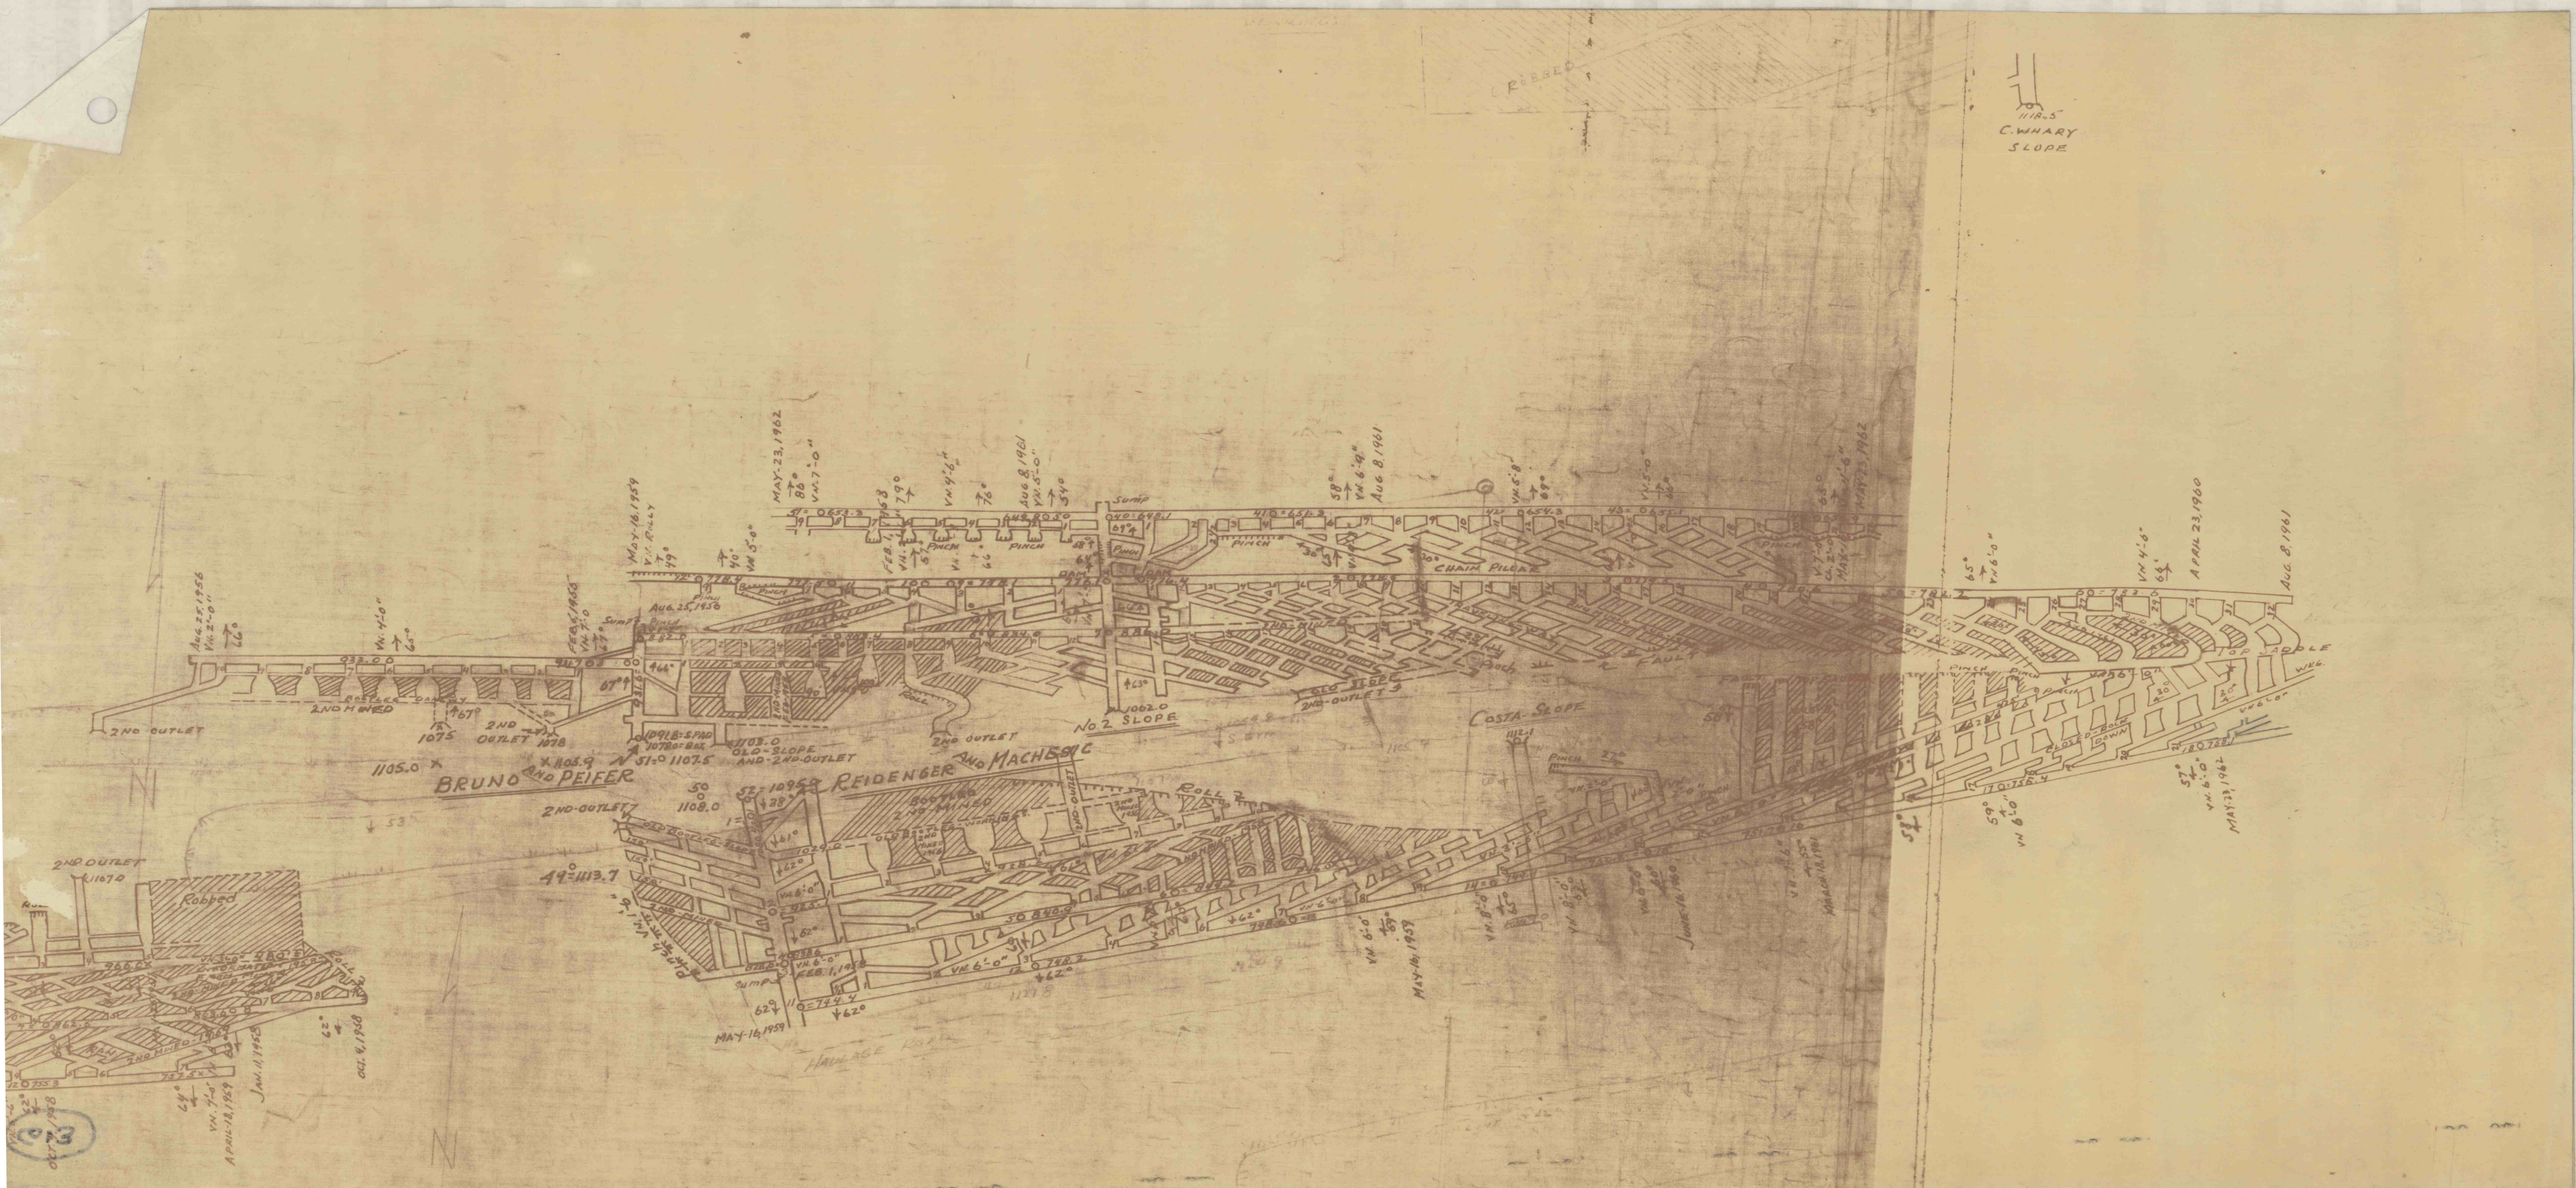
C. WHARY SLOPE
BRUNO AND PEIFER
REIDENGER AND MACHEBUC
No. 2 SLOPE
COSTA SLOPE
CHAIN PILLAR
FAULT
2ND OUTLET
2ND MINED
Robbed
Sump
Pinch
Roll
Haulage
Old Slope and 2nd Outlet
Close Back Down
Top Table
Wing
Aug. 25, 1956
May 23, 1962
May 16, 1959
Aug. 8, 1961
April 23, 1960
May 23, 1962
Jan. 11, 1962
Oct. 4, 1958
April 18, 1959
Feb. 1, 1962