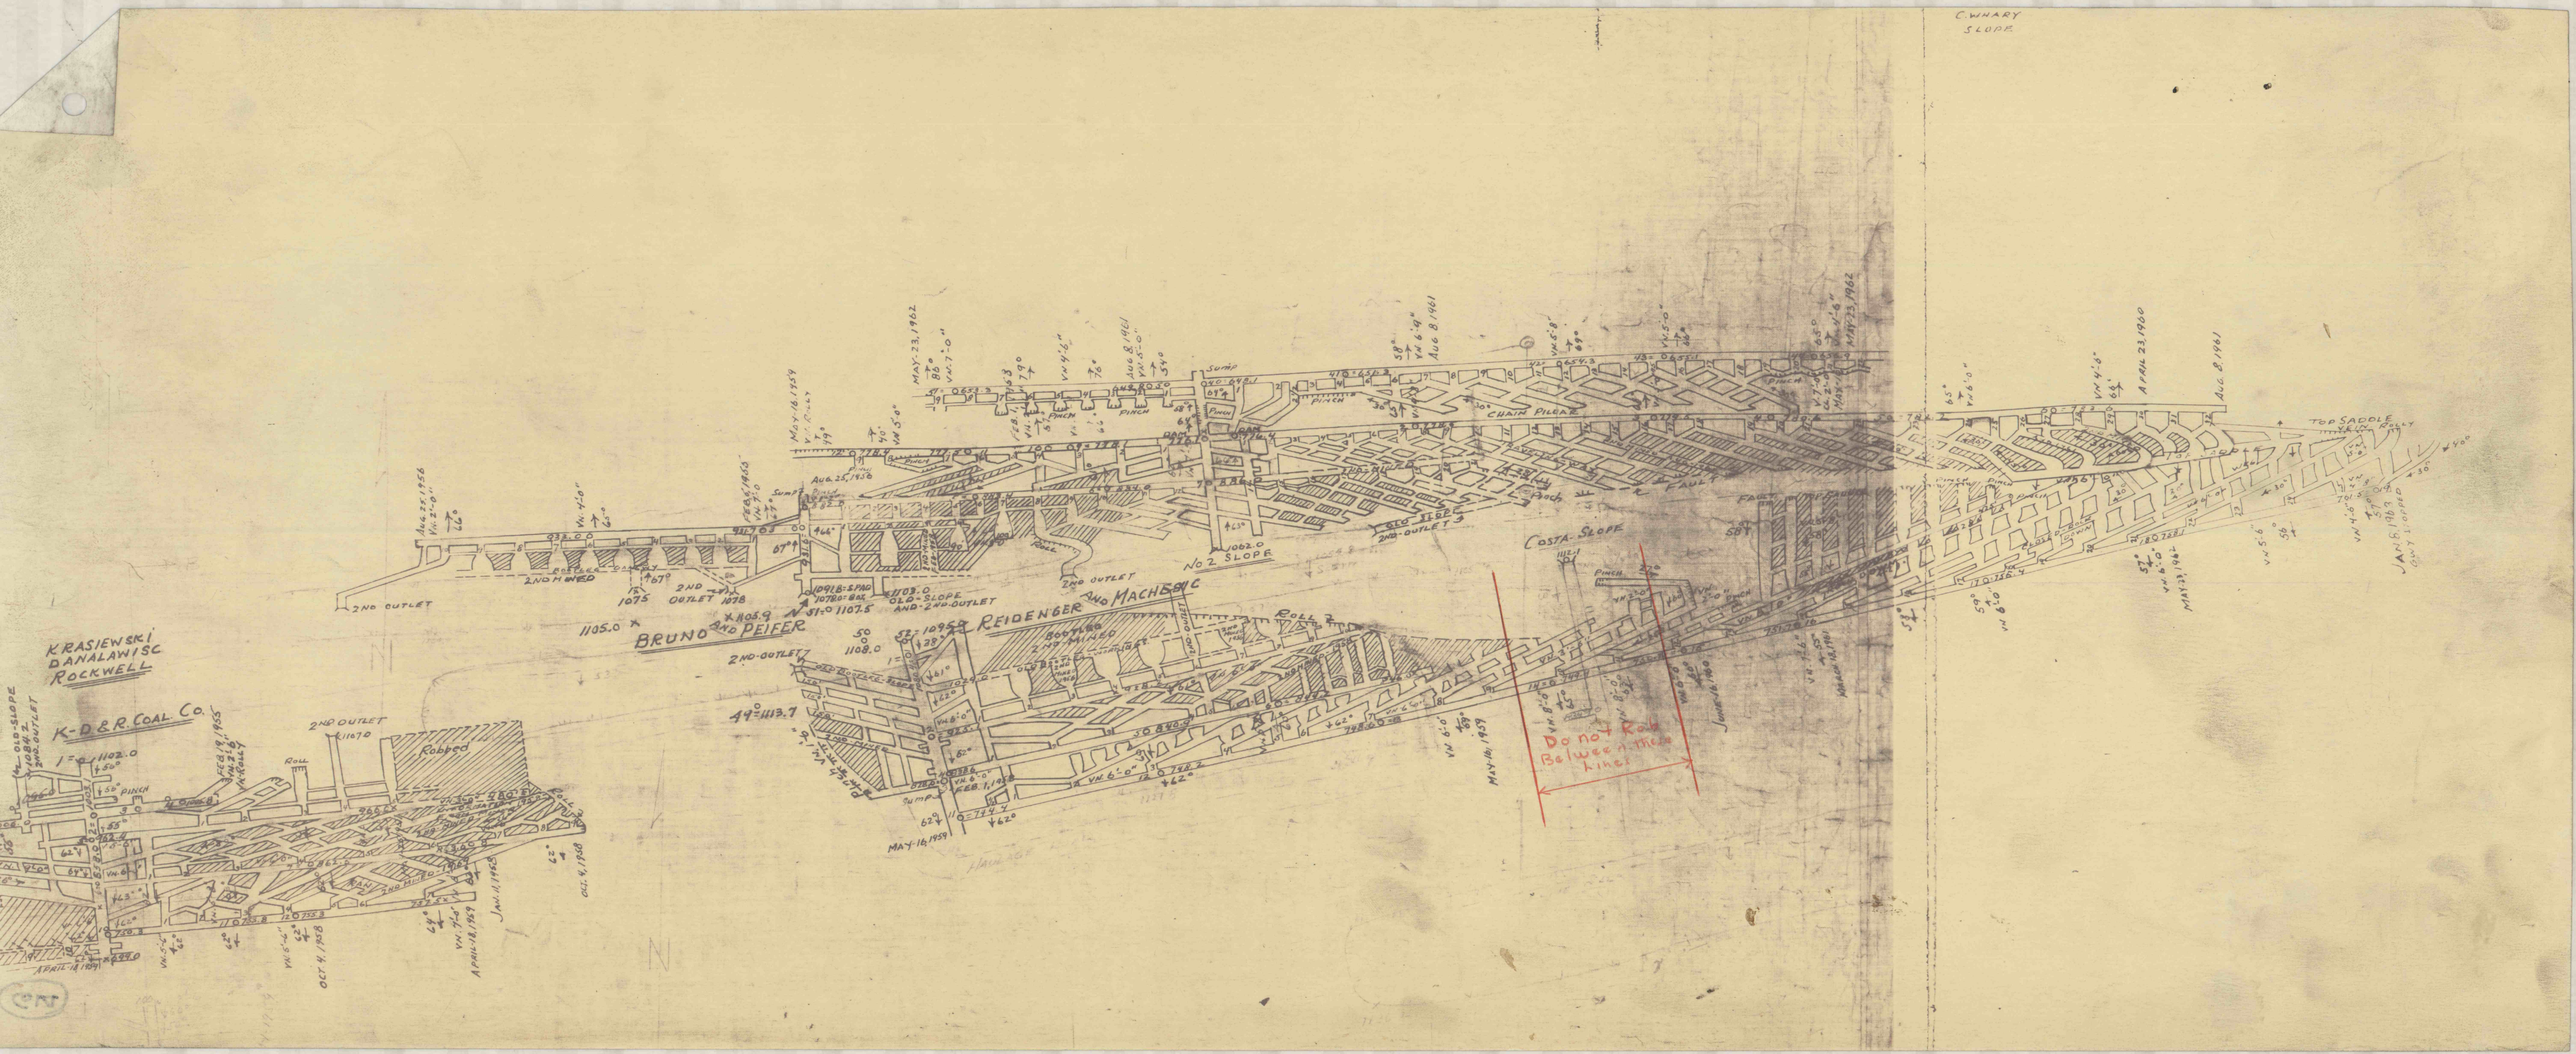
KRASIEWSKI
DANALAWISC
ROCKWELL
K-D & R COAL CO.
BRUNO AND PEIFER
REIDENGER AND MACHEWIC
NO 2 SLOPE
COSTA-SLOPE
CHAIN PILLAR
TOP SADDLE
Robbed
Do not Rob
Between the
Lines
2ND OUTLET
2ND HEADED
FAULT
PINCH
Roll
Sump
CWNARY
SLOPE