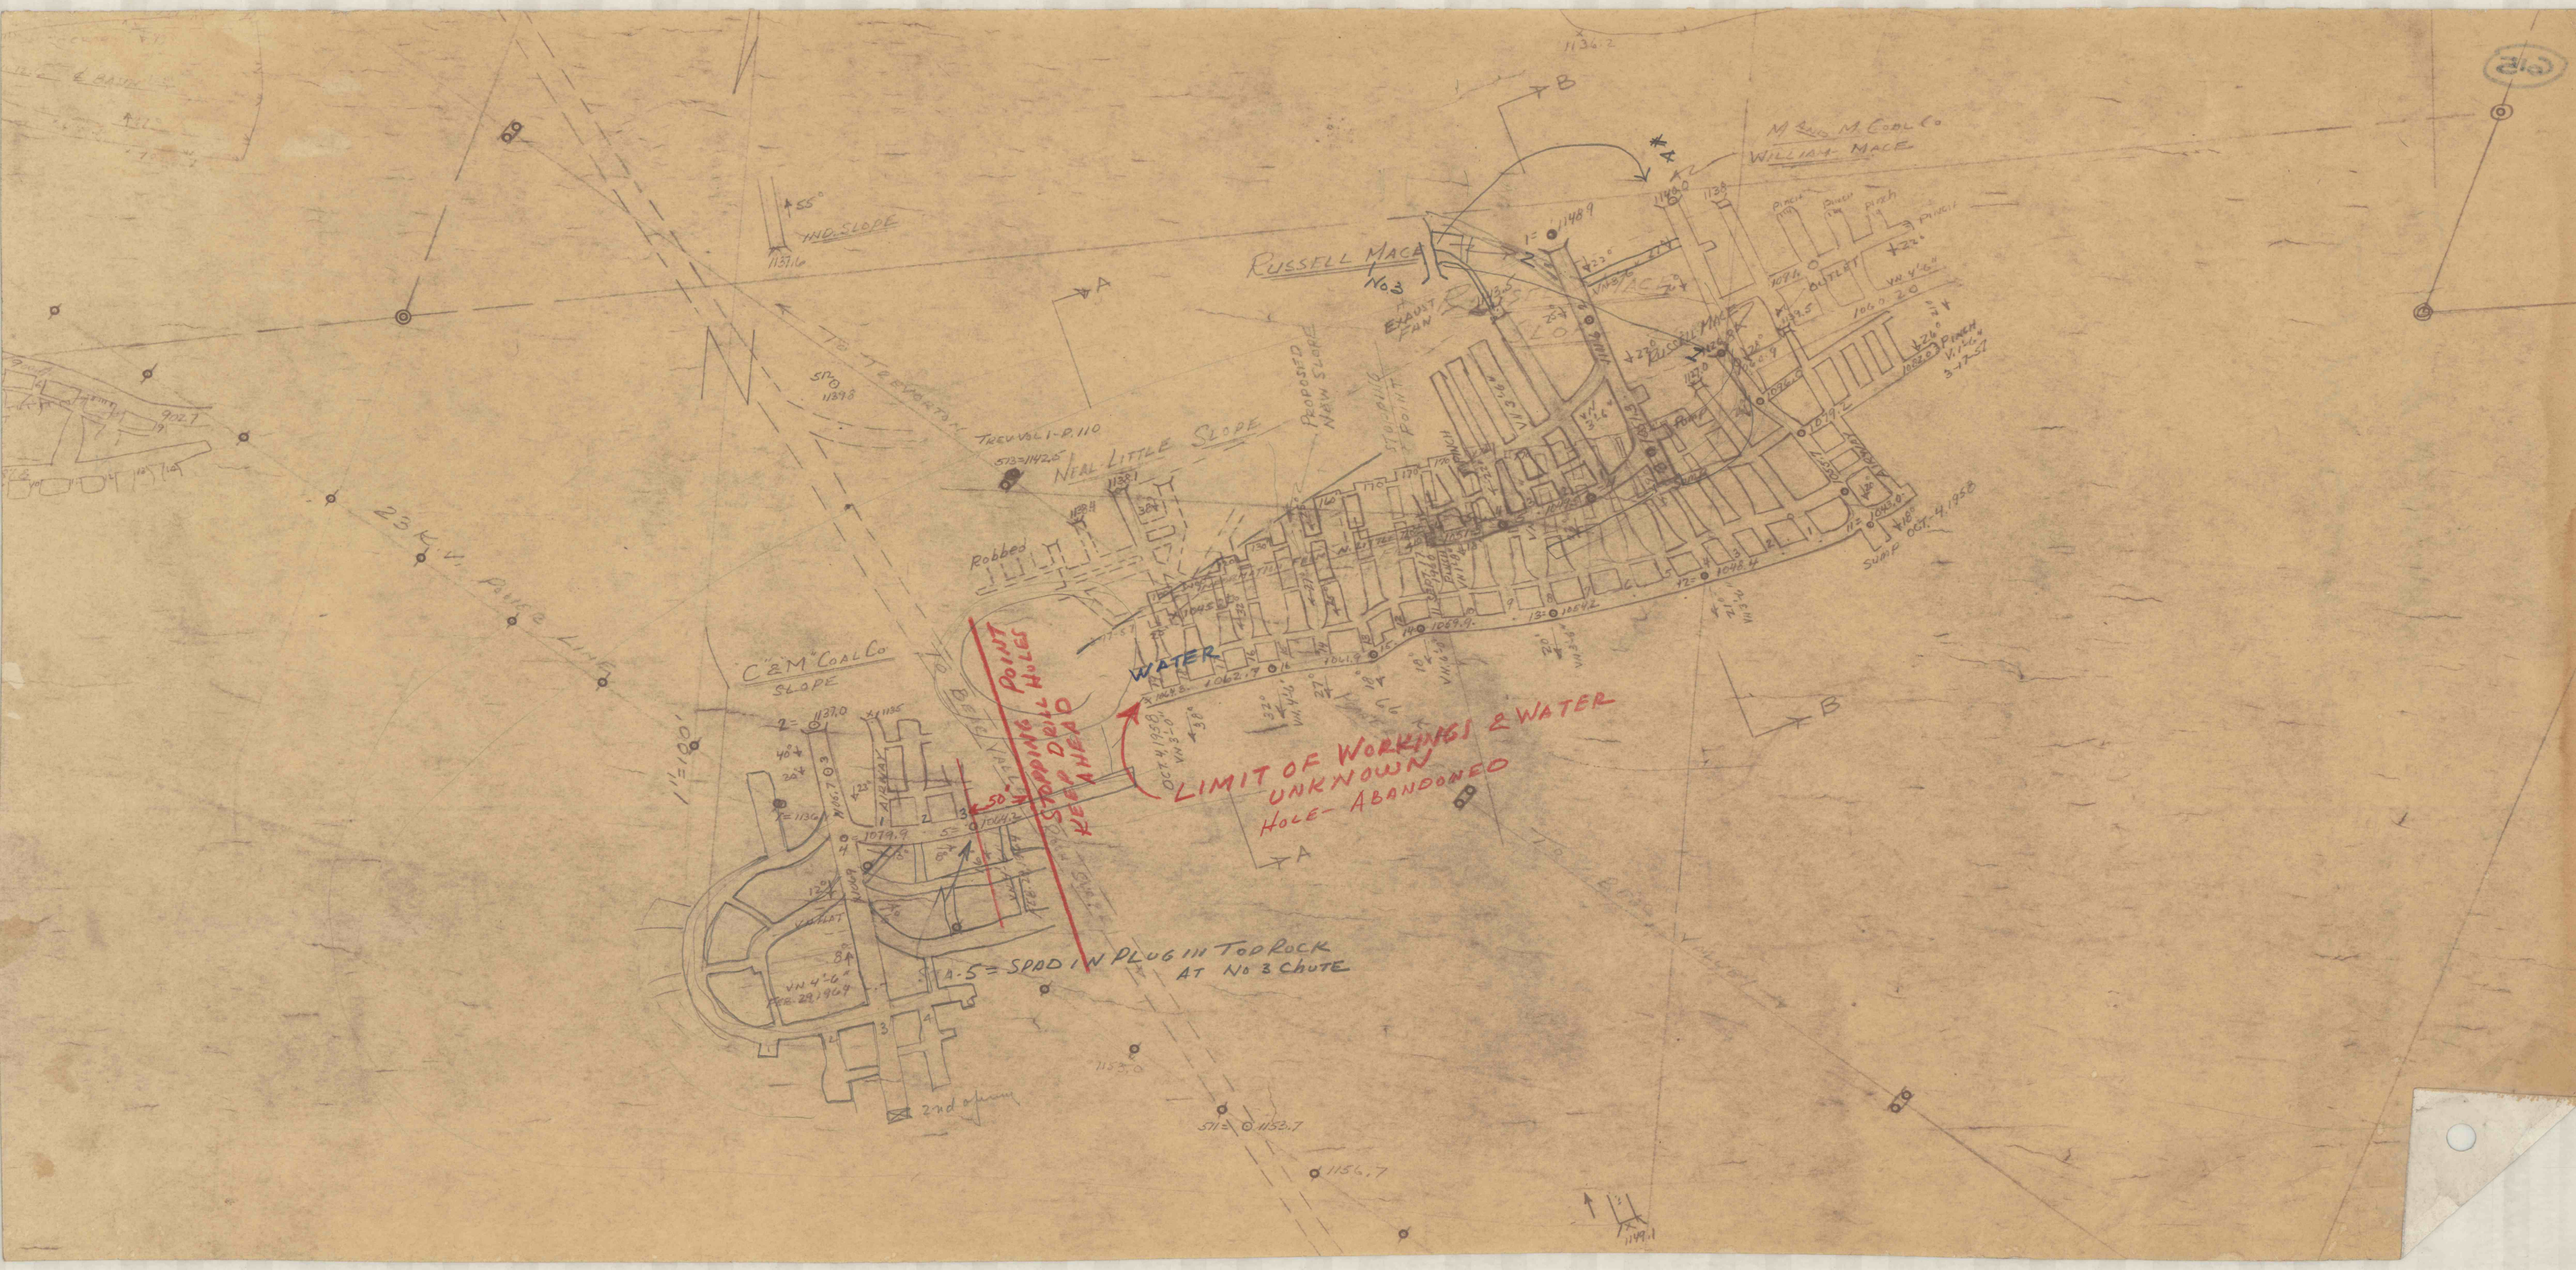
M & M COAL CO
WILLIAM MACE
RUSSELL MACE
No 3
EXHAUST FAN
NO. SLOPE
NEAL LITTLE SLOPE
PROPOSED NEW SLOPE
TROUBLE POINT
Robbed
C & M COAL CO
SLOPE
WATER
LIMIT OF WORKINGS & WATER UNKNOWN
HOLE - ABANDONED
LIMIT OF WORKINGS
HOLE ABANDONED
50'
4.5 = SPOD IN PLUG IN TOD ROCK AT No 3 CHUTE
2nd opening
23 K.V. Power Line
OUTLET
SUMP
OCT. 4, 1958