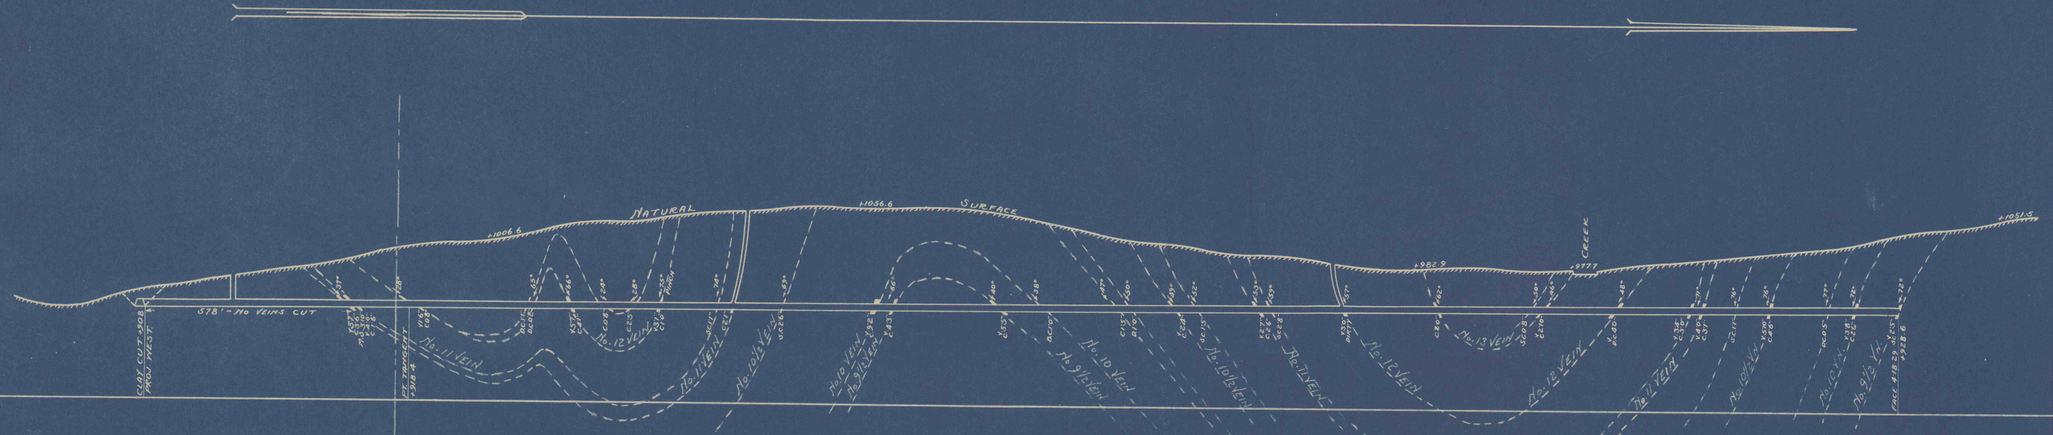


SUSQUEHANNA COLLIERIES CO.
MT. CARMEL, PA.

CROSS SECTION THROUGH NORTH MOUNTAIN
TUNNEL OF THE P.&R.C.&I. CO. 6100' WEST
OF BEAR VALLEY SHAFT
Scale 1"=100'

Aug. 6, 1934.

From 75' West
Lyc. Co. Lands
Zimmerman & Heller
Tracts

36