


U13

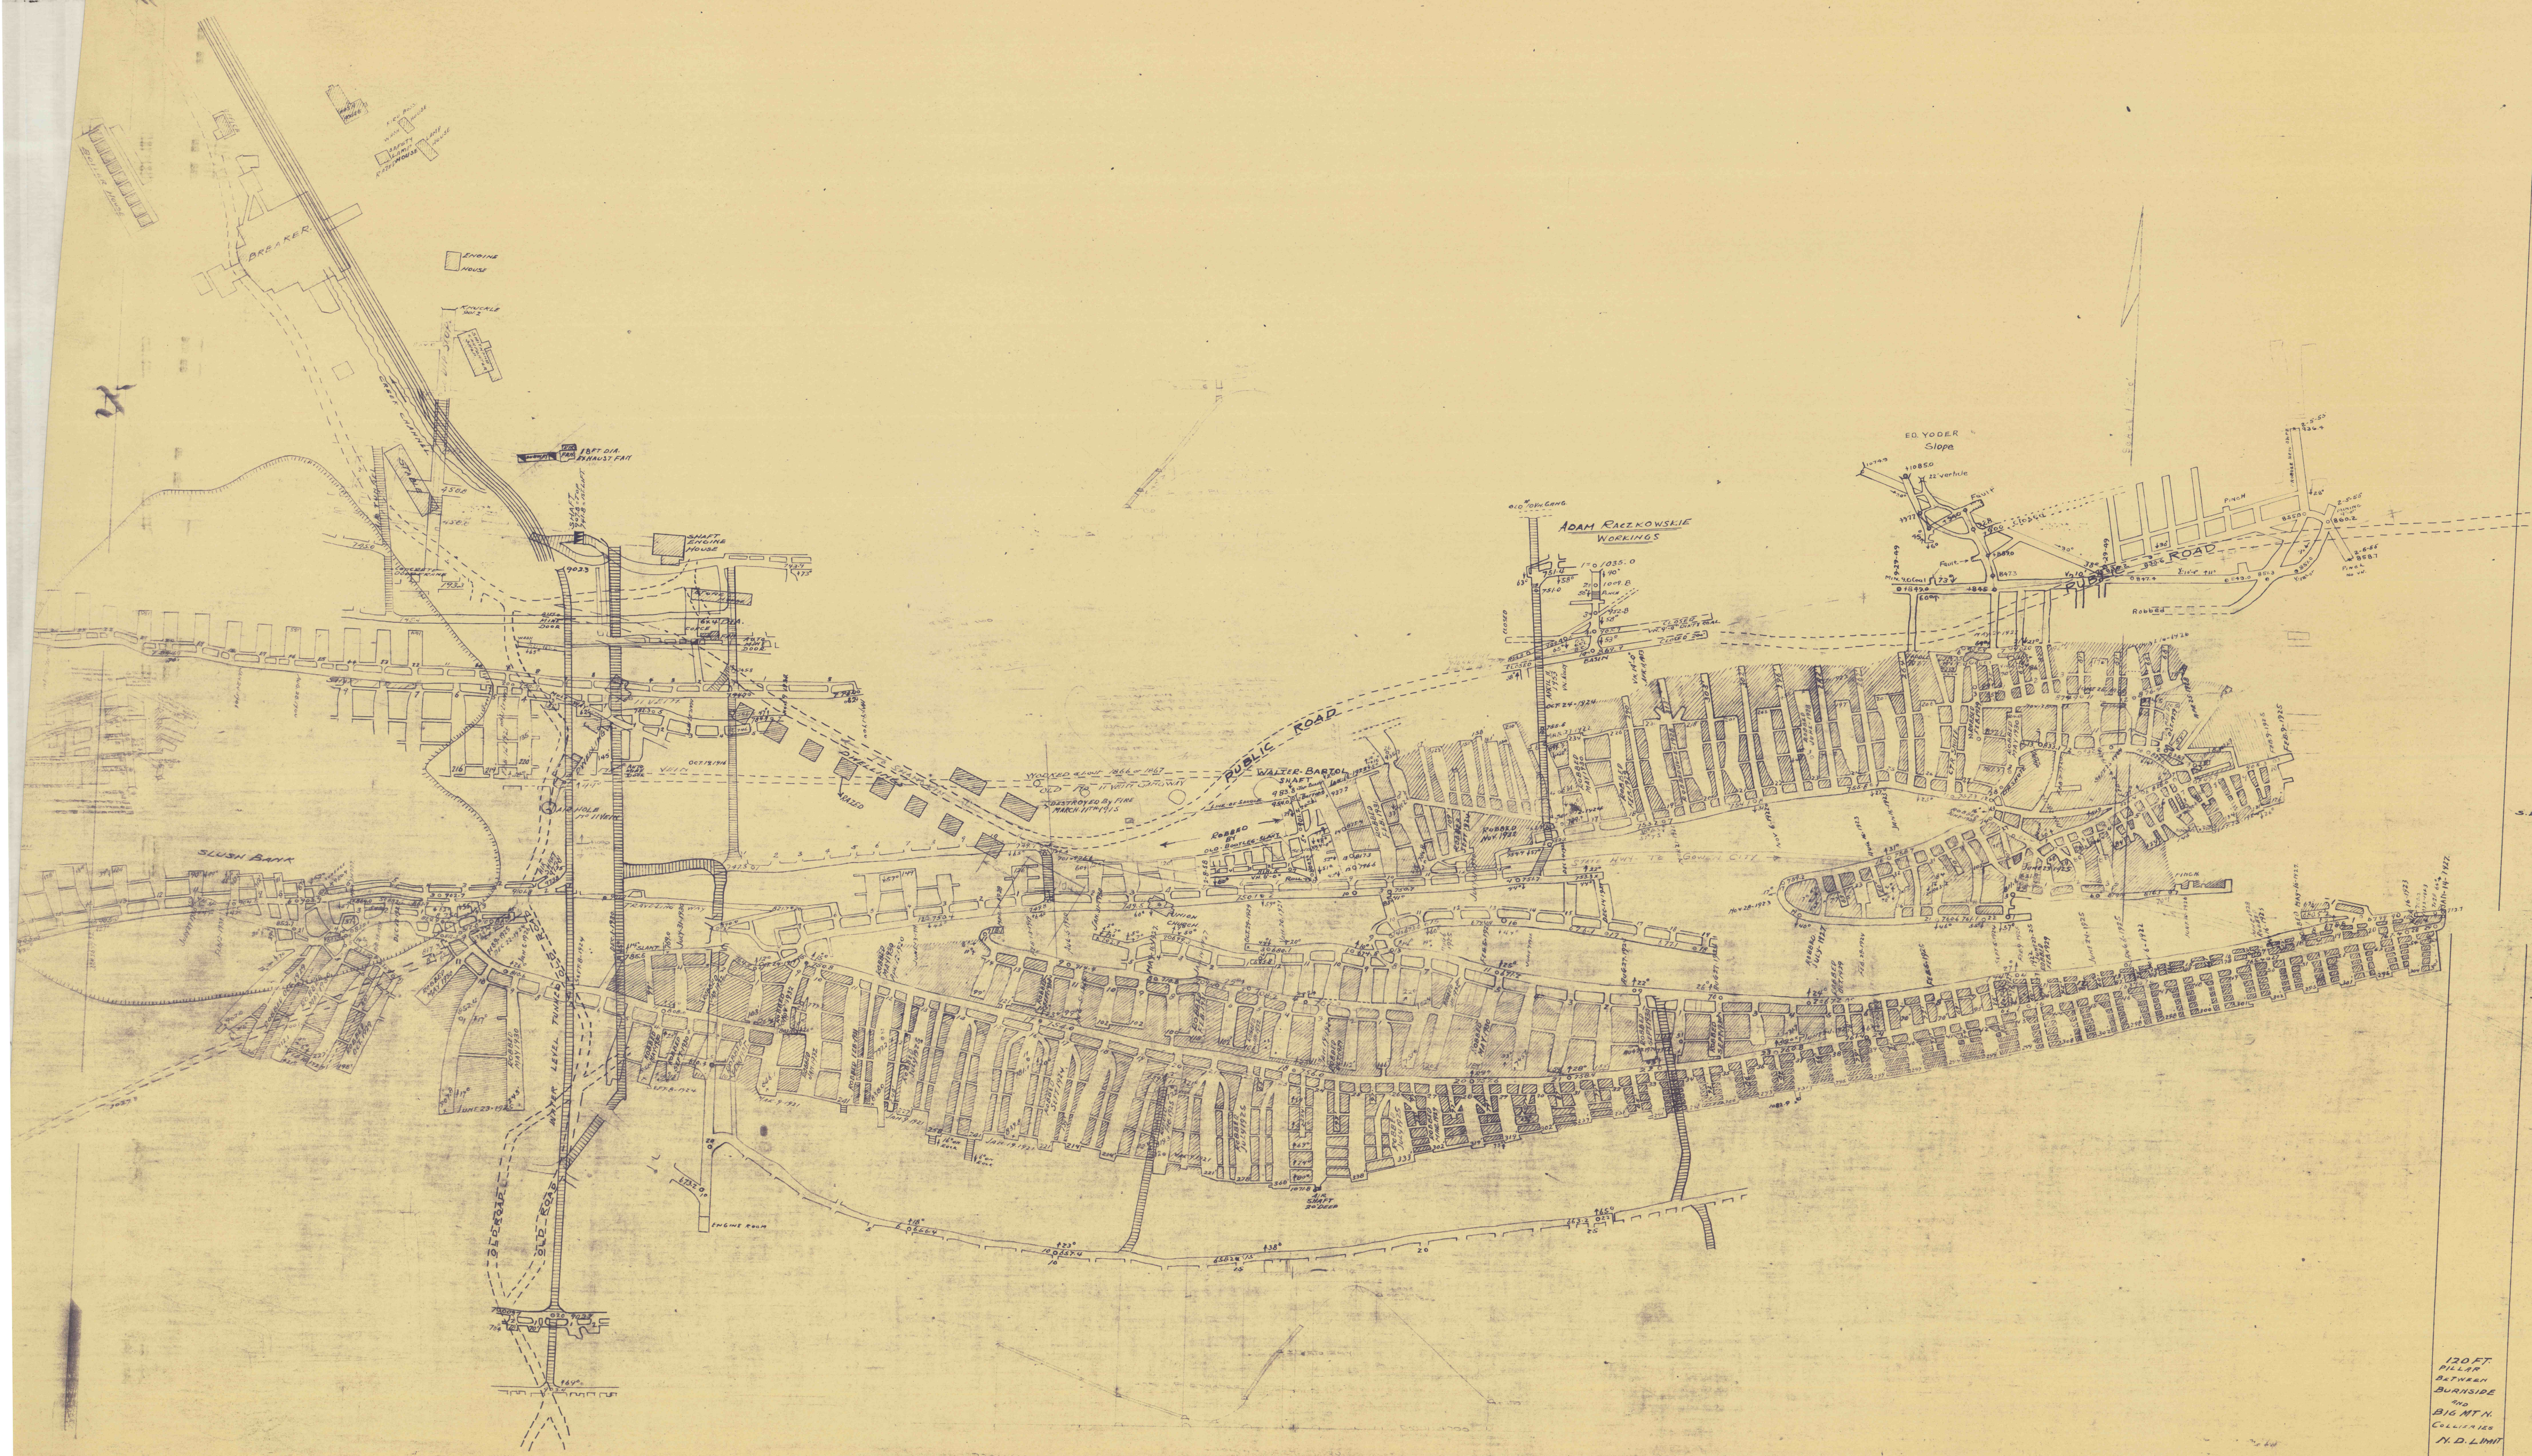

120 FT.
PILLAR
BETWEEN
BURNSIDE
AND
BIG MT. N.
COLLIERIES
N.D. LIMIT