


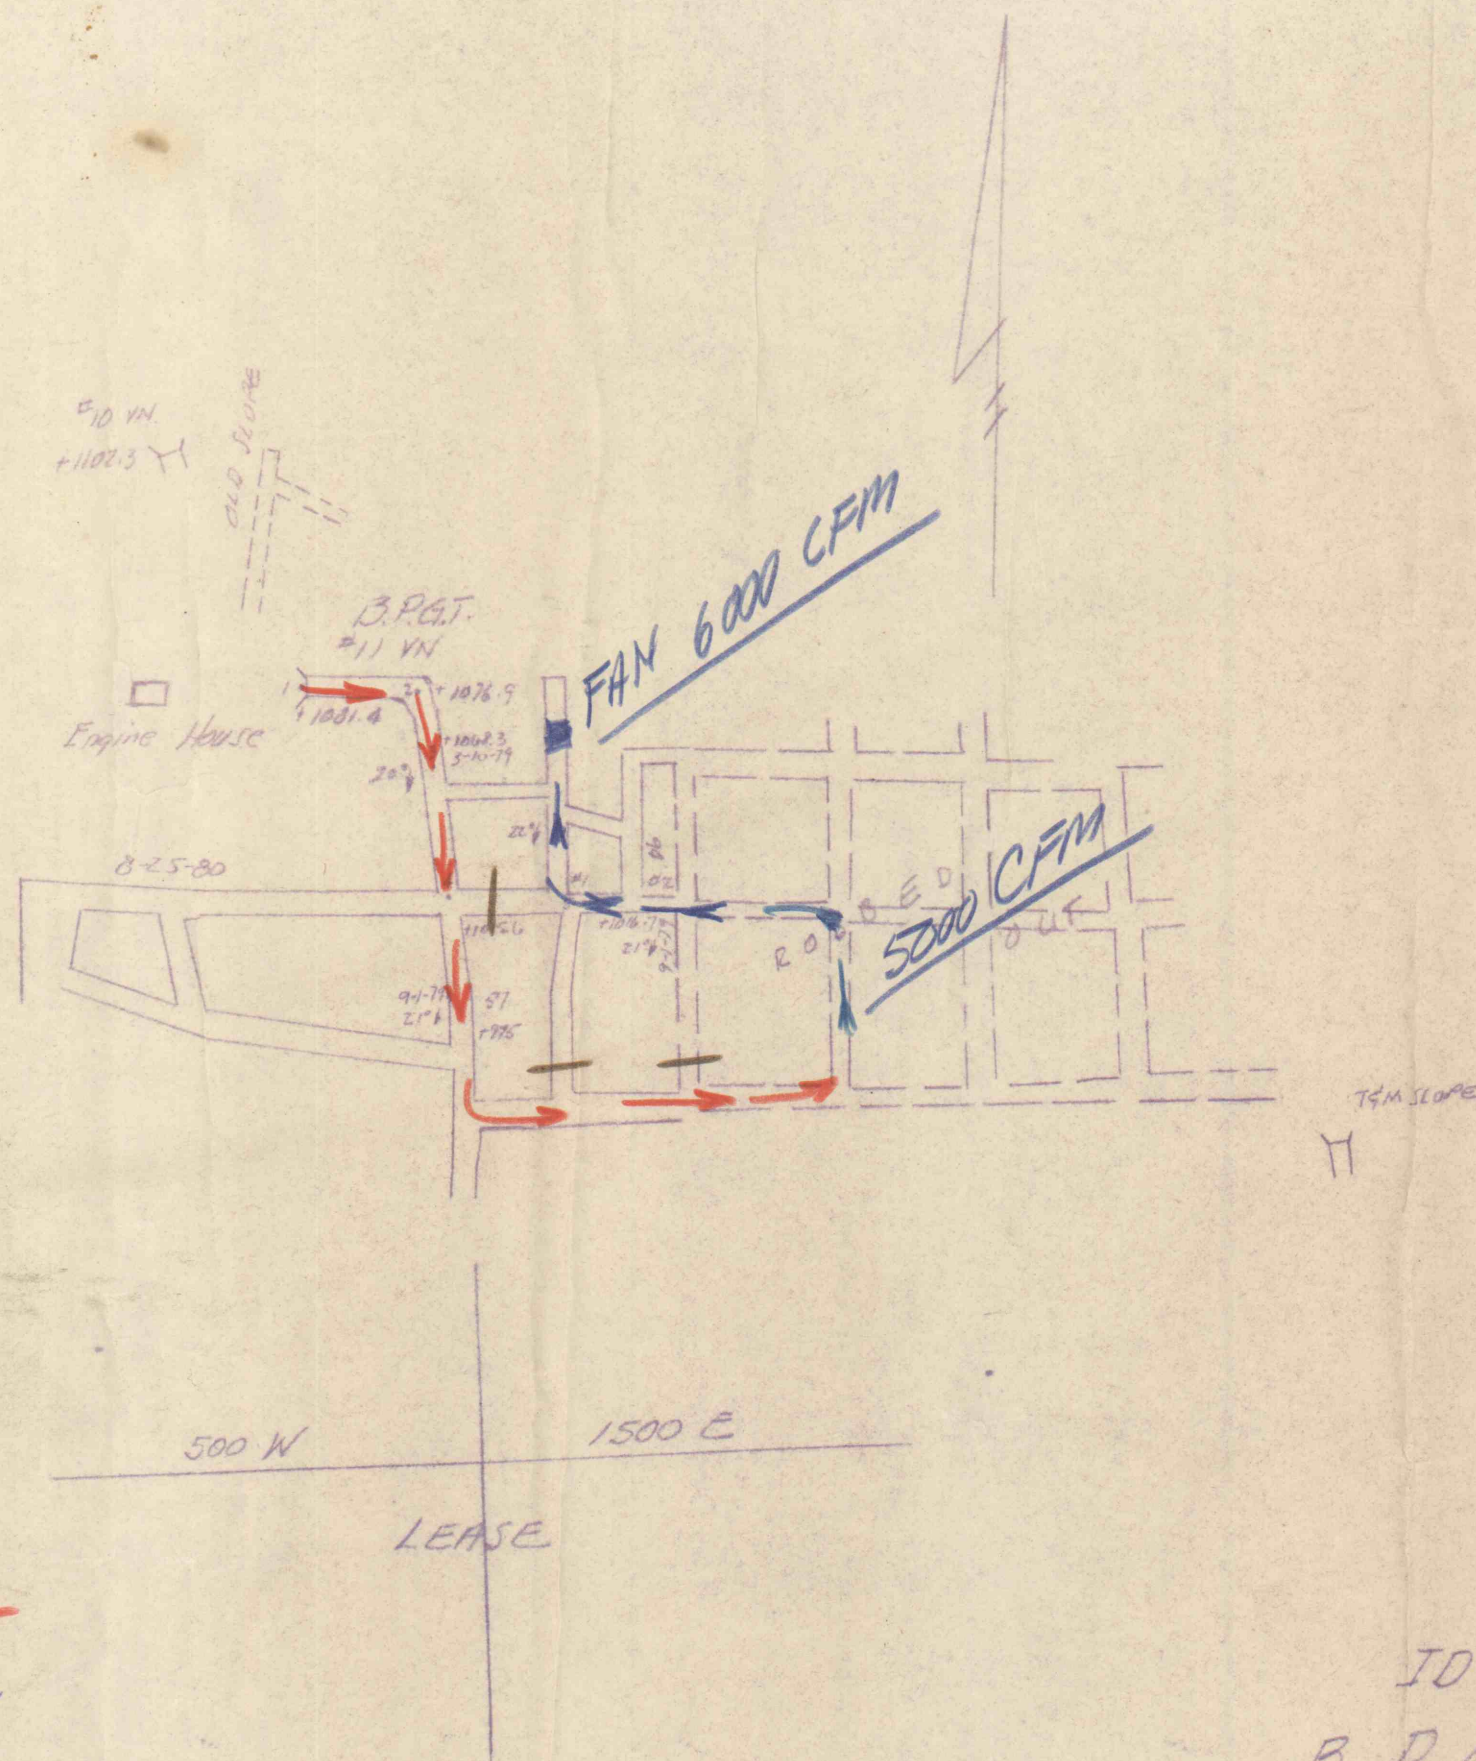

→ Intake Air
→ Exhaust Air
— Stopping

ID# 36-06730
B. P. G. T. COAL CO.
#11 VEIN

ZERBE TOWNSHIP
NORTHUMBERLAND COUNTY, PA.

1"-100"

