


051

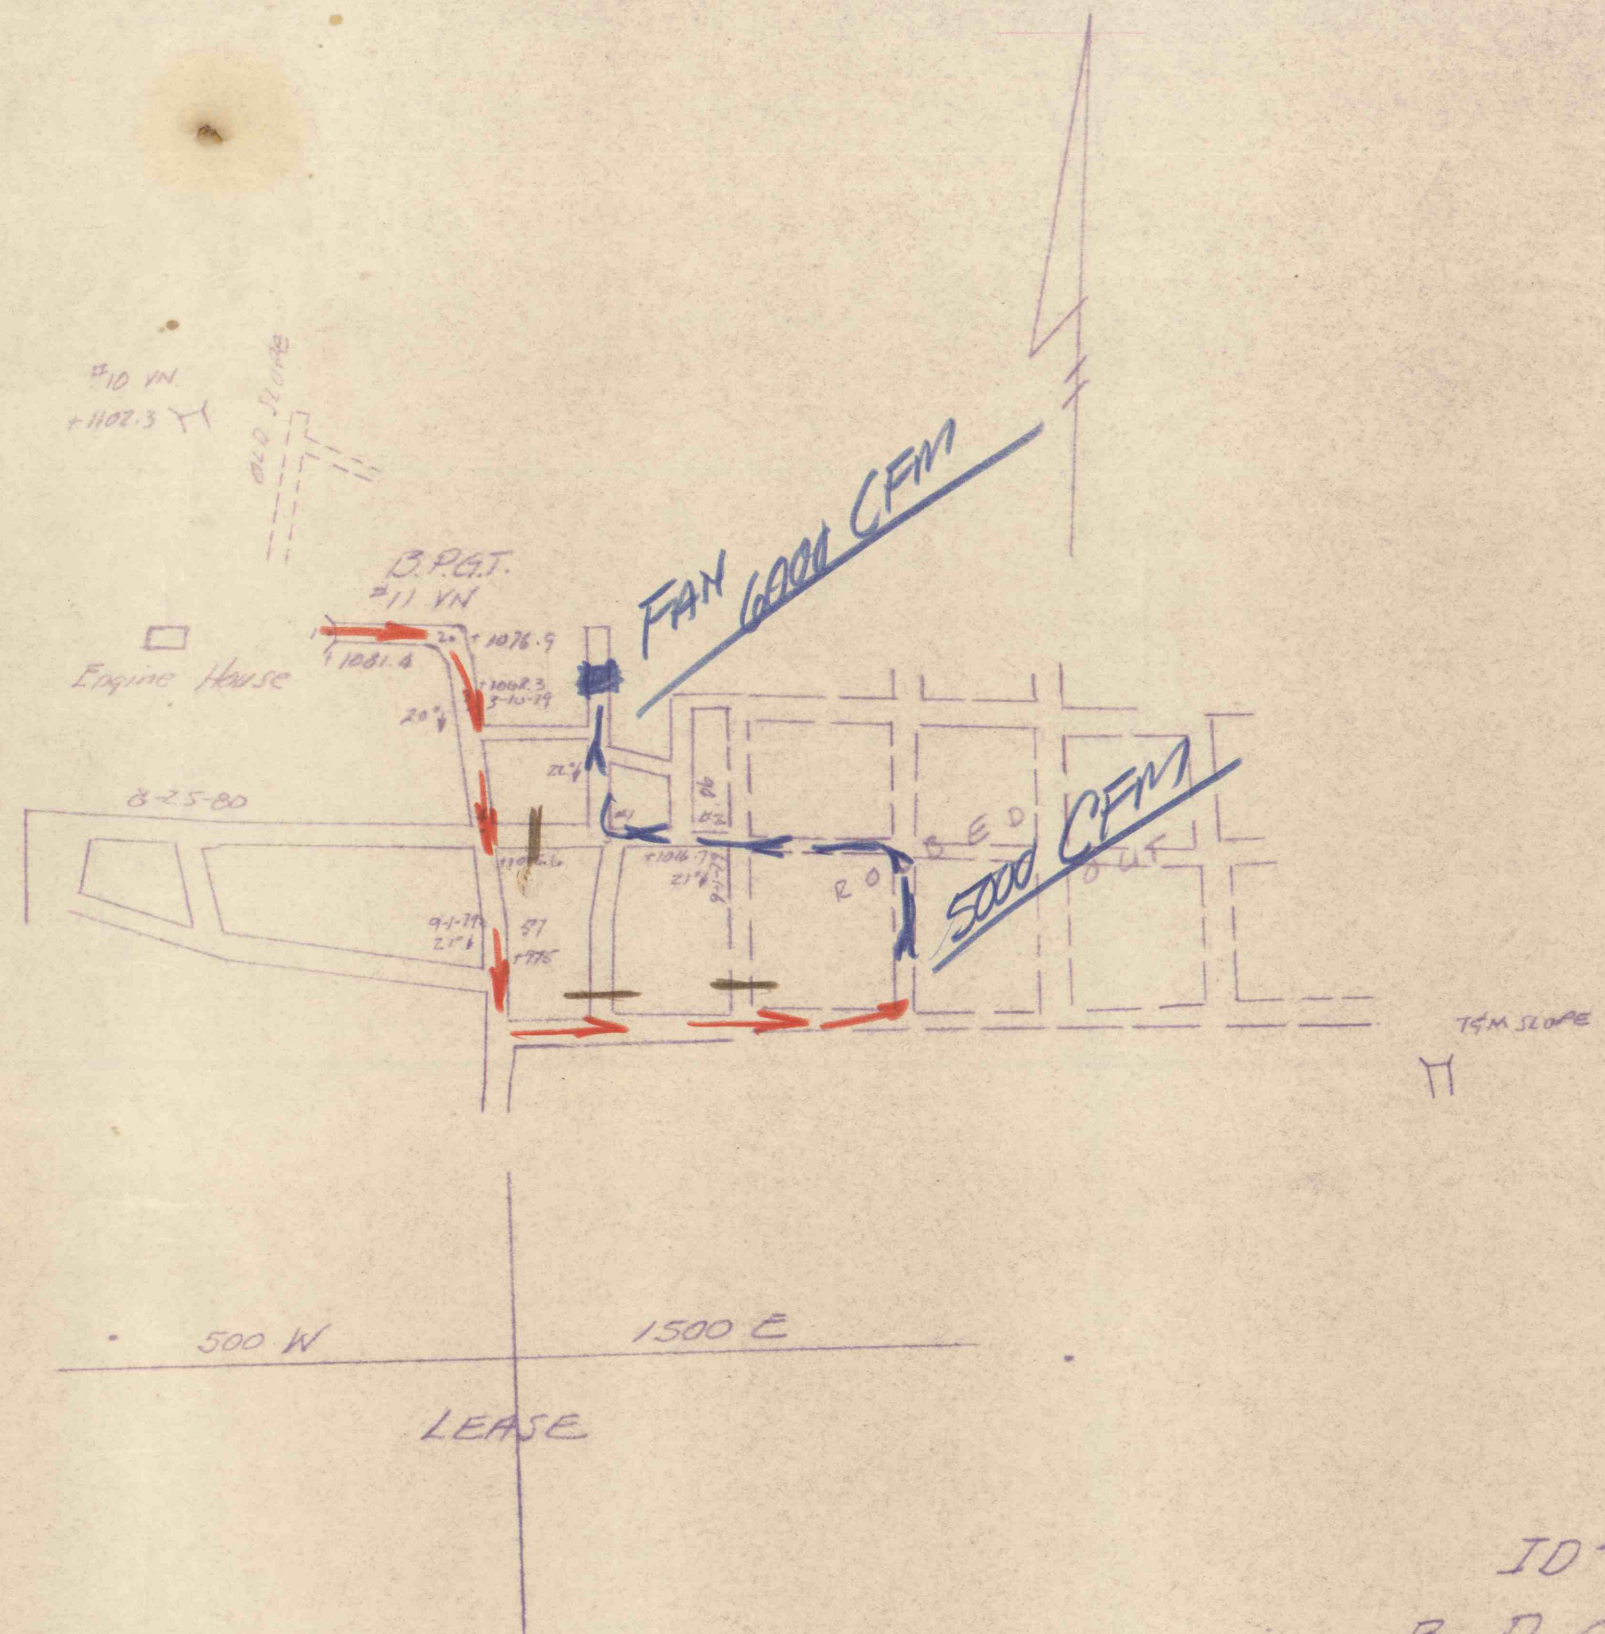

→ Intake Air
→ Exhaust Air
— Stopping

ID# 36-06730
B. P. G. T. COAL CO.
#11 VEIN
ZERBE TOWNSHIP
NORTHUMBERLAND COUNTY, PA.
1"=100'

