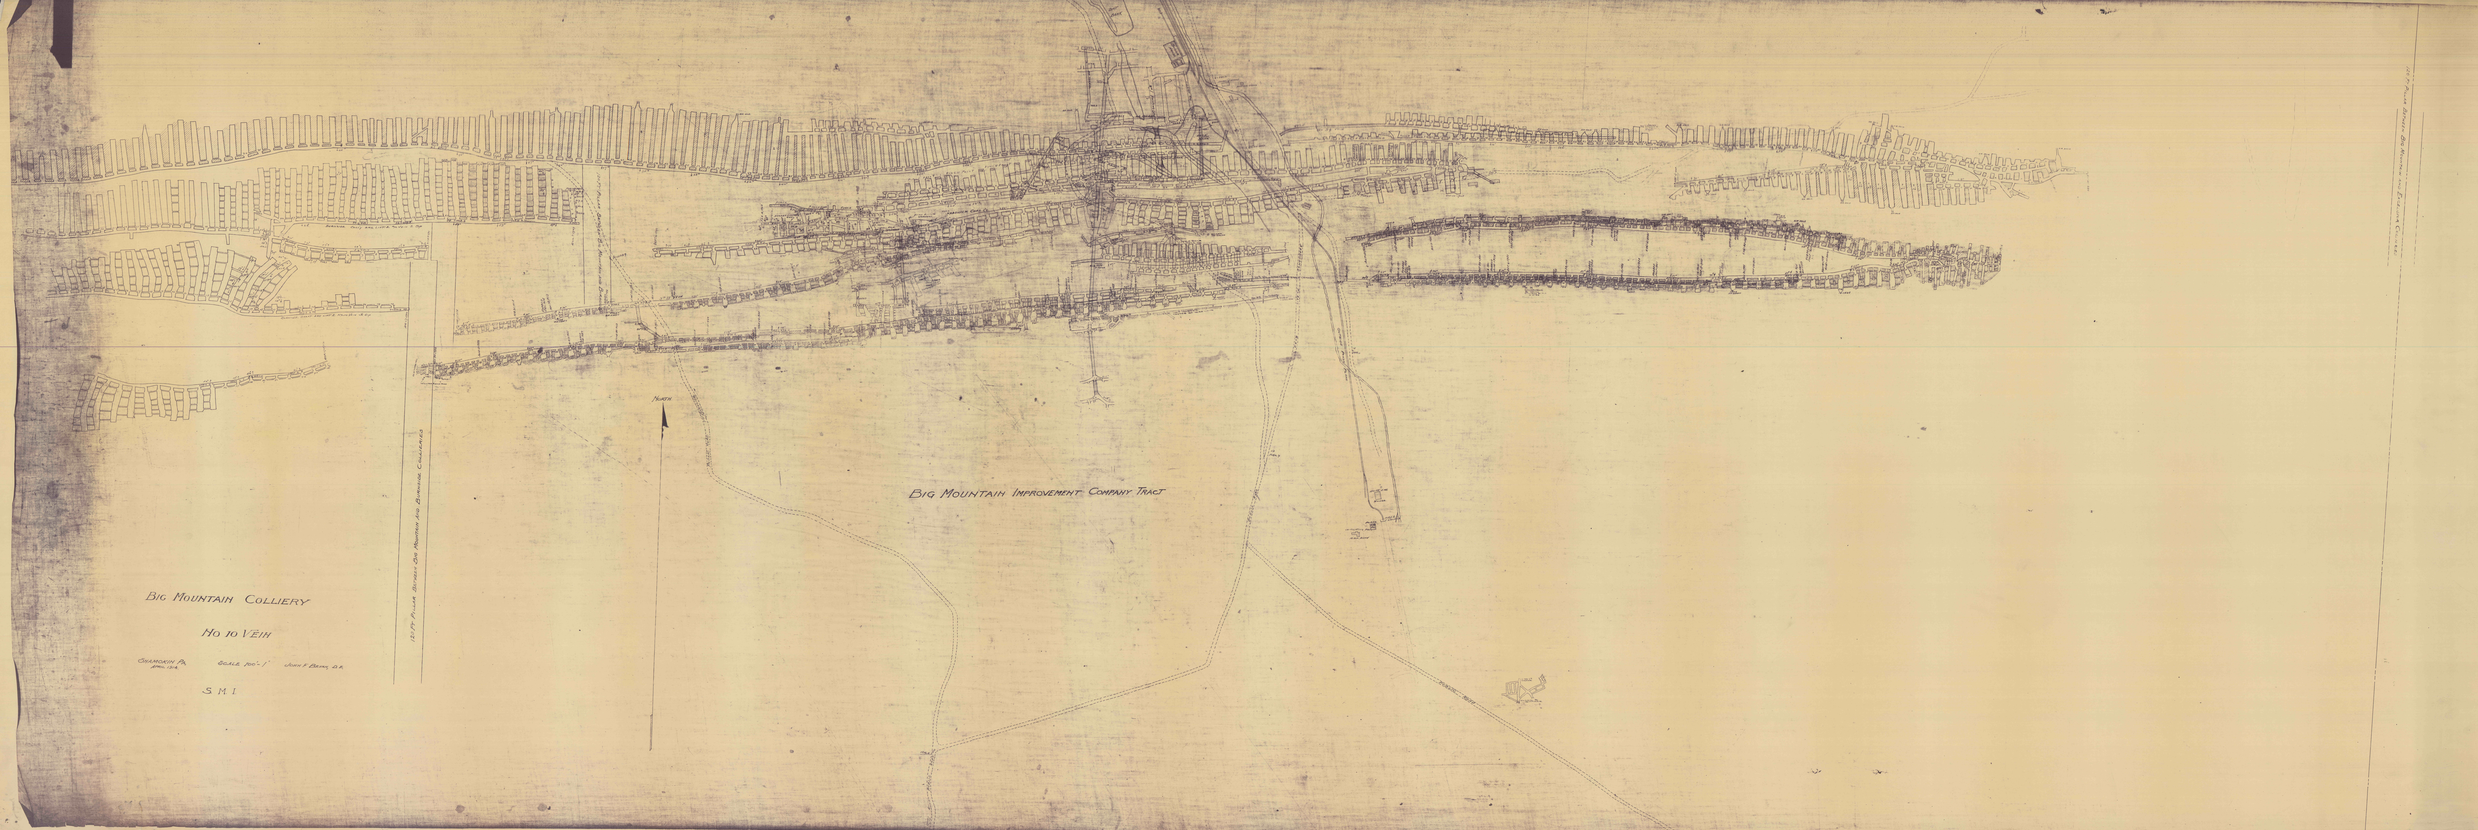


Big Mountain Colliery

No 10 Vein

Shamokin Pa. April 1914. Scale 100 - 1" John F. Berry, C.E.

S.M.I.