
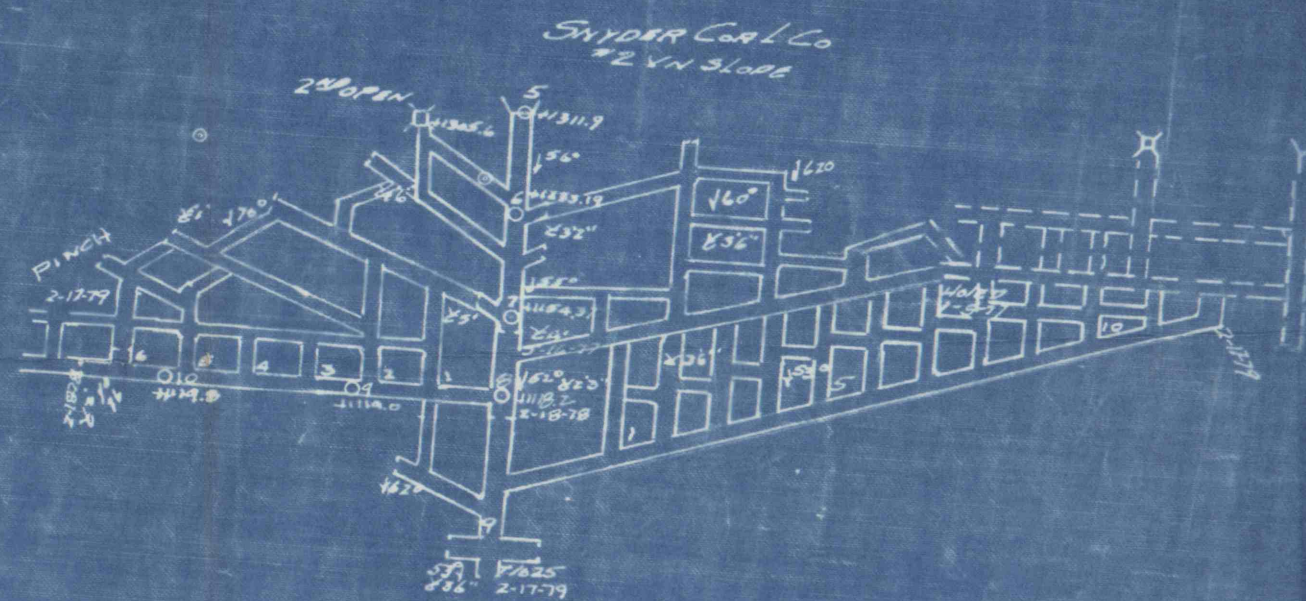


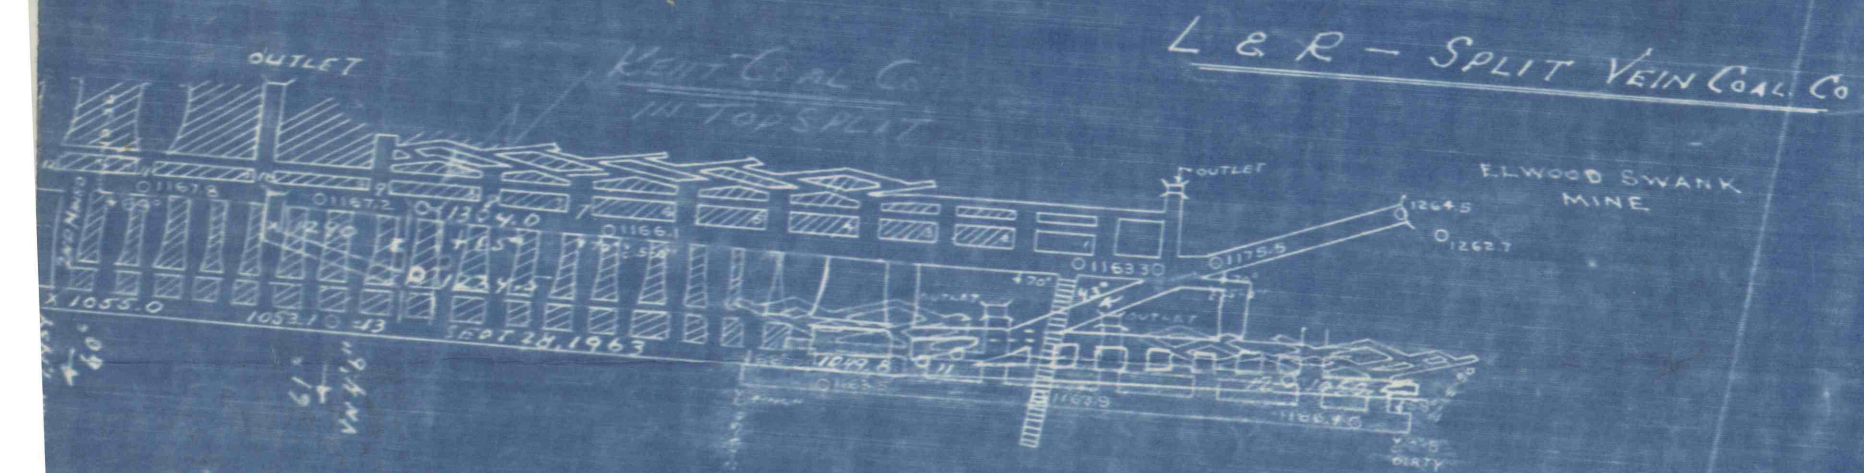

ASSOCIATE LANDS