


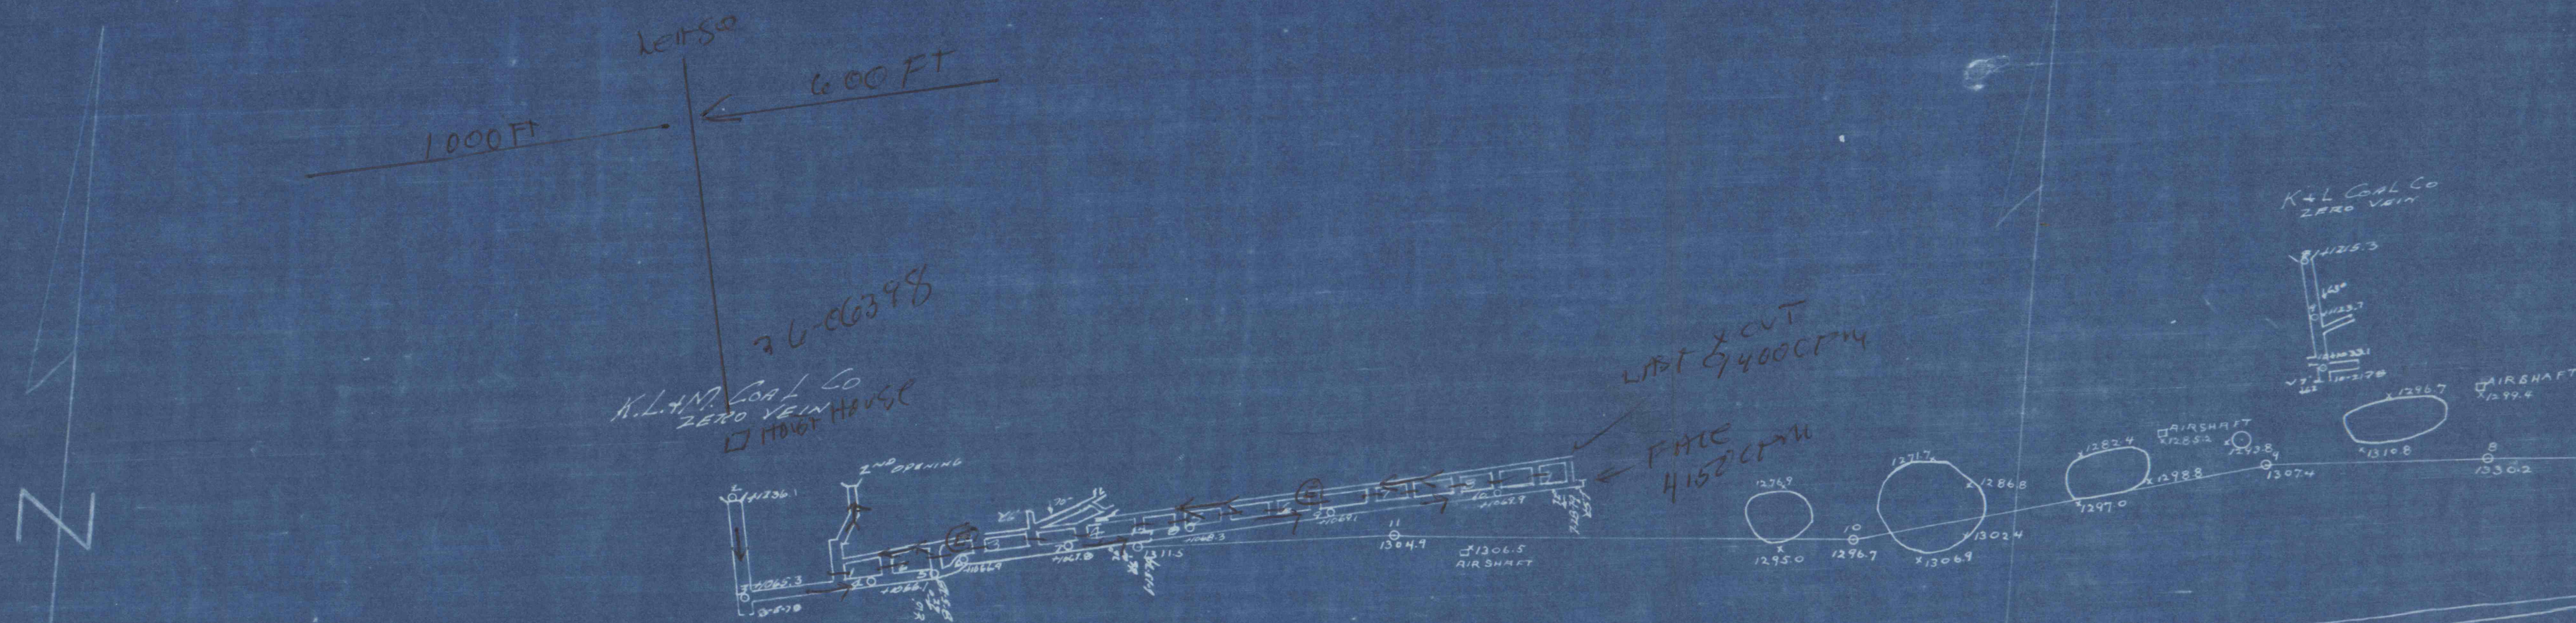

7-28-79

