


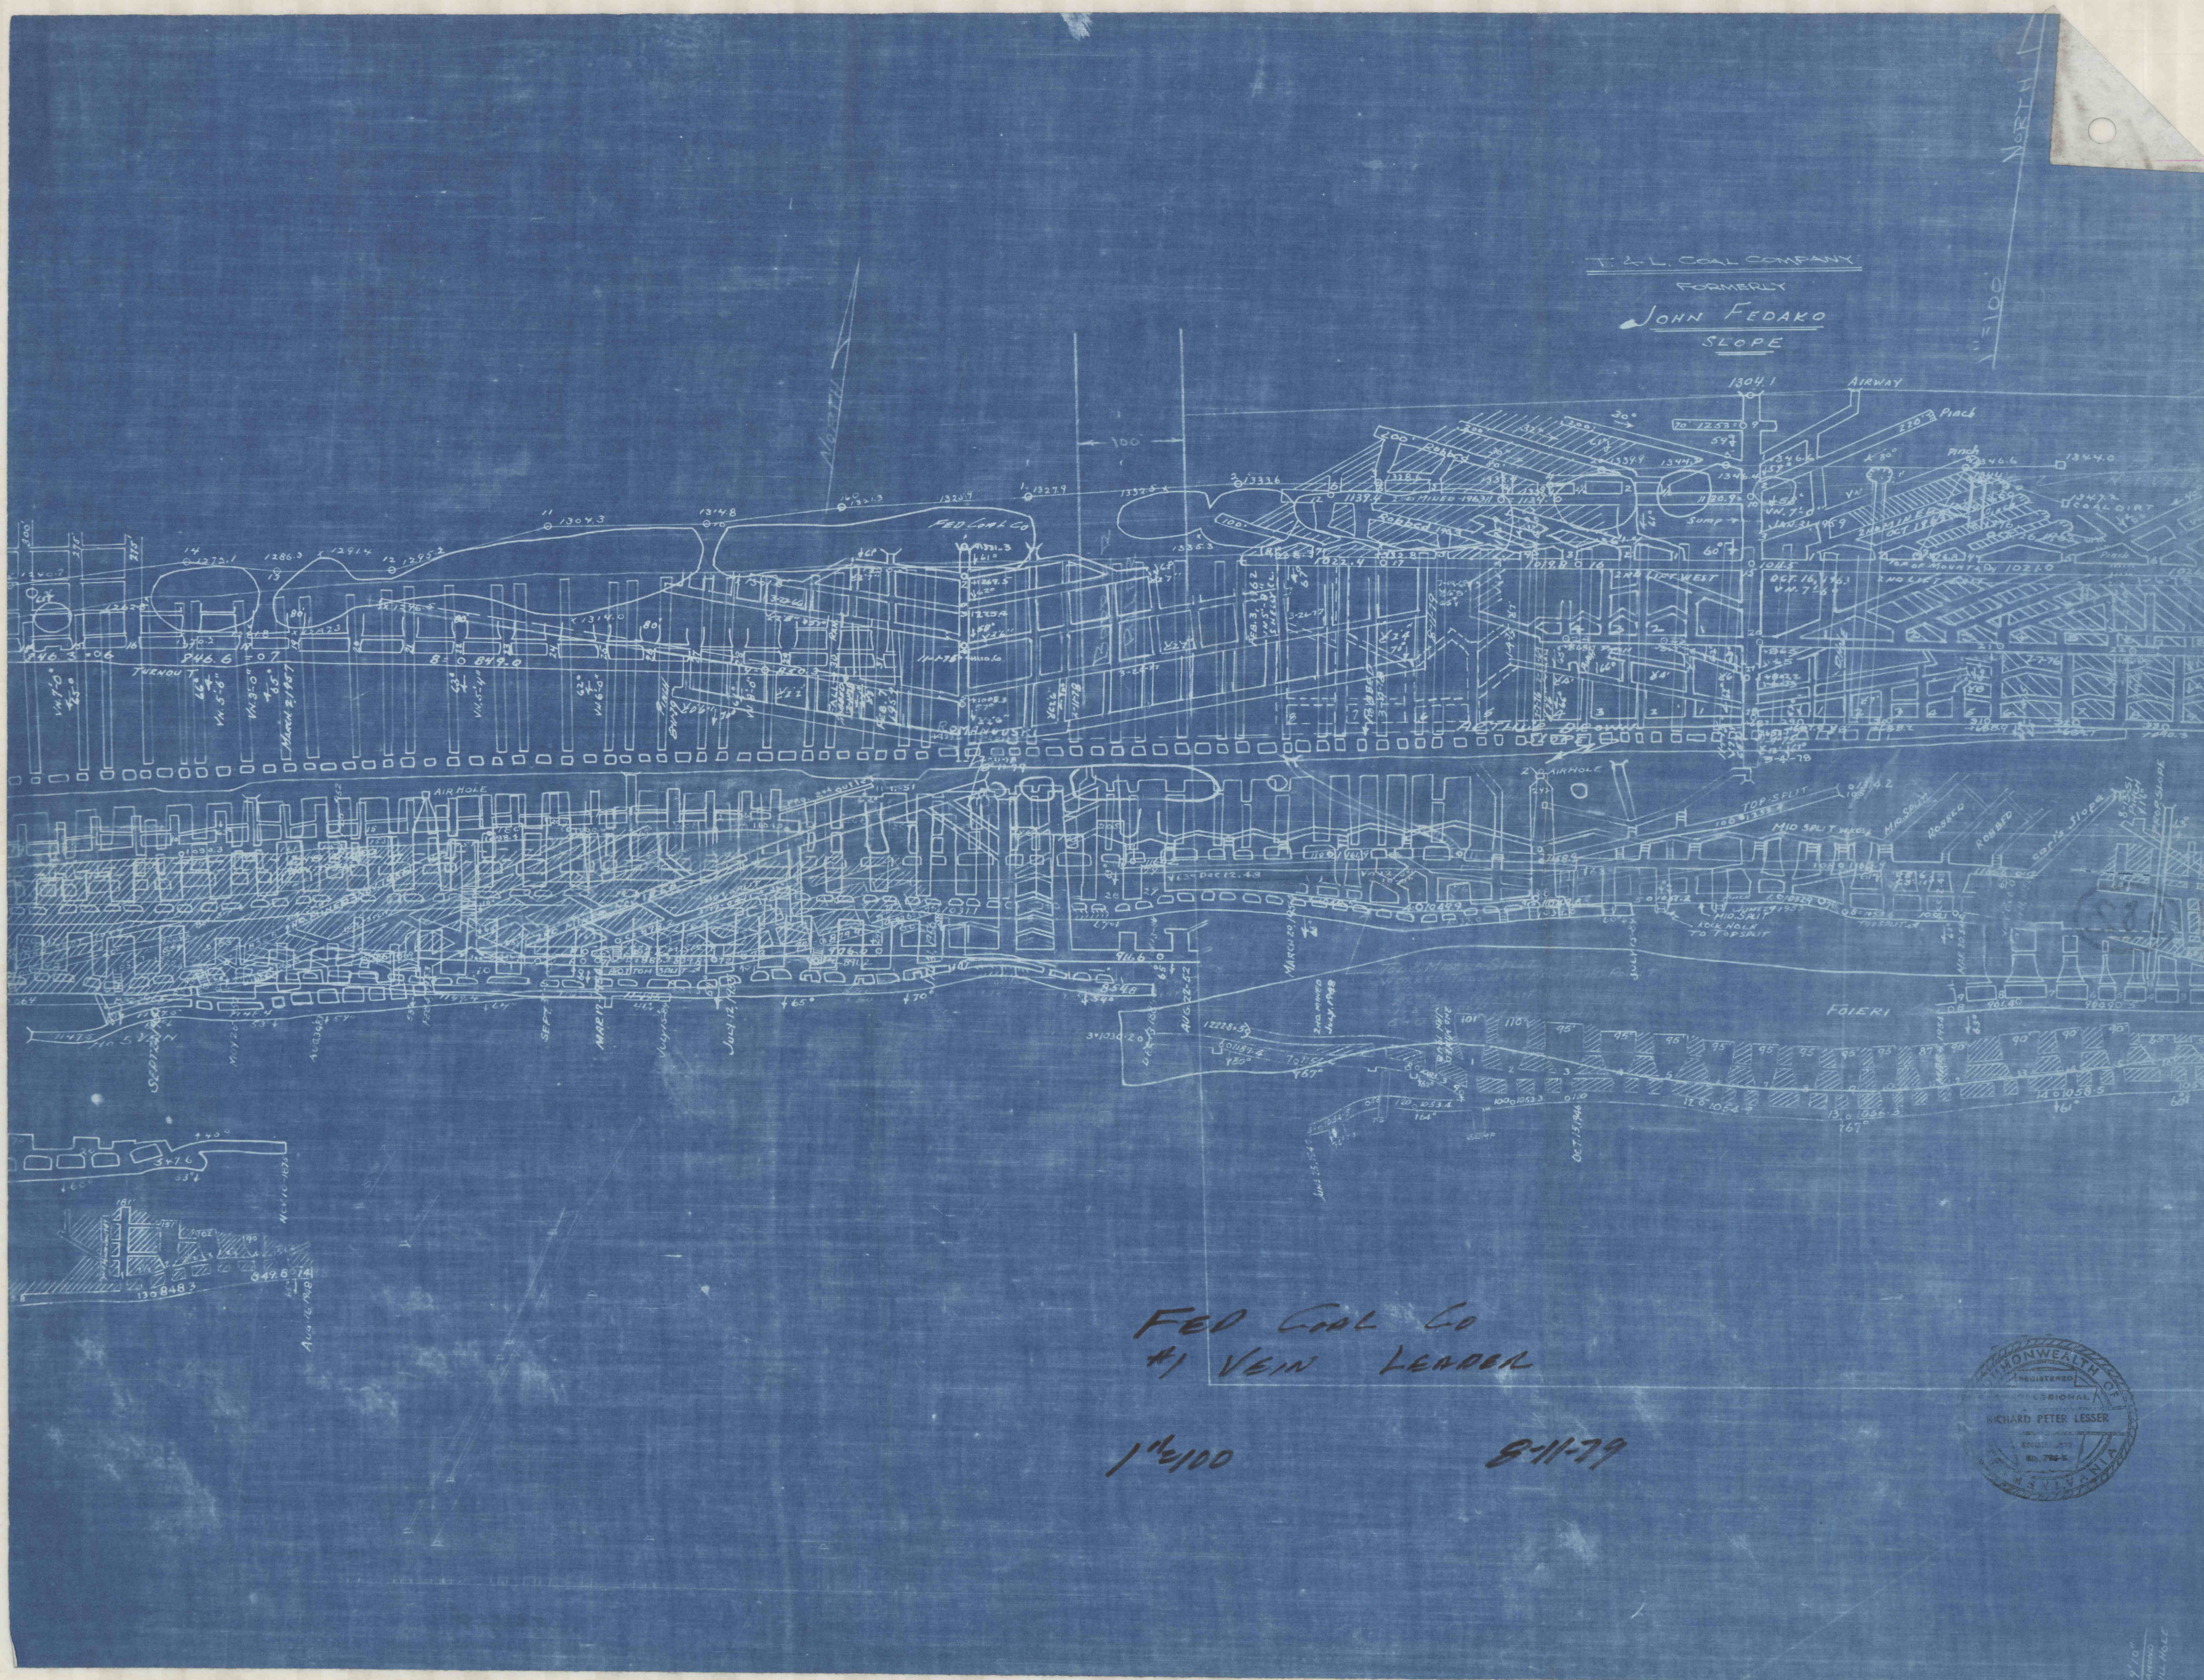

T. & L. COAL COMPANY
FORMERLY
JOHN FEDAKO
SLOPE

FED COAL CO
#1 VEIN LEADER

1"=100

8-11-79

