


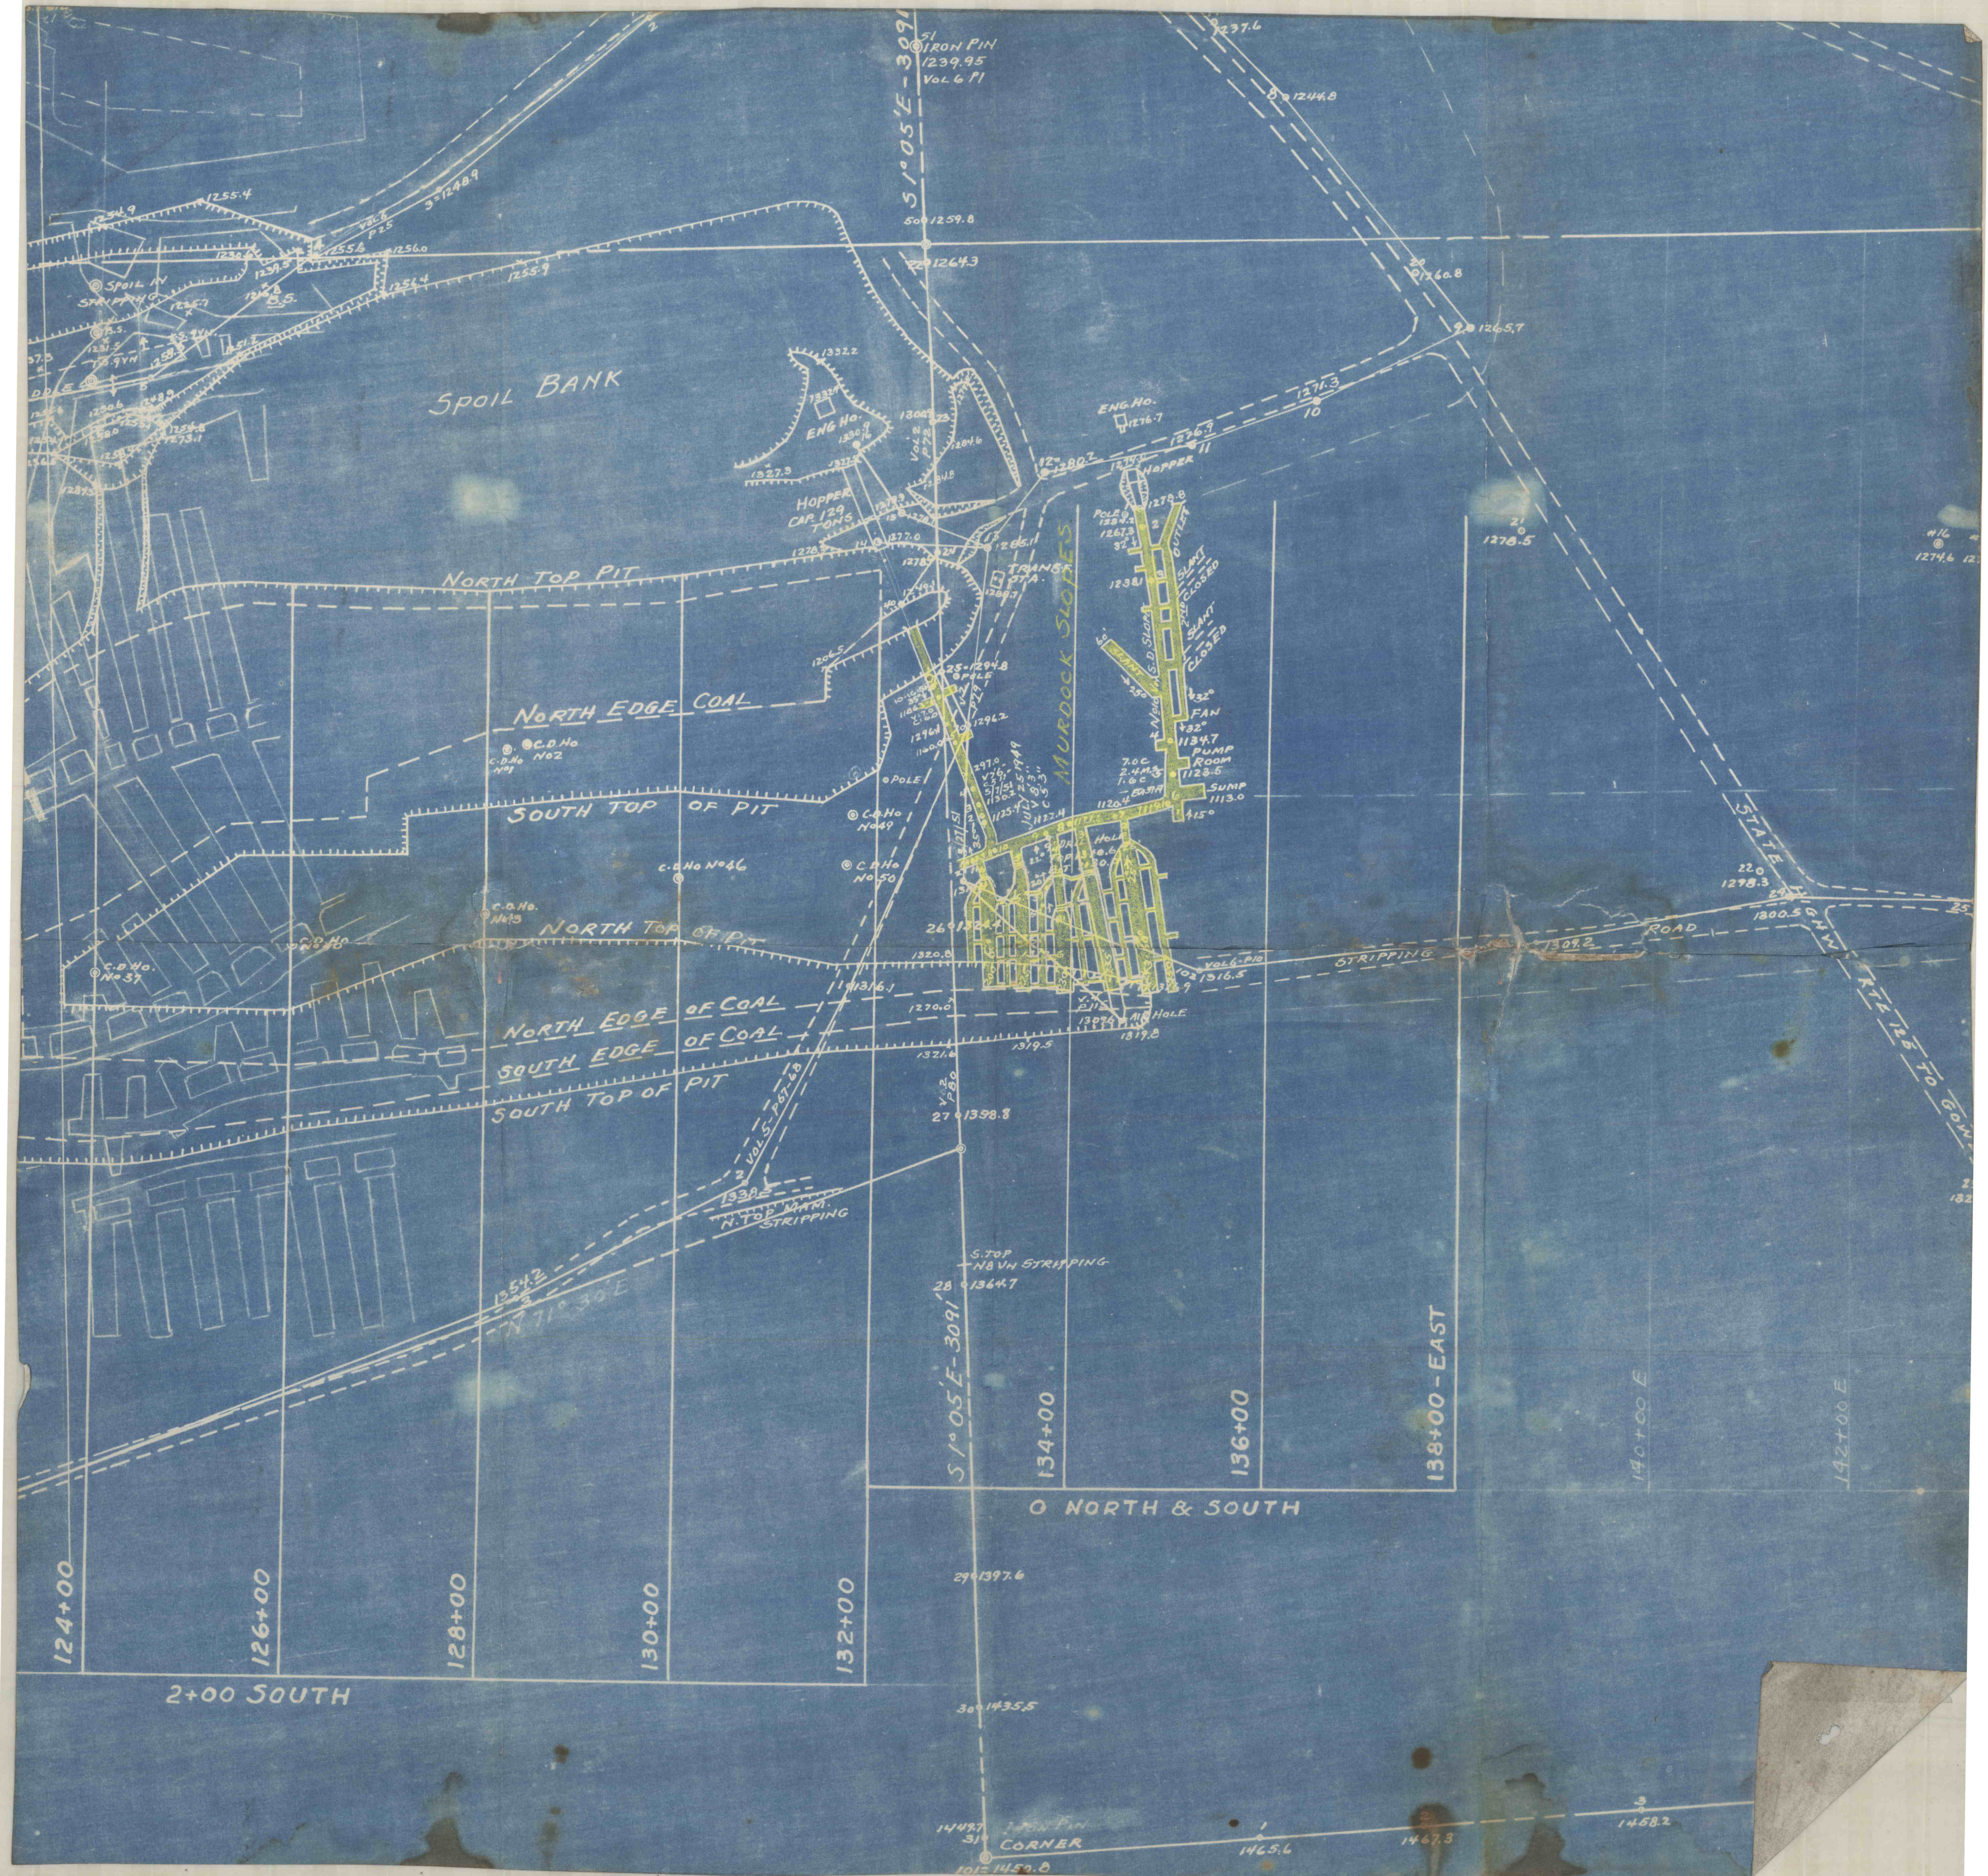

IRON PIN
1239.95
Vol. 6 P1

SPOIL BANK

NORTH TOP PIT

NORTH EDGE COAL

SOUTH TOP OF PIT

NORTH TOP OF PIT

NORTH EDGE OF COAL

SOUTH EDGE OF COAL

SOUTH TOP OF PIT

MURDOCK SLOPES

STATE ROAD

STRIPPING

S. TOP N. 8 V. N. STRIPPING

134+00

136+00

138+00 - EAST

140+00 E

142+00 E

0 NORTH & SOUTH

124+00

126+00

128+00

130+00

132+00

2+00 SOUTH

CORNER

1465.6

1467.3

1458.2