


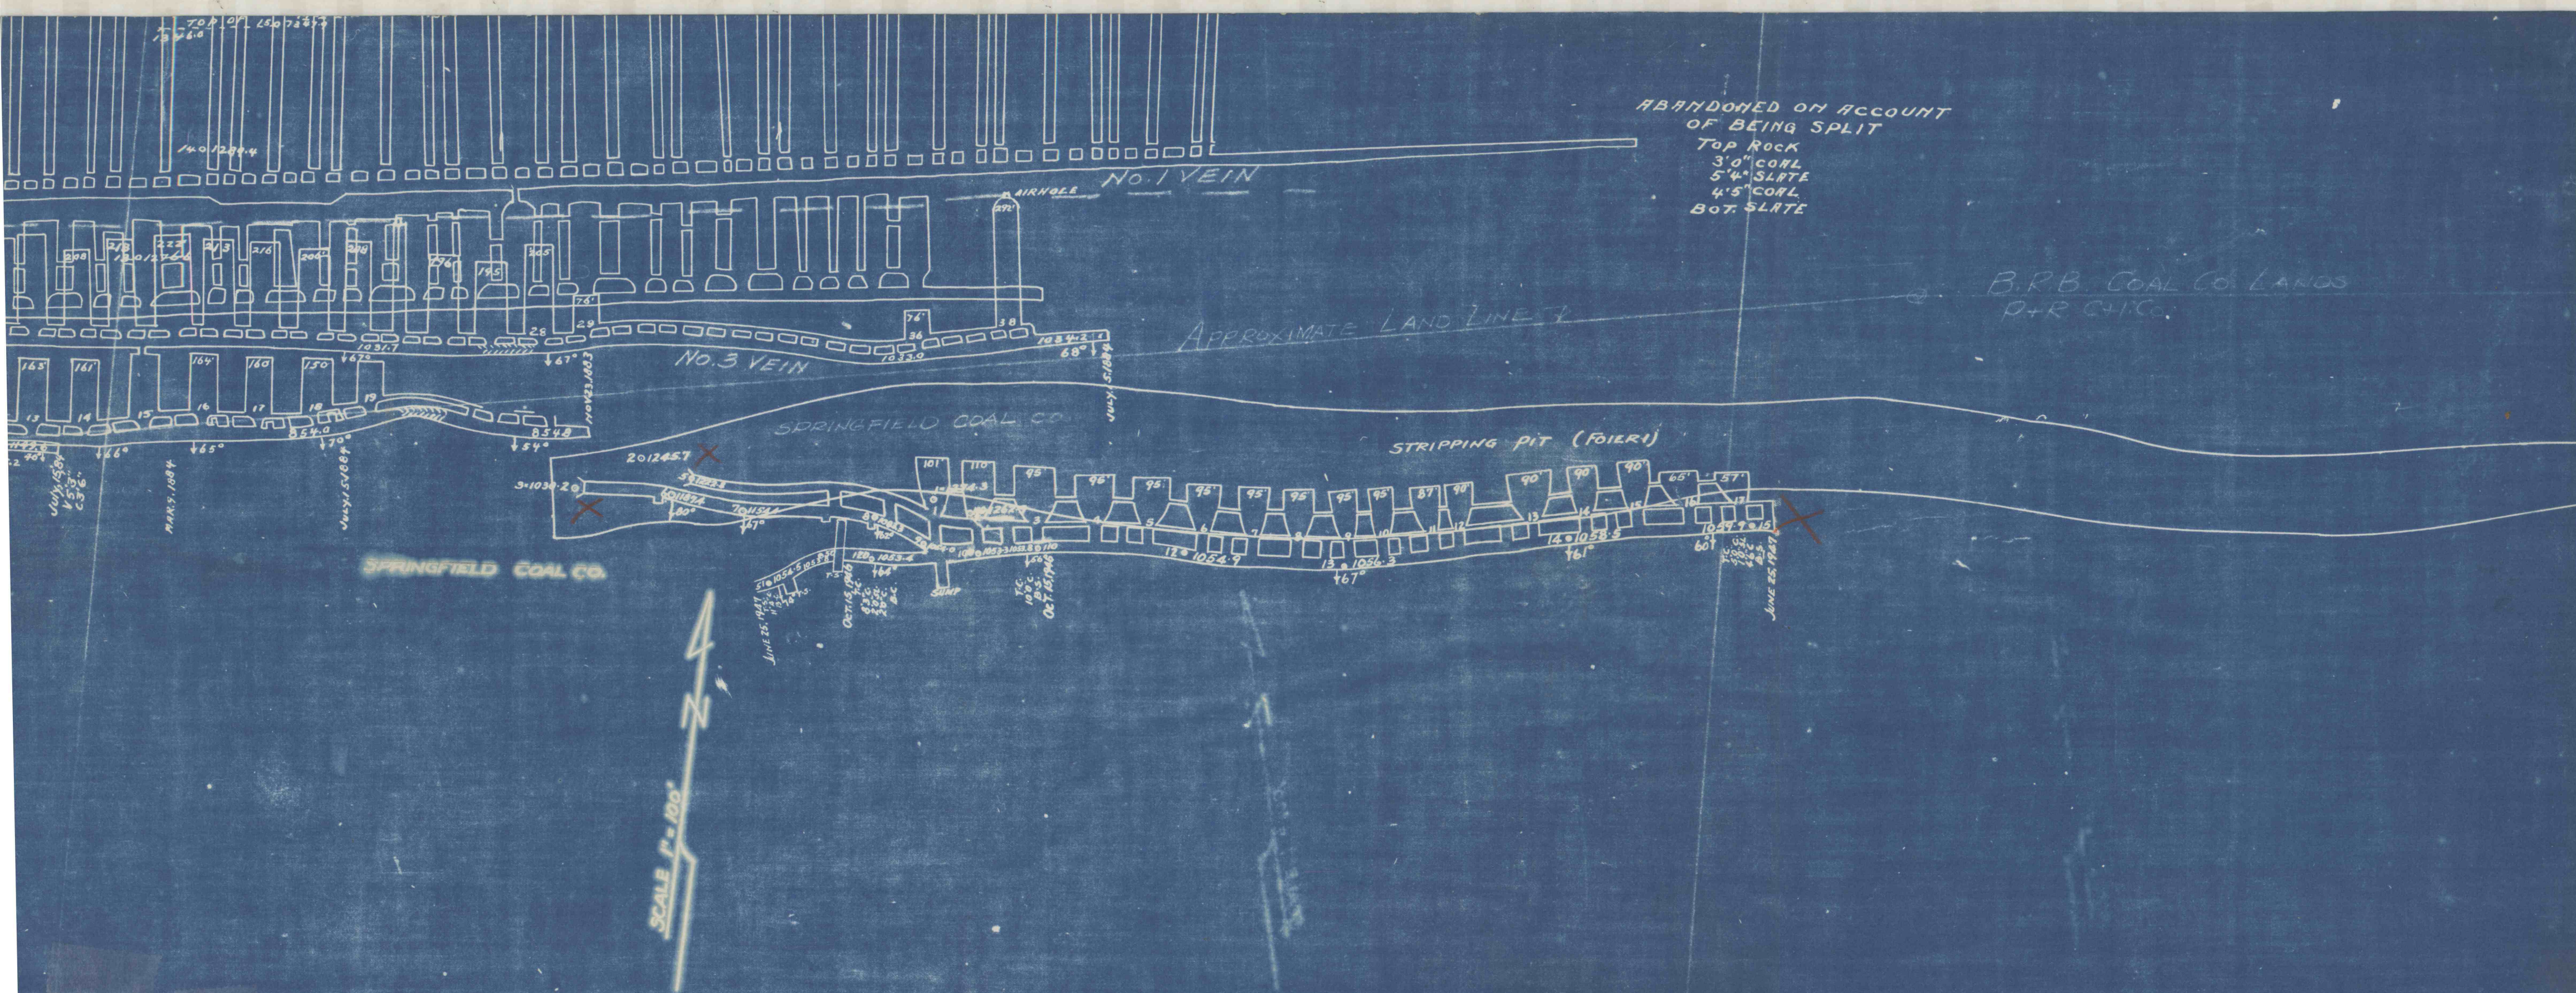

NORTH FRANKLIN COLLIERY
 Print Showing Springfield Coal Co.
 Workings

Scale 1"=100'
 Oct 15, 1947

Office of Div. Engr.
 Ashland, Pa.