


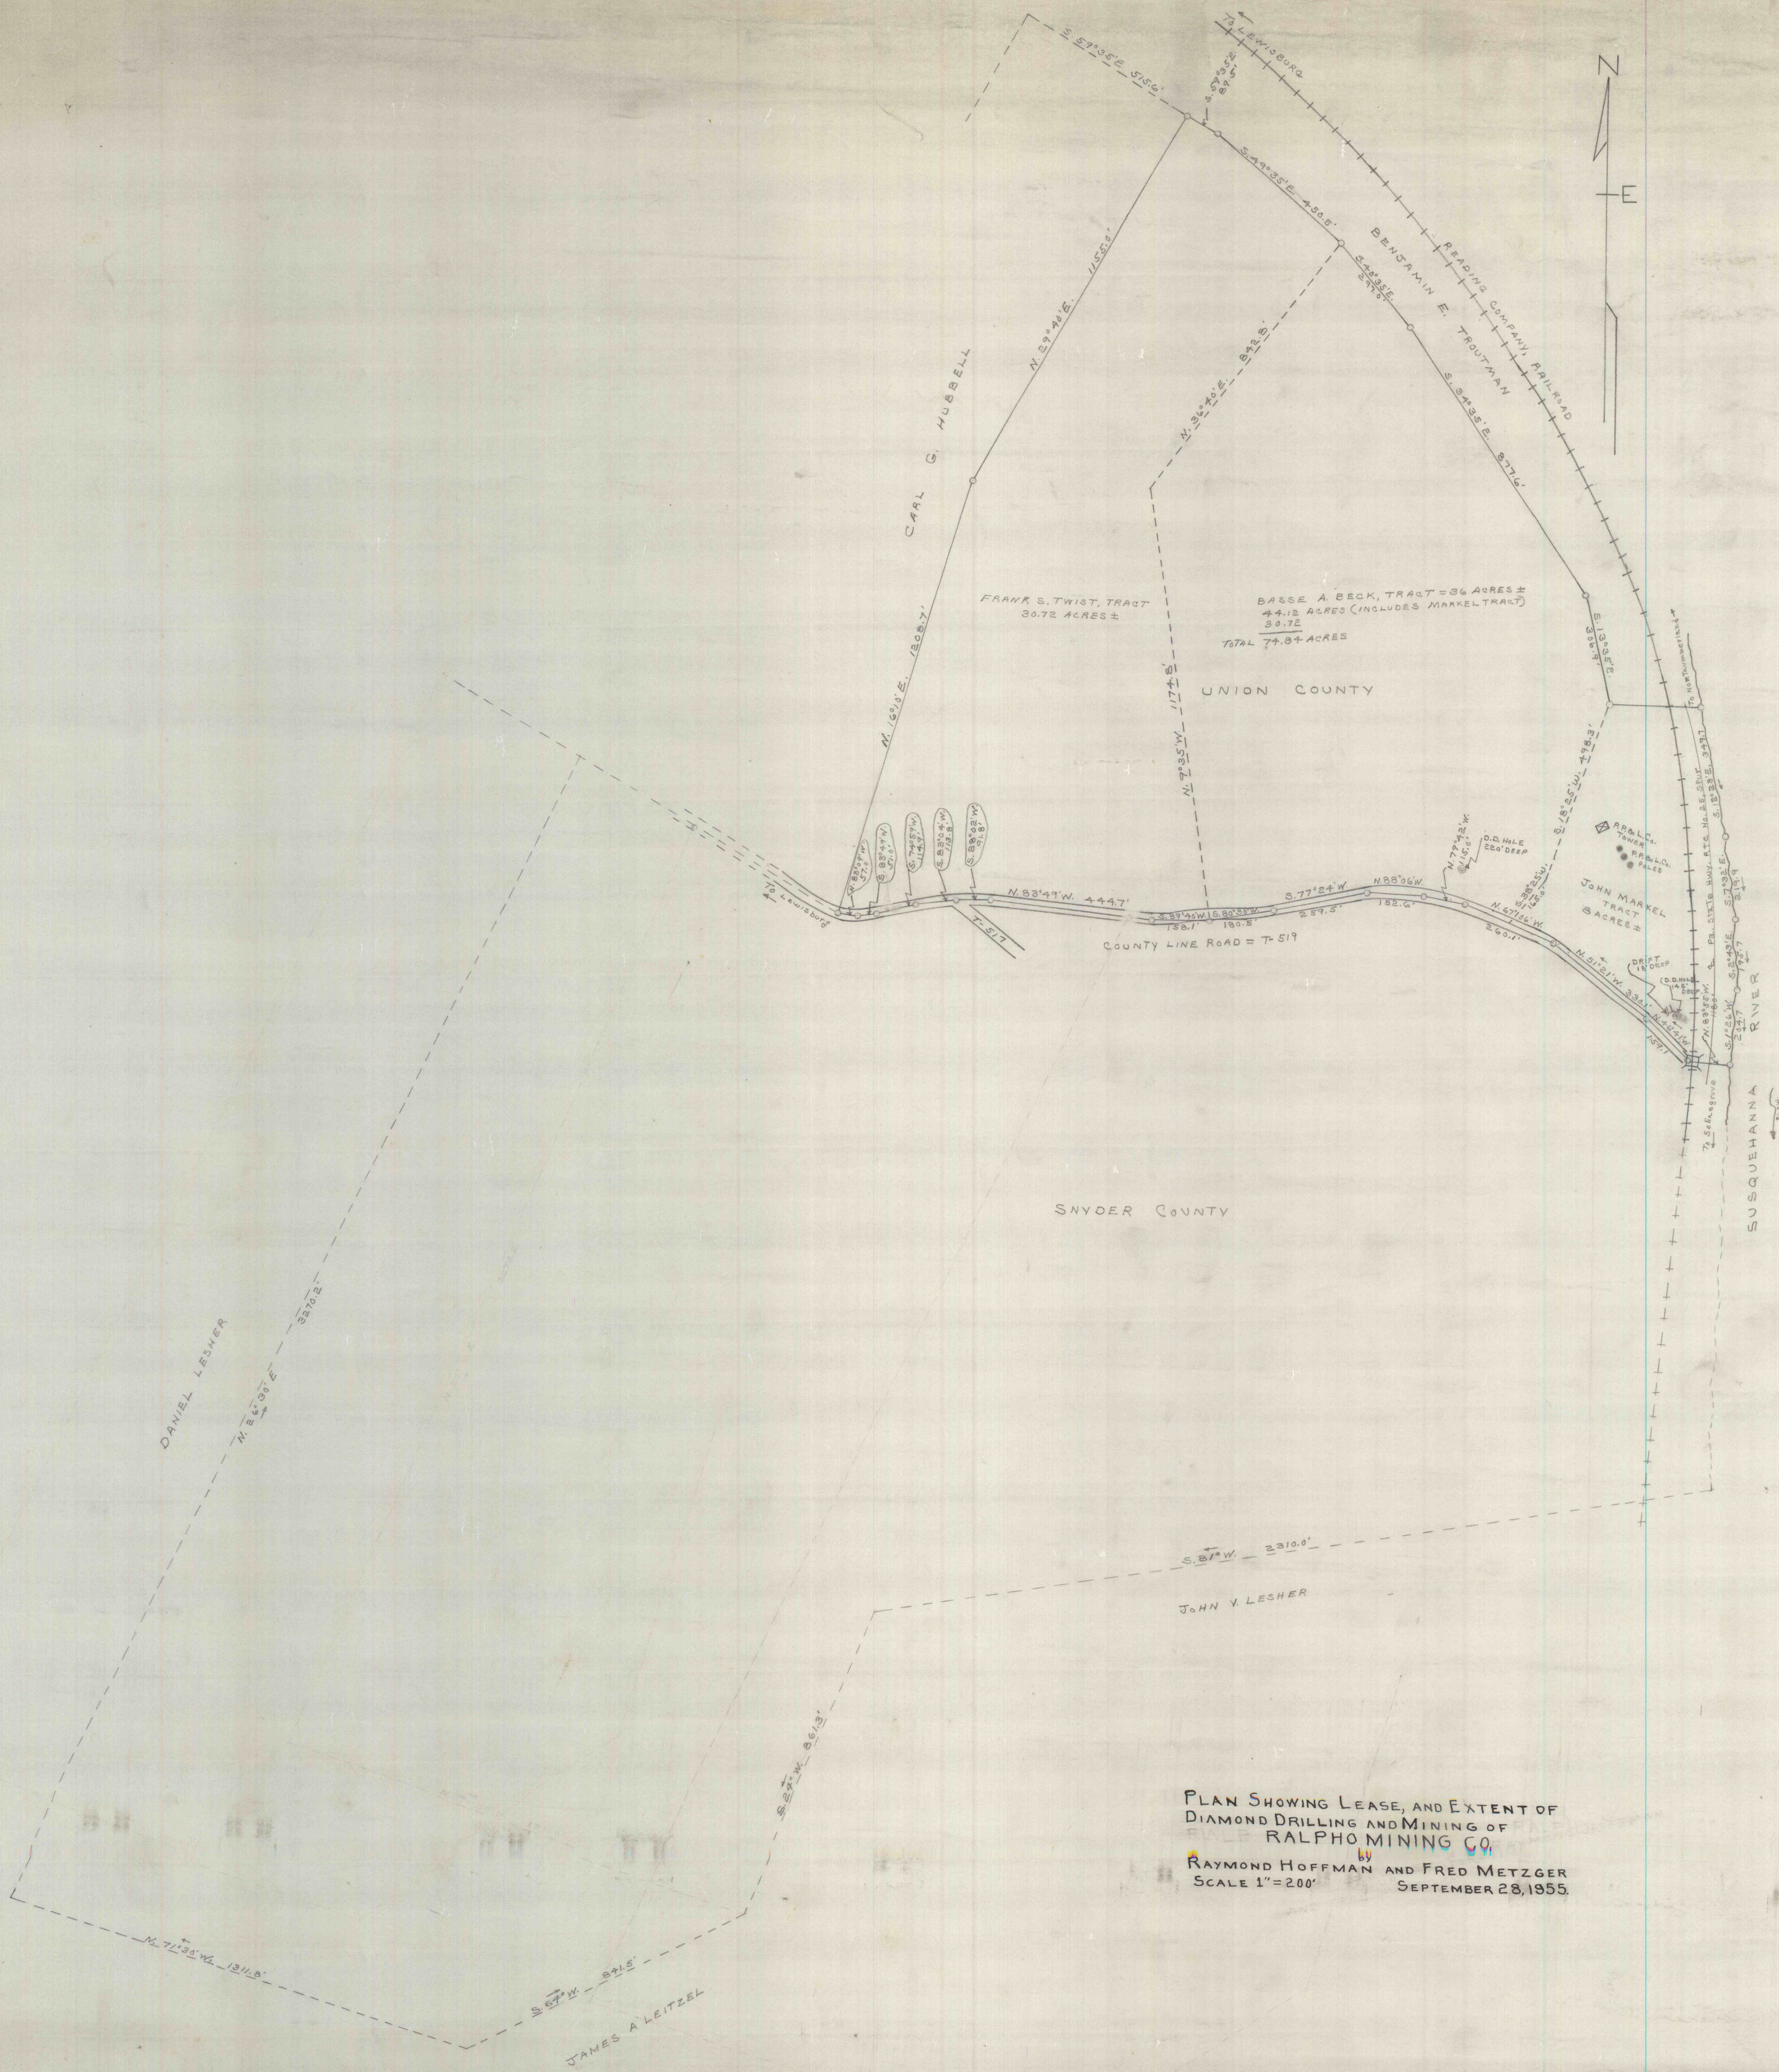

PLAN SHOWING LEASE, AND EXTENT OF
DIAMOND DRILLING AND MINING OF
RALPHO MINING CO.
RAYMOND HOFFMAN AND FRED METZGER
SCALE 1"=200' SEPTEMBER 28, 1955.