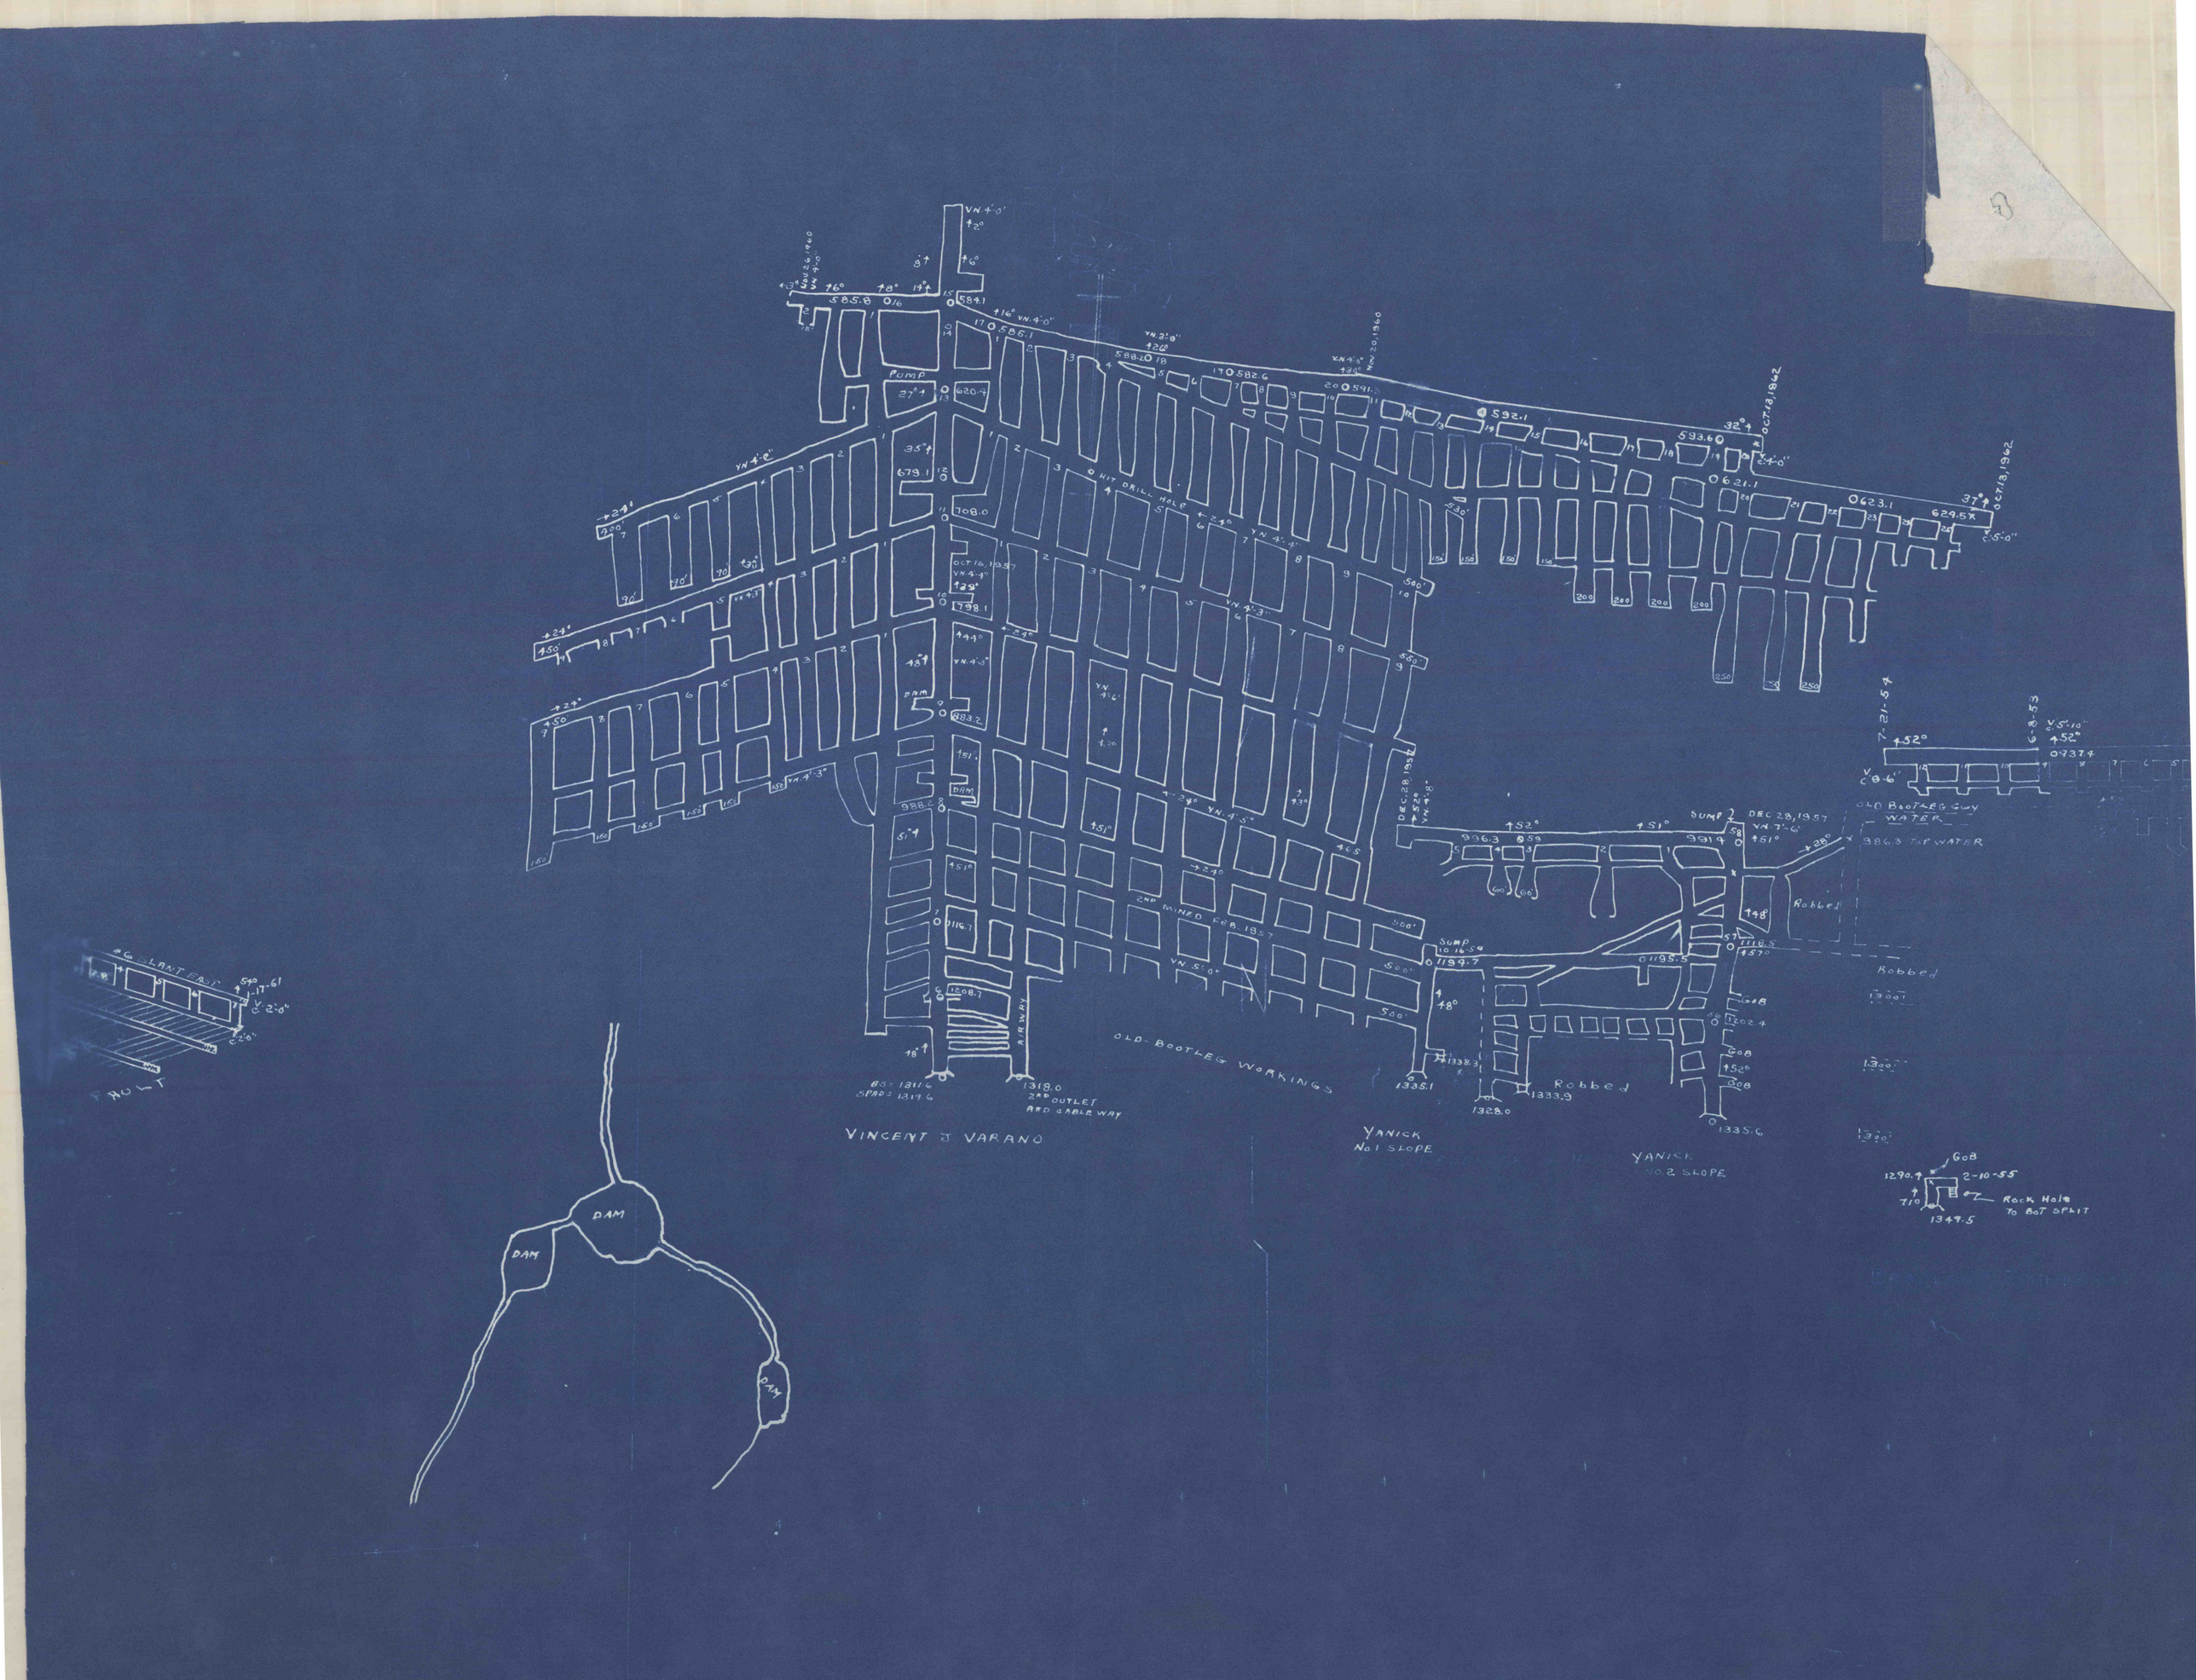
PUMP
HIT DRILL HOLE
OCT 16, 1957
DAM
2ND MINED FEB. 1957
AIRWAY
OLD BOOTLEG WORKINGS
BS: 1311.6
SPRD: 1317.6
1318.0
2ND OUTLET
AND CABLE WAY
VINCENT J VARANO
YANICK
No 1 SLOPE
YANICK
No 2 SLOPE
Robbed
SUMP 2
DEC 28, 1957
OLD BOOTLEG WATER
986.3 TOP WATER
OCT 13, 1962
ROLT
DAM
DAM
DAM