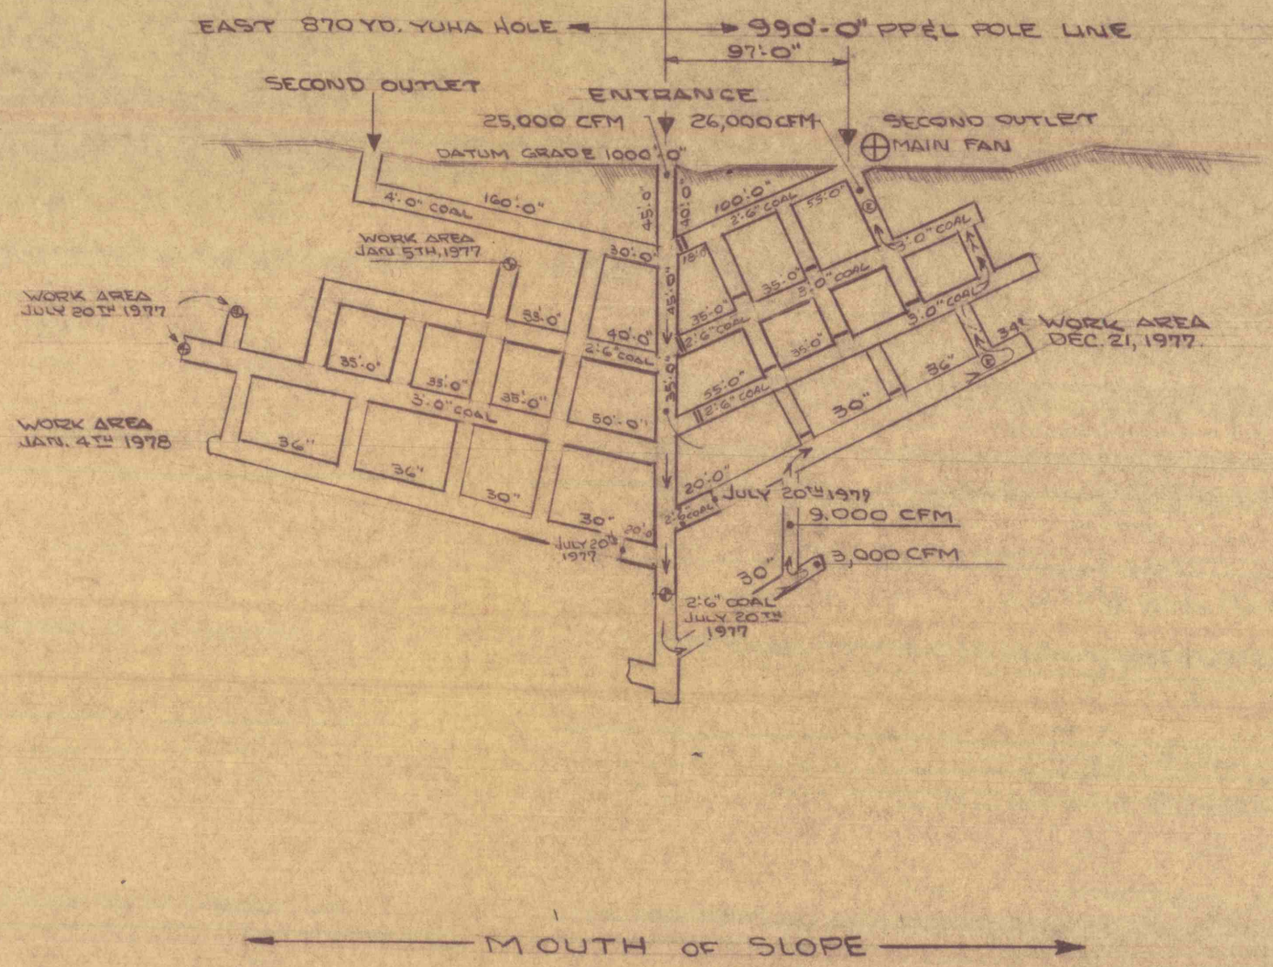

MOUTH OF SLOPE

Nº 1 SLOPE ID 36-0-5906
K.W.Y. COAL CO. EXCELSIOR PA.

9½ VAIN ~ 45° PITCH SCALE 1" = 100'-0"

ORIGINAL JAN 5TH 1977
REVISED JULY 20TH 1977
REVISED FEB 2ND 1978

COMMONWEALTH OF PENNSYLVANIA
REGISTERED PROFESSIONAL
BARRY E. TRUMBAUER
ENGINEER
NO. 23835-E

Barry E Trumbauer
3/6/78

LEGEND

- ⊕ MAIN FAN
- → INTAKE AIR
- → RETURN AIR
- ═ PERMANENT STOPPING
- — TEMPORARY STOPPING
- - - BRATTICE
- Ⓔ ESCAPE WAY